


MECHANIC TOWNSHIP
 S.E. QTR. SECTION 10
 T-8N R-7W
 HOLMES COUNTY, OHIO

164054

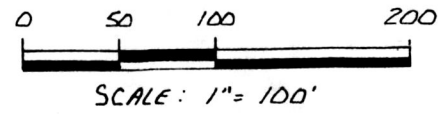

- IRON PIN FOUND
- 5/8" REBAR WITH I.D. CAP SET
I.D. CAP MARKED "BAKER 6938"

REFERENCES:


PLAT VOL. 3 PAGE 93 B
 BEARINGS ON GRANTOR'S NORTH
 LINE FROM PLAT VOL. 7 PAGE 485
 VARIOUS DEEDS AS SHOWN

**SPLIT
 APPROVED
 # 890100**

(0.619 Ac.)

This plat not approved for any use
 that generates wastewater.

Dennis D. Munnay 6/5/89
 Sanitarian Date

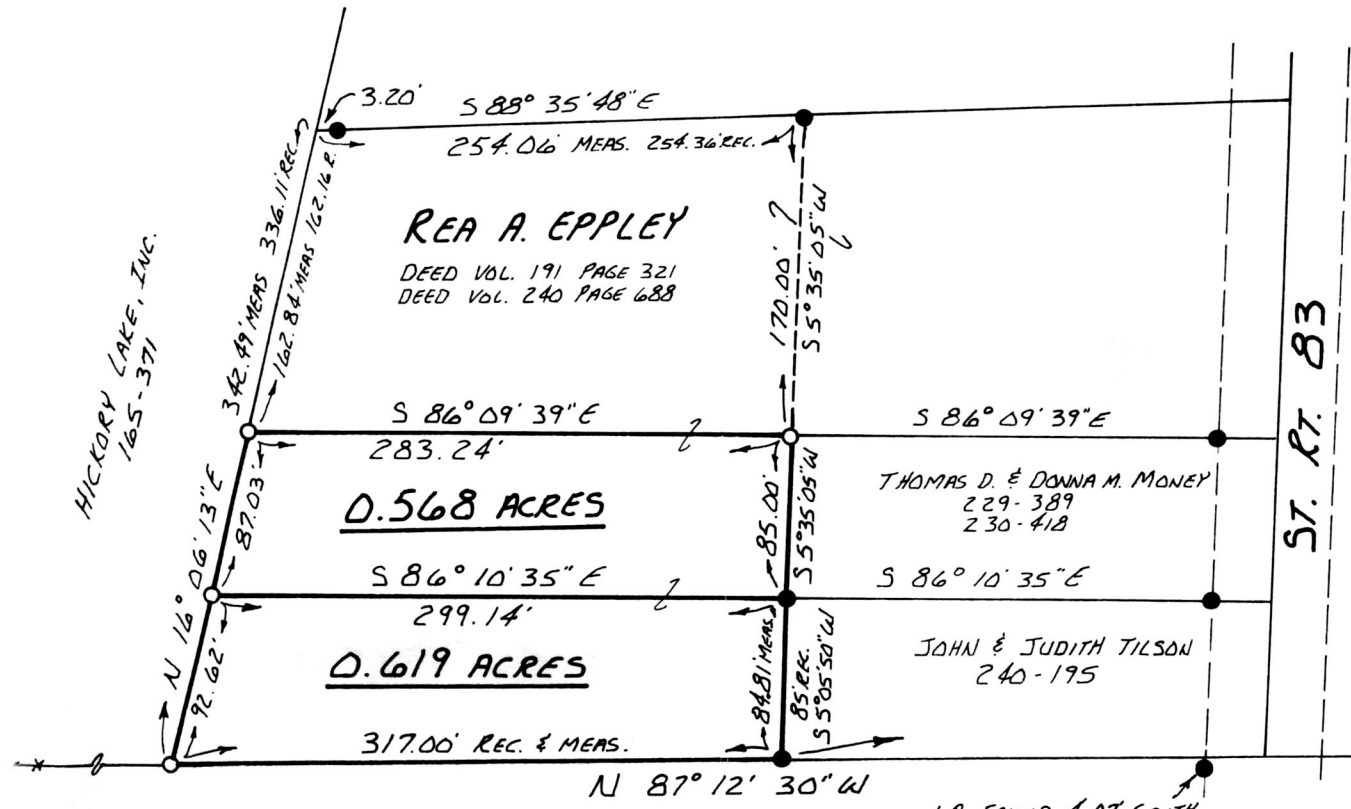

HICKORY LAKE, INC.
 165-371


ST. RT. 83

1586.63' MEAS.
 SECTION LINE
 10
 11

164054

I CERTIFY THIS SURVEY TO BE CORRECT
 TO THE BEST OF MY KNOWLEDGE.

Donald C. Baker
 DONALD C. BAKER P.S. 6938
 4321 T.R. 252
 GLENMONT OH.
 OCT. 26, 1988

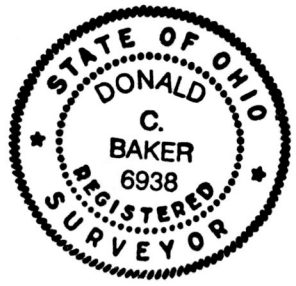

Rec'd: JUN 7 1989 AT 12:08 O'CLOCK PM
 Recorded JUN 8 1989 Holmes Co. Ohio Fee: \$5.00
 Plat Vol. 12 Pg. 229 Recorder Richard Graven
 J. Tilson

Deed Vol. 243 Page 640

23
 LOT
 VOL 12
 PAGE 229