

WASHINGTON TOWNSHIP
 S.W. QTR. SECTION 31 - T-20N; R-15W
 N.W. QTR. SECTION 6 - T-19N; R-15W
 VILLAGE OF LOUDONVILLE
 HOLMES COUNTY, OHIO

165126



CERTIFICATE OF APPROVAL LOUDONVILLE PLANNING COMMISSION

pd: \$5.00

I HEREBY CERTIFY THAT THE ATTACHED PLAT OF PARCELS TO BE SPLIT HAS BEEN APPROVED FOR RECORDING BY THE LOUDONVILLE PLANNING COMMISSION.

DATE Aug 14, 1989


Robert H. Seiler
 CHAIRMAN, LOUDONVILLE PLANNING COMMISSION OR AUTHORIZED REPRESENTATIVE

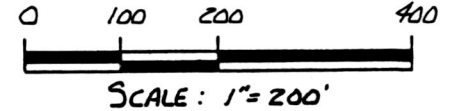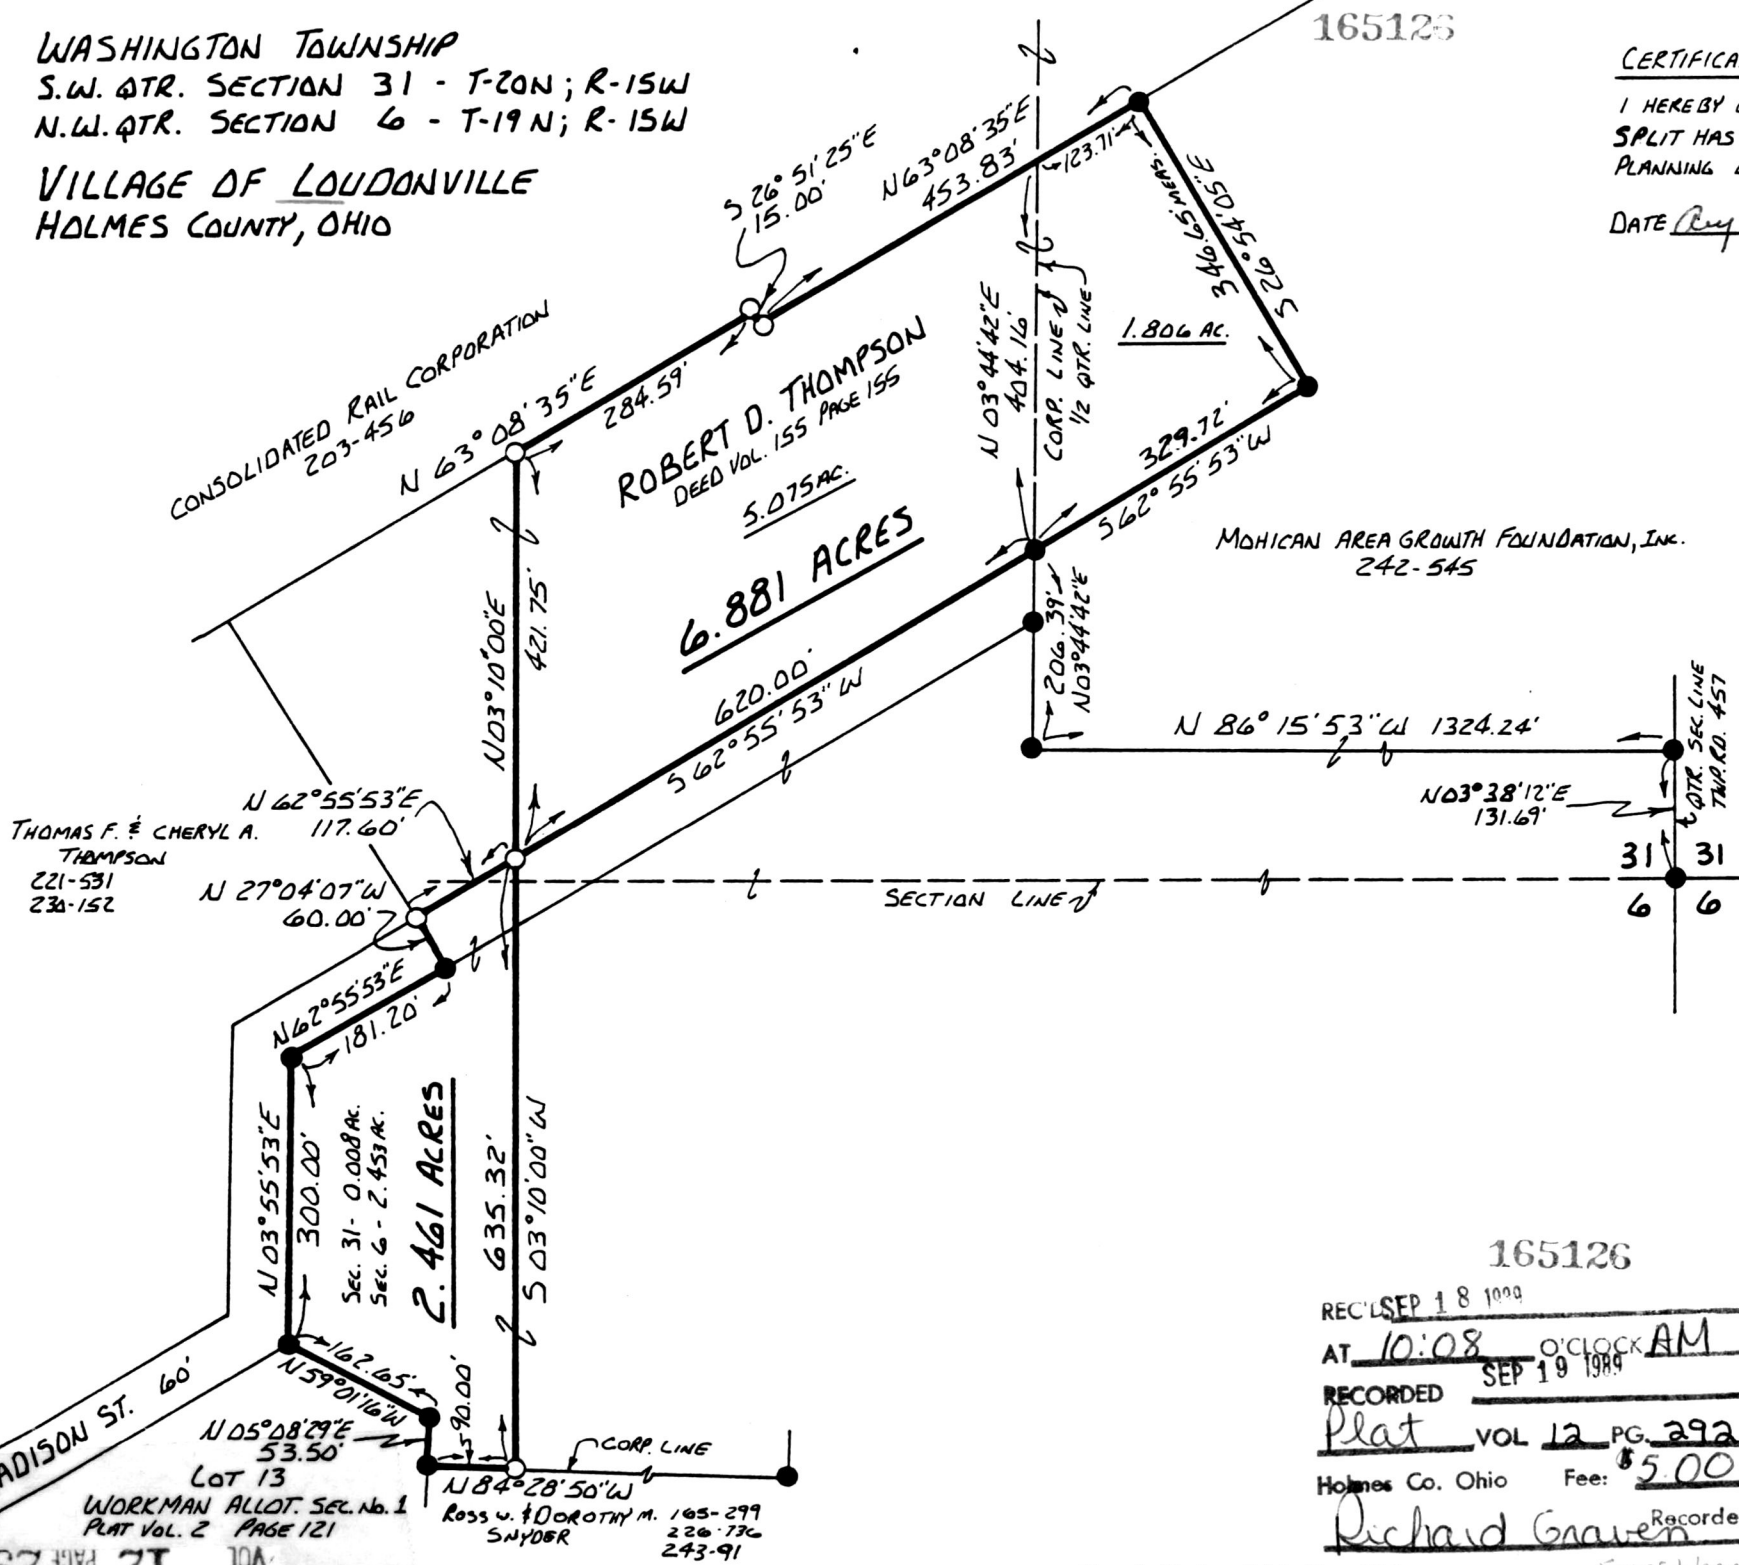

- IRON PIN FOUND
- 5/8" REBAR WITH I.D. CAP SET I.D. CAP MARKED "BAKER 6938"

REFERENCE:

BEARINGS FROM PLAT VOL. 8 PAGE 495
 PLAT VOL. 13 PAGE 57
 PLAT VOL. 13 PAGE 48
 PLAT VOL. 8 PAGE 60

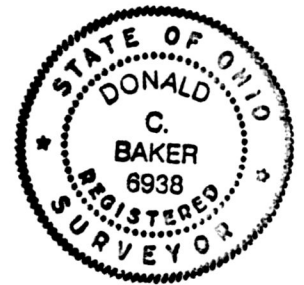

I CERTIFY THIS SURVEY TO BE CORRECT TO THE BEST OF MY KNOWLEDGE.

Donald C. Baker
 DONALD C. BAKER. P.S. 6938
 4321 TR 252
 GLENMOUNT, OH.
 JUNE 15, 1989

165126

REC'D SEP 18 1989
 AT 10:08 o'clock AM
 RECORDED SEP 19 1989
 Plat VOL 12 PG. 292
 Holmes Co. Ohio Fee: \$5.00

Richard Graven Recorder