


WALNUT CREEK TOWNSHIP
 1ST. QTR. LOT 16
 TWP. 9N RANGE 5W
 HOLMES COUNTY, OHIO

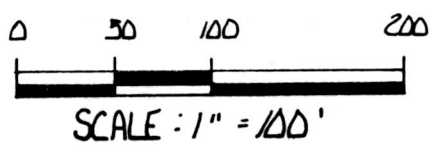


- STONE FOUND
 - △ R.R. SPIKE SET
 - 5/8" RE BAR WITH I.D. CAP SET
- I.D. CAP MARKED "BAKER 6938"

BEARINGS ASSUMED



APR 6 1990
 APR 9 1990
 APR 12 1990
 12:19 O'CLOCK P.M.
 Holmes Co. Ohio Fee: 5.00
 Pg. 402 Recorder: *Robert Blom*
John

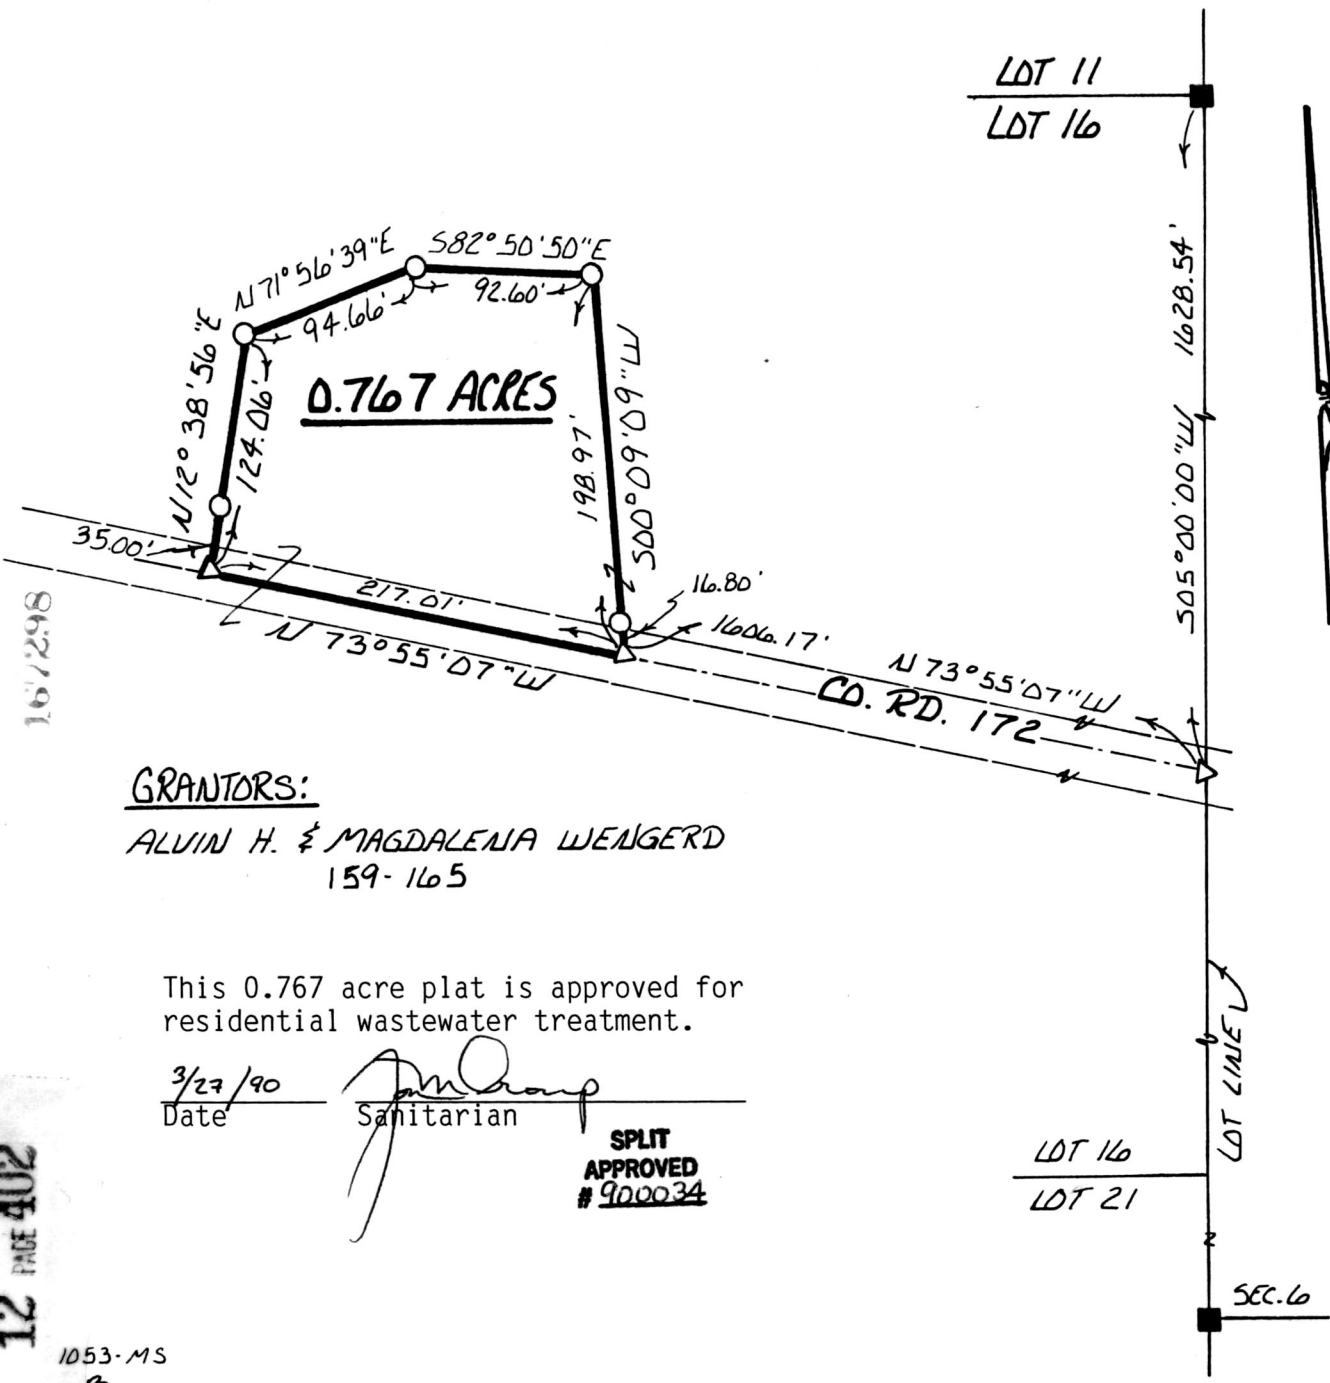

GRANTORS:

ALVIN H. & MAGDALENA WENGERD
 159-165

This 0.767 acre plat is approved for residential wastewater treatment.

3/27/90
 Sanitarian

SPLIT
 APPROVED
 # 900034

I CERTIFY THIS SURVEY TO BE CORRECT
 TO THE BEST OF MY KNOWLEDGE.
Donald C. Baker
 DONALD C. BAKER P.S. 6938
 4321 T.R. 252
 GLENMONT, OHIO

MARCH 8, 1990

PLAT APPROVED
 4/5/90 B

Vol 12 PAGE 402

1053-MS
 B

Deed Vol. 246 Page 742