


RESURVEY
ERVIN & RITA G. FELIX PROPERTY

167964

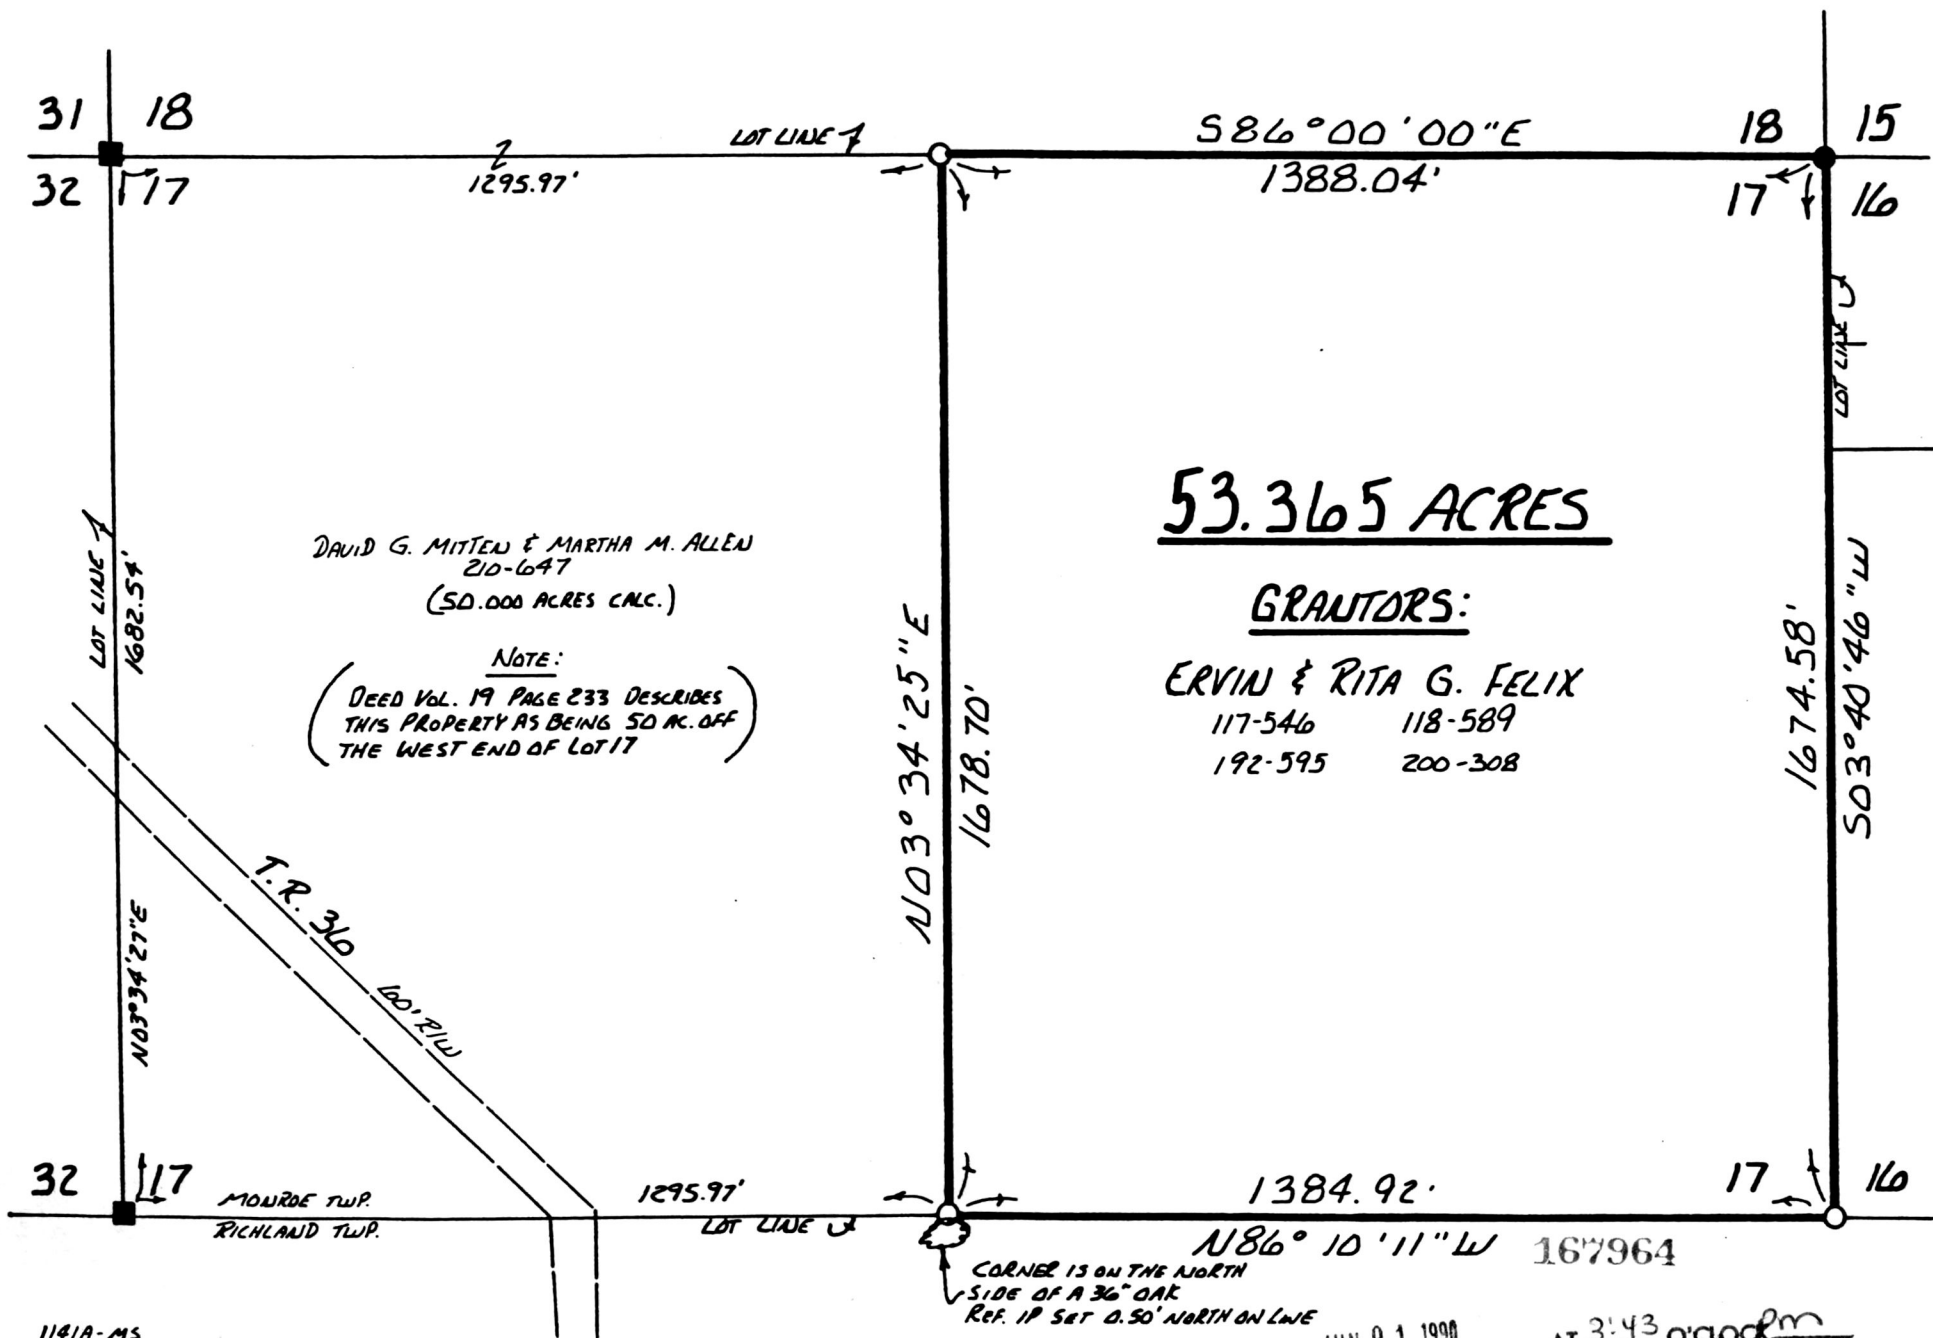

DAVID G. MITTEN & MARTHA M. ALLEN
210-647
(50.000 ACRES CALC.)


NOTE:
(DEED VOL. 19 PAGE 233 DESCRIBES
THIS PROPERTY AS BEING 50 AC. OFF
THE WEST END OF LOT 17)

53.365 ACRES

GRANTORS:

ERVIN & RITA G. FELIX
117-546 118-589
192-595 200-308

MONROE TOWNSHIP
3RD. QTR. LOT 17
TWP. 9N RANGE 8W
HOLMES COUNTY, OHIO

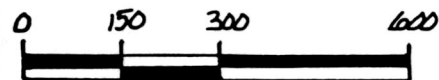

SCALE: 1" = 300'

- STONE FOUND
- IRON PIN FOUND
- 5/8" REBAR WITH I.D. CAP SET
I.D. CAP MARKED "BAKER 6938"

REFERENCE:

PLAT VOL. 8 PAGE 6
DEED VOL. 17 PAGE 233
DEED VOL. 200 PAGE 308
DEED VOL. 210 PAGE 647
BEARINGS ASSUMED



I CERTIFY THIS SURVEY TO BE CORRECT
TO THE BEST OF MY KNOWLEDGE.

Donald C. Baker
DONALD C. BAKER P.S. 6938
4321 T.R. 252
GLENMONT, OHIO

CORNER 13 ON THE NORTH
SIDE OF A 36" OAK
REF. IP SET 0.50' NORTH ON LWE

Rec'd JUN 01 1990

Recorded JUN 04 1990

AT 3:43 o'clock pm

Holmes Co. Ohio Fee: 5.00

Vol. 12

443 Recorder Richard Storen

PLAT APPROVED
6-1-90 RJ

MAY 10, 1990