

HOLMES COUNTY HEALTH DEPARTMENT

APPLICATION FOR APPROVAL OF PRIVATE OR SEMI PUBLIC SEWAGE DISPOSAL SYSTEMS

TO BE COMPLETED AND RETURNED WITH FEE OF \$5.00 FOR PRIVATE DWELLING OF \$10.00 FOR MULTIPLE DWELLING OR OTHER BUILDING.

DATE May 6, 1963

LOCATION OF PROPOSED WORK Weston #39- 1st rd to site - (6349) to  
Trwp 348 - Trwp left on Trwp 351 - 1st place (new home - part)

NAME OF PLAT Hardy Hardy Trwp

NAME OF OWNER Robert Korns

ADDRESS Matz - R.D. #1

NAME OF APPLICANT Engine Mueller

ADDRESS OF APPLICANT Kelchuck


NOTE: LOT SIZE: LENGTH          WIDTH          DUPLEX          SINGLE          NEW          OLD           
NEW INSTALLATION          REPLACEMENT          FARM         

WATER SUPPLY: PUBLIC          LENGTH OF LEACHING LINES           
DRILLED WELL          DRY WELL         

AUTOMATIC WASHER Yes GARBAGE DISPOSAL No SIZE OF S. TANK 750

PLOT PLAN

PROPERTY LINE

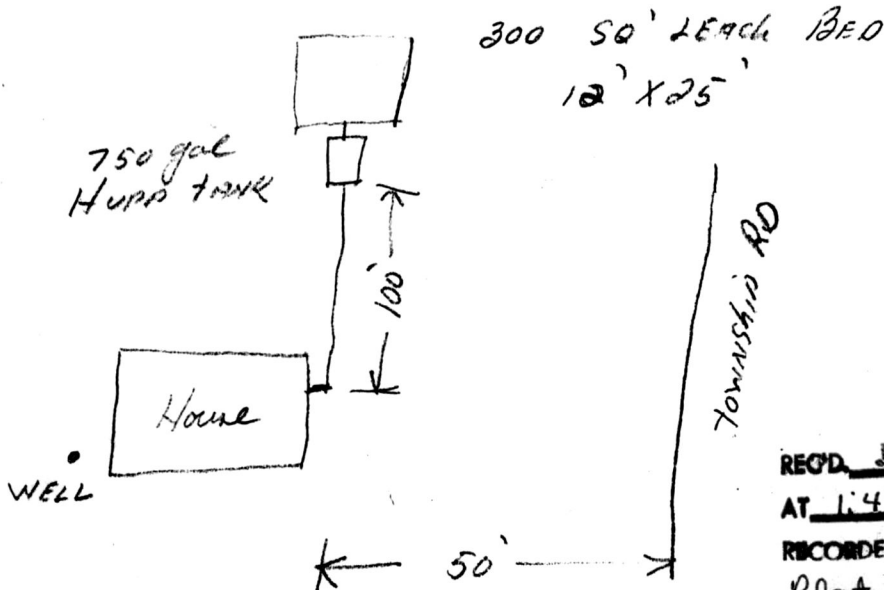

OK  
5-6-63

168024

REC'D JUN 8 7 1960

AT 1:47 O'CLOCK PM

RECORDED JUN 08 1960

Plat VOL 12 PG 449, 450, 451

Holmes Co. Ohio Fee 20.00 + 452

Richard Yensen Recorder  
Steve

PROPERTY LINE

ROAD GUTTER

ROAD