

RESURVEY OF DEED VOL. 206 PAGE 415. <sup>pg. 5.00</sup>

MONROE TOWNSHIP  
1ST. QTR. LOT 5  
TWP. 9N RANGE 8W  
HOLMES COUNTY, OHIO



SCALE: 1" = 300'

- STAKE FOUND
- IRON PIN FOUND
- 5/8" REBAR WITH I.D. CAP SET  
I.D. CAP MARKED "BAKER 6938"


REFERENCES:

DEED VOL. 206 PAGE 415  
 DEED VOL. 216 PAGE 439  
 SURVEY BY R. RUDOLPH DATED 2-16-84  
 BEARINGS FROM PLAT VOL. 8 PAGE 777



I CERTIFY THIS SURVEY TO BE CORRECT TO THE BEST OF MY KNOWLEDGE.

Donald C. Baker  
 DONALD C. BAKER P.S. 6938  
 4321 T.R. 252  
 GLENMONT, OHIO

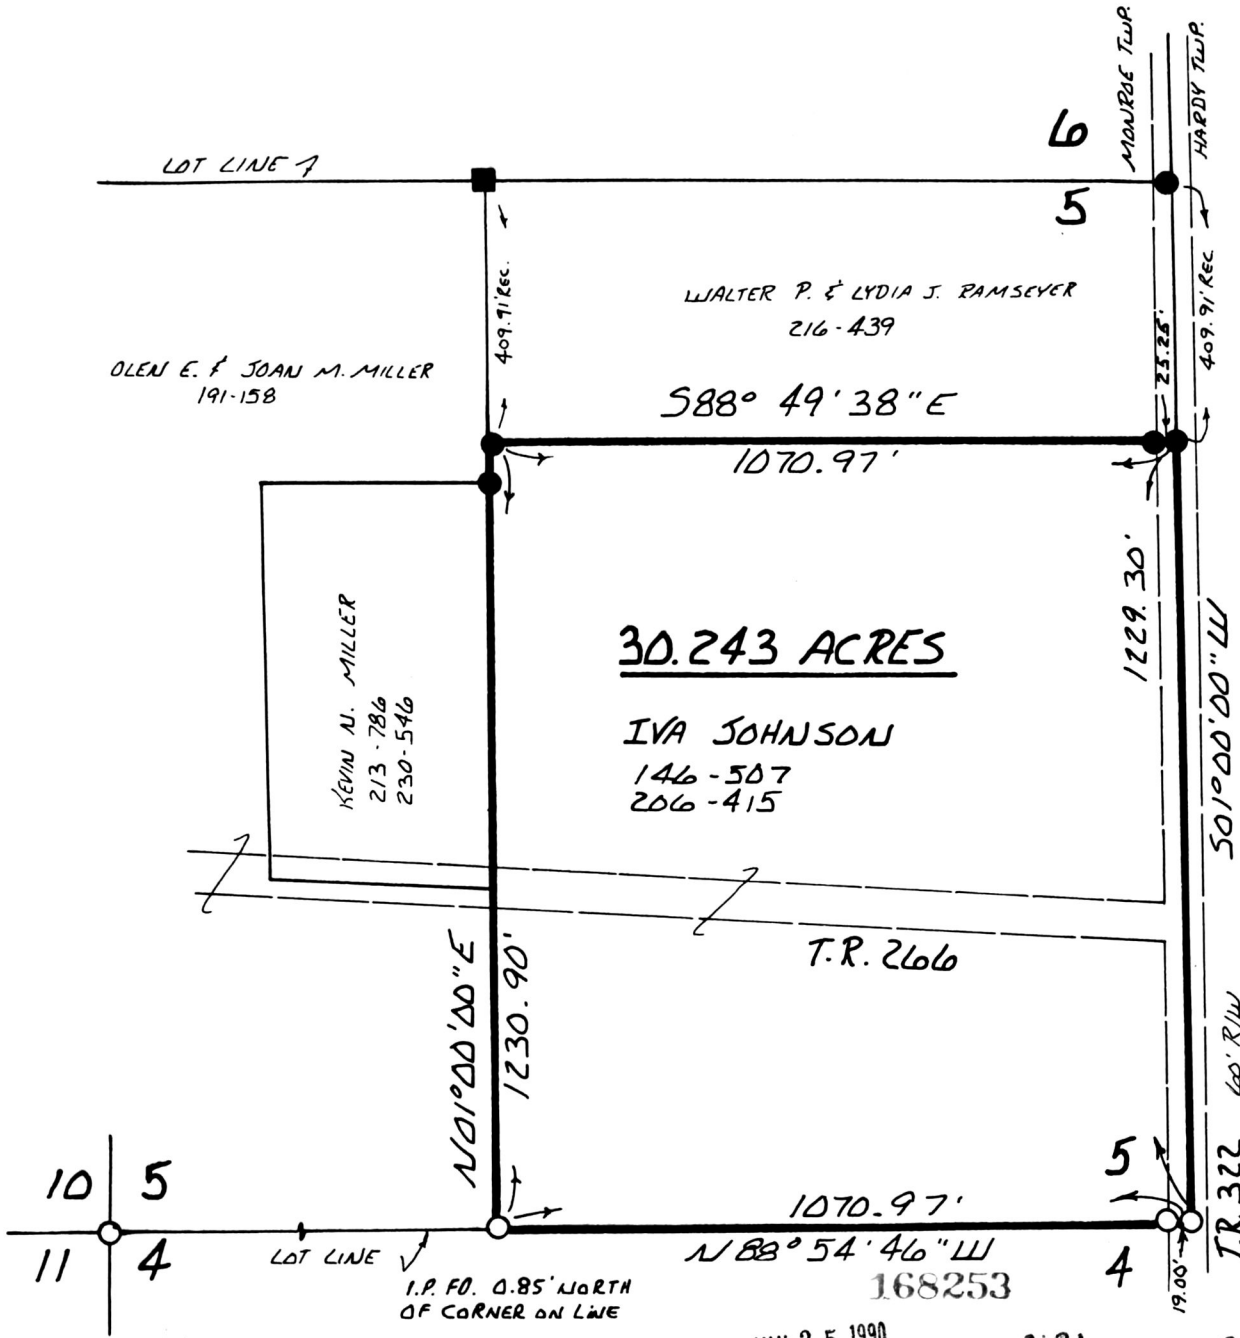

Rec'd JUN 25 1990 AT 3:31 O'CLOCK PM  
 Recorded JUN 26 1990 Holmes Co. Ohio Fee: \$5.00  
 Plat Vol. 12 Pg. 463 Recorder Richard Groves  
*lauer*

MAY 25, 1990

PLAT APPROVED  
6/21/90 B