

Found a tacked hub, that lined up with an old fence.

(0.9237 Ac.)  
This plat not approved for any use  
that generates wastewater. 9/18/90  
Sanitarian Date

SPLIT  
APPROVED  
# 900162

NORTH  
N1°42'28"E  
1304.07 to  
tucked hub

T.R. 309  
Small Stream  
Old fence  
P.K. Nail set & C.R. 68  
547°46'21"E 101.17'

$\Delta = 66^{\circ}32'30''$   
 $R = 212.21'$   
 $D = 27^{\circ}00'00''$   
 $L = 246.45'$   
 $T = 139.24'$   
 $L.C. = 232.84'514^{\circ}30'06''E$

N.W. 1/4 N.W. 1/4 Sec. 24, T9N, R6W

0.9100 Acres  
part of Vol. 234  
Pg. 589  
Maynard E. Hardin  
Vol. 139 Pg. 131  
Vol. 234 Pg. 589  
C.R. 68

I. Pin set 90.00' (3510)  
57°37'  
587°04'45"E 352.67'  
227.57'

I. Pin set at SW.  
Cnr N.W. 1/4 N.W. 1/4  
Sec. 24, T9N, R6W  
also at N.W. Cnr  
S.W. 1/4 N.W. 1/4 of  
an old circle of  
wire that I be-  
lieve had been  
around a corner  
post.

0.9237 Acre  
Part of  
Vol. 221 Pg. 908

Donald E. Balder  
Vol. 234 Pg. 661


Marvin D. &  
Ruth M. Miller  
Vol. 126 Pg. 538  
Vol. 221 Pg. 908

S.W. 1/4 N.W. 1/4 Sec. 24, T9N, R6W

John C. Buren  
Vol. 232 Pg. 359

$\Delta = 20^{\circ}12'22''$   
 $R = 520.87'$   
 $D = 11^{\circ}00'00''$   
 $L = 183.69'$   
 $T = 92.81'$   
 $L.C. = 182.74'$   
N8°39'58"E

Calculated line  
N13°42'44"E  
806.81'

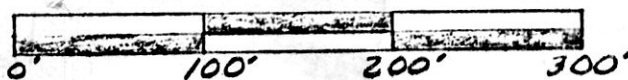

PLAT OF A SURVEY FOR  
MARVIN D. MILLER Et ux  
Known as part of the N.W. 1/4  
and the S.W. 1/4 of the N.W. 1/4  
of Sec. 24, T9N, R6W of  
Hardy Twp., Hol. Co., Ohio.  
Robert L. Kasner P.S. 5193  
P.E. 28820  
517190

N1°26'13"W 100.59'

$\Delta = 7^{\circ}12'57''$   
 $R = 954.93'$   
 $D = 6^{\circ}00'00''$   
 $L = 120.26'$   
 $T = 60.21'$   
 $L.C. = 120.18'$   
N2°10'16"E

N5°46'44"E  
142.66'

N89°39'16"W  
12.73' 152.58'

A stone monument was found broken off and  
old fence cnr laying a few feet Northward  
from the old fence corner

25.94'  
I. Pin set 2

24.36' I. Pipe found  
I. Pipe Fd N.W. cnr 1.006 Acre tract

169380

Rec'd. SEP 24 1990  
Recorded SEP 25 1990  
Plat Vol. 12

AT 2:06 O'CLOCK PM  
Holmes Co. Ohio Fees \$ 9.25  
Pg. 524 Recorder Richard Gavena  
Deed Vol. 248 Page 774



S.W. cnr N.W. 1/4  
Sec. 24, T9N, R6W  
Hardy Twp., Hol. Co., Ohio

S.R. 389, 347  
6/30/1892

Stone mentioned in  
previous work in 1975

I. Pipe in C.R. 68  
N.W. cnr 0.468 Ac. I. Pin

114.00' I. Pipe  
N.E. cnr 1.33 acre tract

PLAT APPROVED  
9/20/90 B