


**RICHLAND TOWNSHIP
S.W. QTR. SECTION 7
T-8N R-9W
HOLMES COUNTY, OHIO**

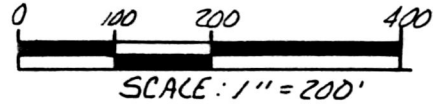

- STONE FOUND
- ▲ R.R. SPIKE FOUND
- IRON PIN FOUND
- 5/8" REBAR WITH I.D. CAP SET
- I.D. CAP MARKED "BAKER 6938"

REFERENCES:

PLAT 4 PAGE 115
PLAT 13 PAGE 49
DEED VOL. 160 PAGE 75
DEED VOL. 247 PAGE 296
BEARINGS FROM PLAT VOL. 13
PAGE 49




I CERTIFY THIS SURVEY TO BE CORRECT
TO THE BEST OF MY KNOWLEDGE.

Donald C. Baker
DONALD C. BAKER P.S. 6938
4321 T.R. 252
GLENMONT, OHIO 44628
DECEMBER 4, 1990
1426-MCS

170494

EUGENE & JUDITH POULY
DALE WILLMAN 247-296

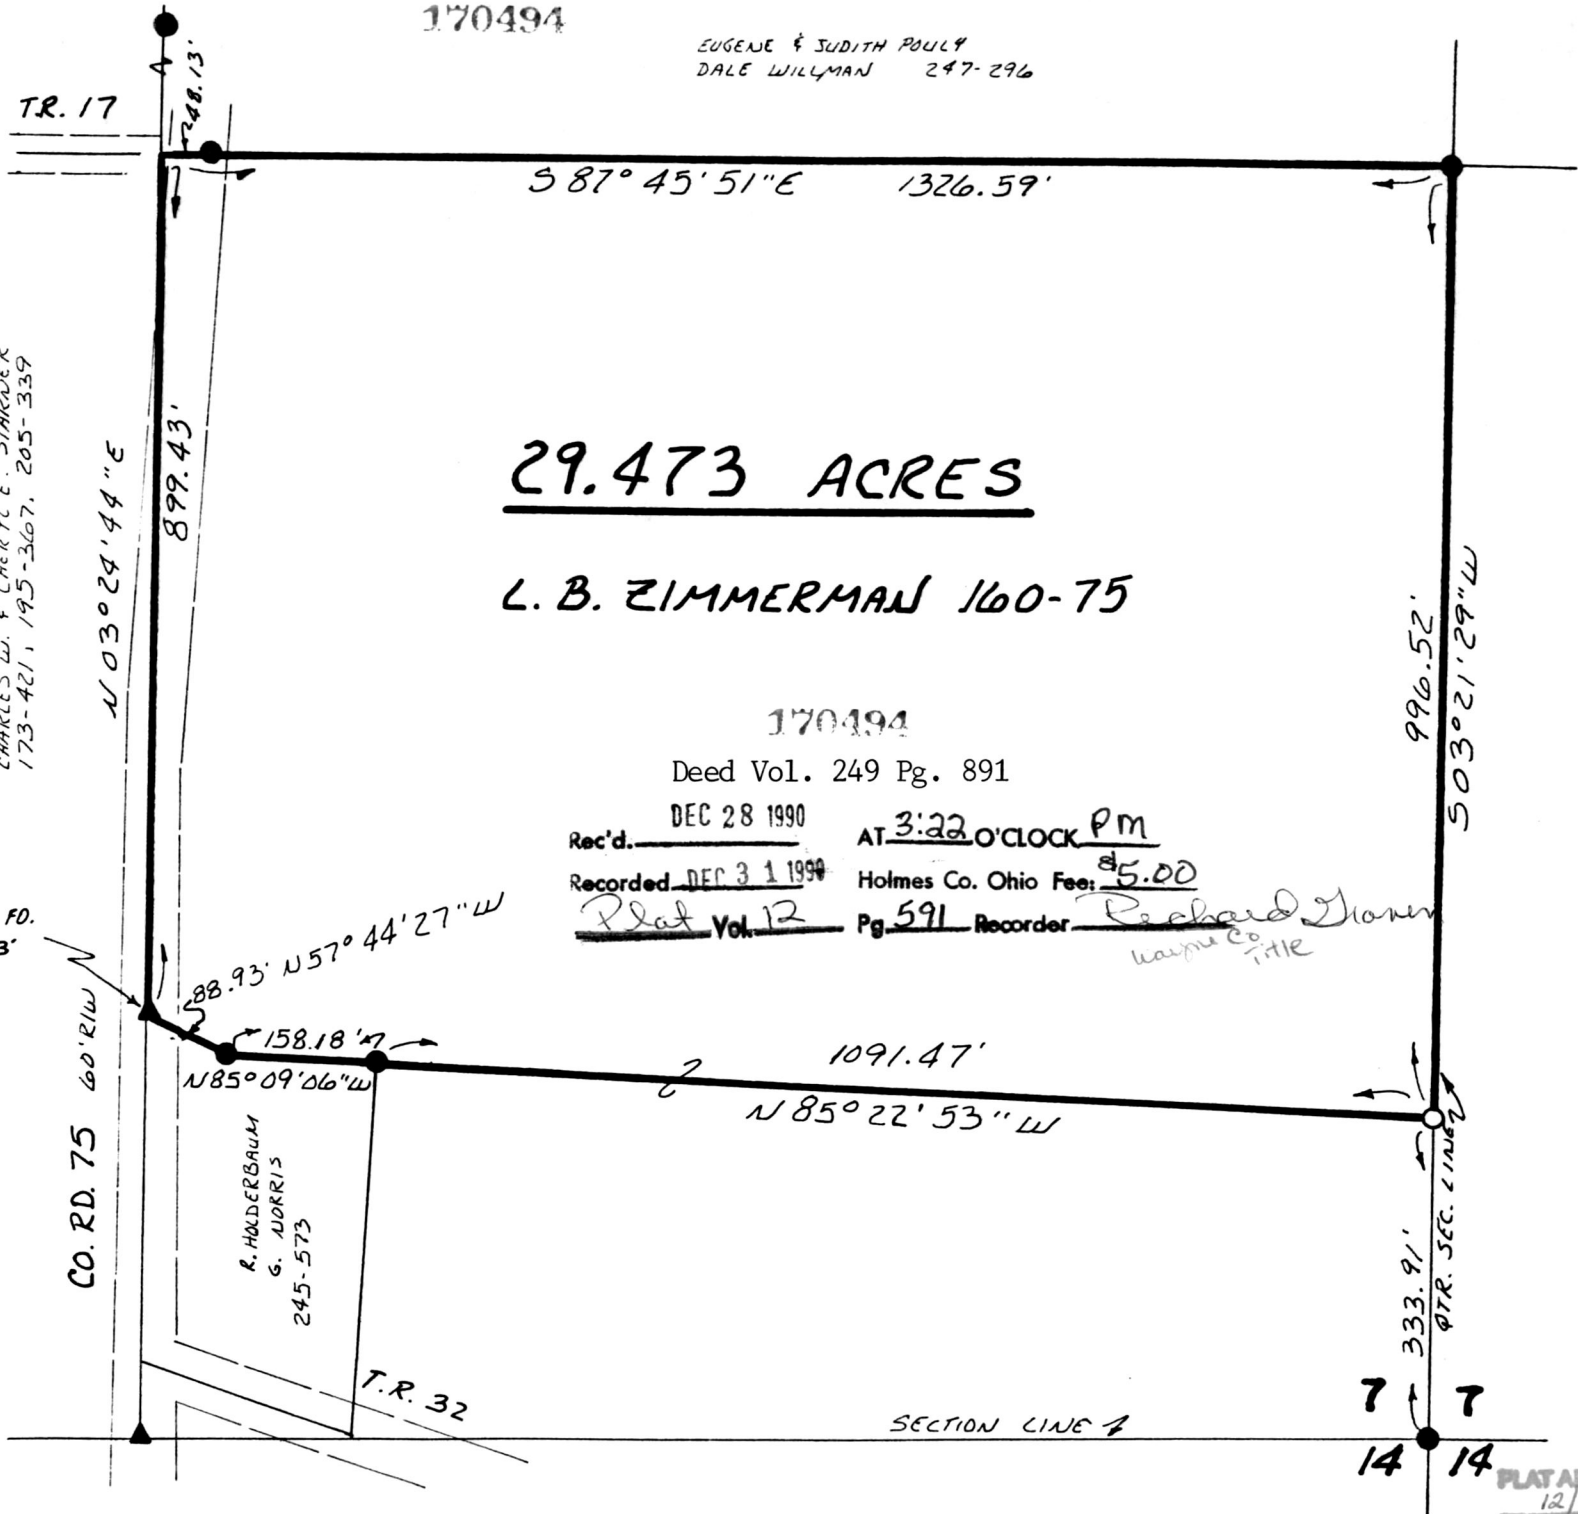

29.473 ACRES

L. B. ZIMMERMAN 160-75

170494

Deed Vol. 249 Pg. 891

DEC 28 1990

AT 3:22 O'CLOCK PM

Recorded DEC 31 1990

Holmes Co. Ohio Fee: \$5.00

Plat Vol. 12

Pg. 591

Recorder Richard Jones
Warner Co. Title

REF. IR. FD.
S57°44'27"E 23.63'
FROM CORNER

CHARLES W. F. CHERYL E. STARNER
173-421, 195-367, 205-339

R. HOLDERBAUM
& G. MORRIS
245-573

VOL 12 PAGE 591

PLAT APPROVED
12/28/90 B