

177698

L VOL 12 PAGE 979 PL. 50

CLARK TOWNSHIP  
S.W. QTR. SECTION 5  
T-8N; R-5W  
HOLMES COUNTY, OHIO



- IRON PIN FOUND
- 5/8" RE BAR WITH I.D. CAP SET
- I.D. CAP MARKED "BAKER 6938"



This 1.201 acre parcel is approved for residential wastewater treatment.

*[Signature]* 7/2/92  
 Sanitarian Date

**SPLIT APPROVED**  
# 920129

REFERENCES:

- PLAT VOL. 5 PAGE 33
- PLAT VOL. 4 PAGE 21
- PLAT VOL. 5 PAGE 92
- DEED VOL. 178 PAGE 85

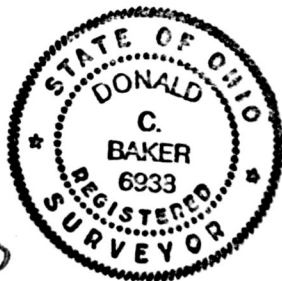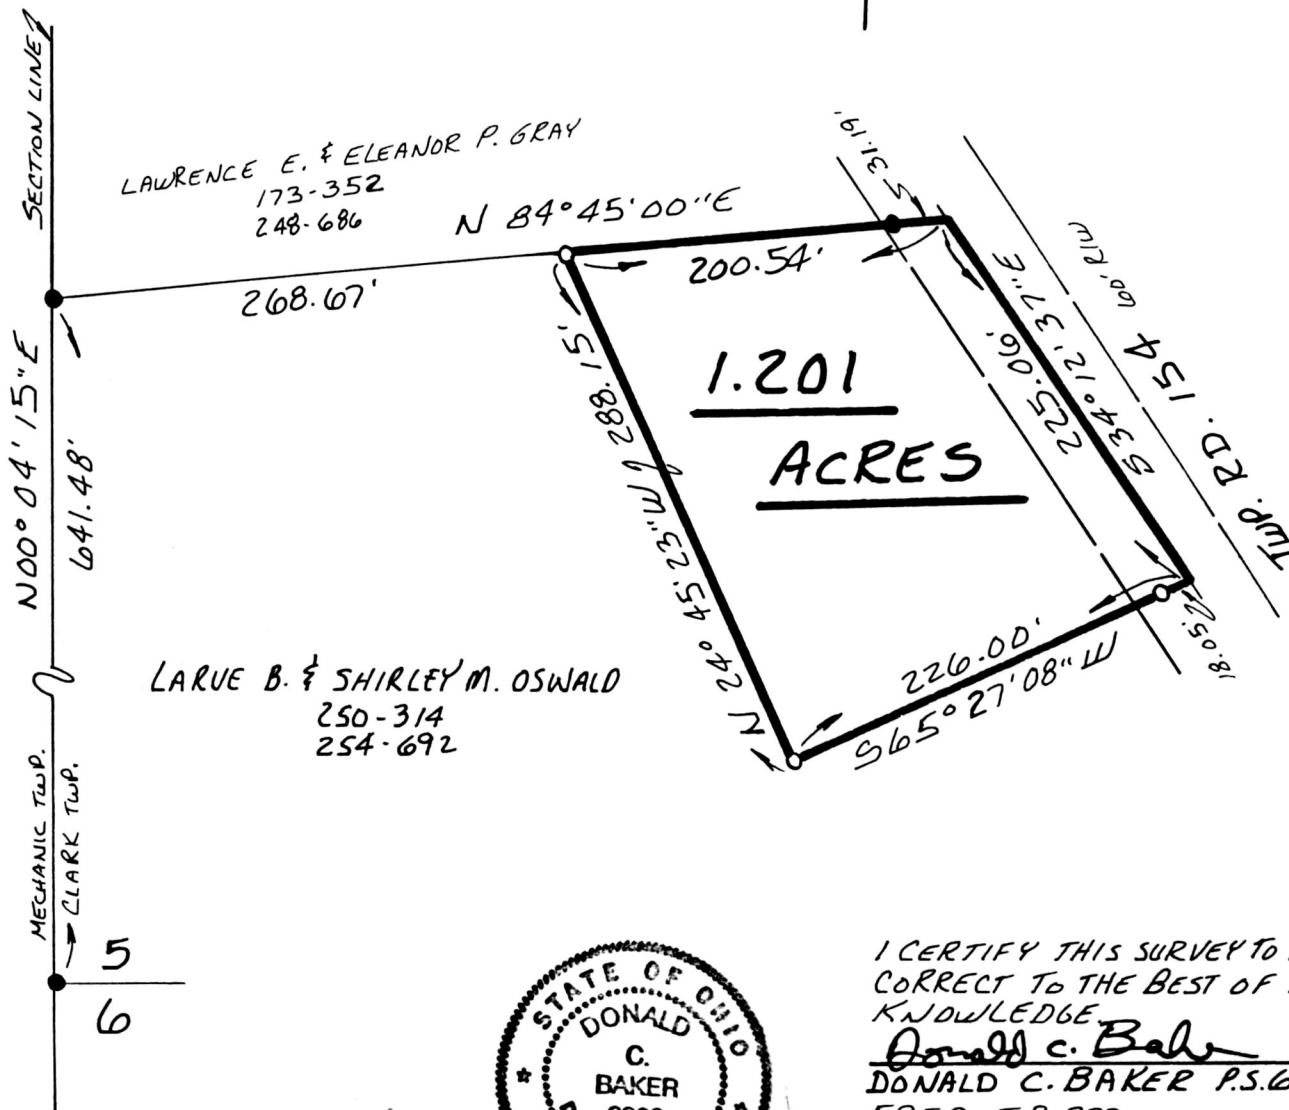

I CERTIFY THIS SURVEY TO BE CORRECT TO THE BEST OF MY KNOWLEDGE.

*Donald C. Baker*  
 DONALD C. BAKER P.S. 6938  
 5958 T.R. 322  
 MILLERSBURG, OHIO 44654  
 PH. (216) 679-4788  
 MAY 28 1992

177698 INDEXED

rec'd. JUL 08 1992

AT 4:07 O'CLOCK pm

Recorded JUL 07 1992

Holmes Co. Ohio Fee: 5<sup>00</sup>

Plat Vol. 12 Pg. 979 Recorder *Mary Ellen Signst*

DEED VOL 250-114

21792-MLS

PLAT APPROVED  
7/6/92