

concrete Monument referred to in P.B. 9 Pg. 211 as being S87°03'38"E 405.07' and N36°24'33"E 1,758.99' from the S.W. corner of the S.E. 1/4 of Frac' 1 Sec. 11, T9N, R7W, of Hardy Twp., Hol. Co., Ohio.

John E. & Elaine C. Hocking Vol. 177 Pg. 636

513°35'27"W 264.00' Rec'd
513°36'42"W 264.97' Observed

560°34'33"E Held 582.12' Rec'd. 582.28' Observed
50' Road R/W

N70°35'27"E 91.08' Rec'd
N70°26'44"E 91.45' Observed


I. Pin Set
 $\Delta = 67^{\circ}43'00''$
 $R = 75.00'$
 $D = 76^{\circ}23'40''$
 $L = 88.64'$
 $T = 50.32'$
 $LC = 526^{\circ}33'03''E$
83.57'

I. Pin Set
 $\Delta = 61^{\circ}35'00''$
 $R = 75.00'$
 $D = 76^{\circ}23'40''$
 $L = 80.61'$
 $T = 44.69'$
 $LC = N88^{\circ}41'57''E$
76.79'

I. Pin Set
 $\Delta = 18^{\circ}07'40''$
 $R = 125.00'$
 $D = 45^{\circ}50'12''$
 $L = 39.55'$
 $T = 19.94'$
 $LC = S16^{\circ}22'17''W$
39.38'

I. Pin Set
 $\Delta = 87^{\circ}13'20''$
 $R = 95.00'$
 $D = 60^{\circ}18'41''$
 $L = 144.62'$
 $T = 90.50'$
 $LC = N78^{\circ}22'53''W$
131.05'

I. Pin Set
 $\Delta = 16^{\circ}33'40''$
 $R = 125.00'$
 $D = 45^{\circ}50'12''$
 $L = 35.77'$
 $T = 18.01'$
 $LC = S33^{\circ}37'57''W$
35.65'

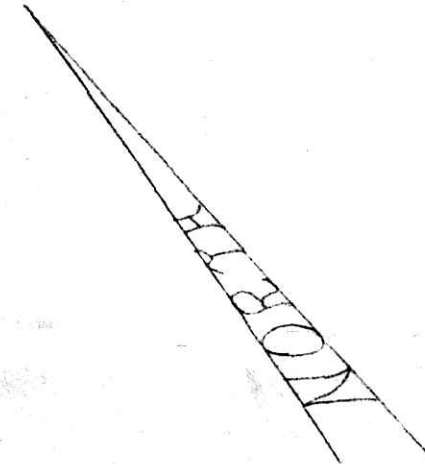

Point on North R North of U.S.R.G. Vol. 222 Pg. 672

N1°40'26"E 740.76'

± Briar Lane

N12°37'11"W 79.96'

N2°11'22"E 198.50' -
Culdesac from P.B. 101 Pg. 308
 $\Delta = 15^{\circ}48'39''$
 $R = 100.00'$
 $D = 57^{\circ}17'45''$
 $L = 27.59'$
 $T = 13.89'$
 $LC = 27.51'$
N1°59'56"W 111.80'
S9°54'14"E

N17°48'33"W 70.59'

S67°58'40"W 297.89'

Frac' 1 Sec. 11, T9N, R7W Hardy Twp., Hol. Co., Ohio

N87°3'38"W 1,750.05' ± 50' Easement

Scale: 1" = 200'

N41°49'47"E 535.37'

6.7904 Acres part of Vol. 222 Pg. 672

N45°28'49"W 25.03'

I. Pin A2

S41°09'47"W 628.77'

Northstar Enterprises Vol. 209 Pg. 265

I. Pin Fd at SW corner Lot 4 Hilltop Acres

S36°38'59"W 200.17'

R. J. & J. A. Ramseyer Vol. 182 Pg. 252


I. Pin Fd at S.W. corner Lot 3 Hilltop Acres

S36°44'23"W 199.97'

N45°28'49"W 296.94'

I. Pin Set A

I. Pin Fd at S.W. corner Lot 2 Hilltop Acres

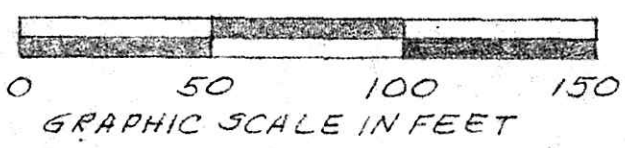

PLAT OF A SURVEY FOR ARLIE RODHE

Known as part of the S.E. 1/4 of Frac' 1 Sec. 11, T9N, R7W, of Hardy Twp., Hol. Co., Ohio
Robert L. Kasner P.S. 5193
R.E. 28820
7/23/89



166297
REC'D. DEC 29 1989
AT 2:27 O'CLOCK P.M.
RECORDED JAN 02 1990
Plat VOL 13 PG 90
Holmes Co. Ohio Fee: 25.72
Richard Brown Recorder
24.5 x 21 x .05