



180791

PAINT TOWNSHIP  
S.W. QTR. SECTION 27  
T-15N; R-11W  
HOLMES COUNTY, OHIO

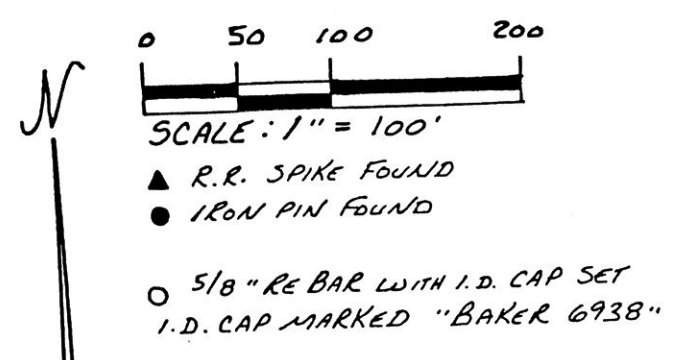

- REFERENCES:**
- PLAT VOL. 10 PAGE 92
  - PLAT VOL. 13 PAGE 22
  - PLAT VOL. 13 PAGE 73
  - PLAT VOL. 10 PAGE 458
  - PLAT VOL. 12 PAGE 82
  - PLAT VOL. 9 PAGE 216
  - DEED VOL. 256 PAGE 724
  - PLAT VOL. 14 PAGE 16
  - DEED VOL. 240 PAGE 269
  - DEED VOL. 240 PAGE 727
  - DEED VOL. 241 PAGE 287
- BEARINGS FROM DEED VOL. 255 PAGE 951

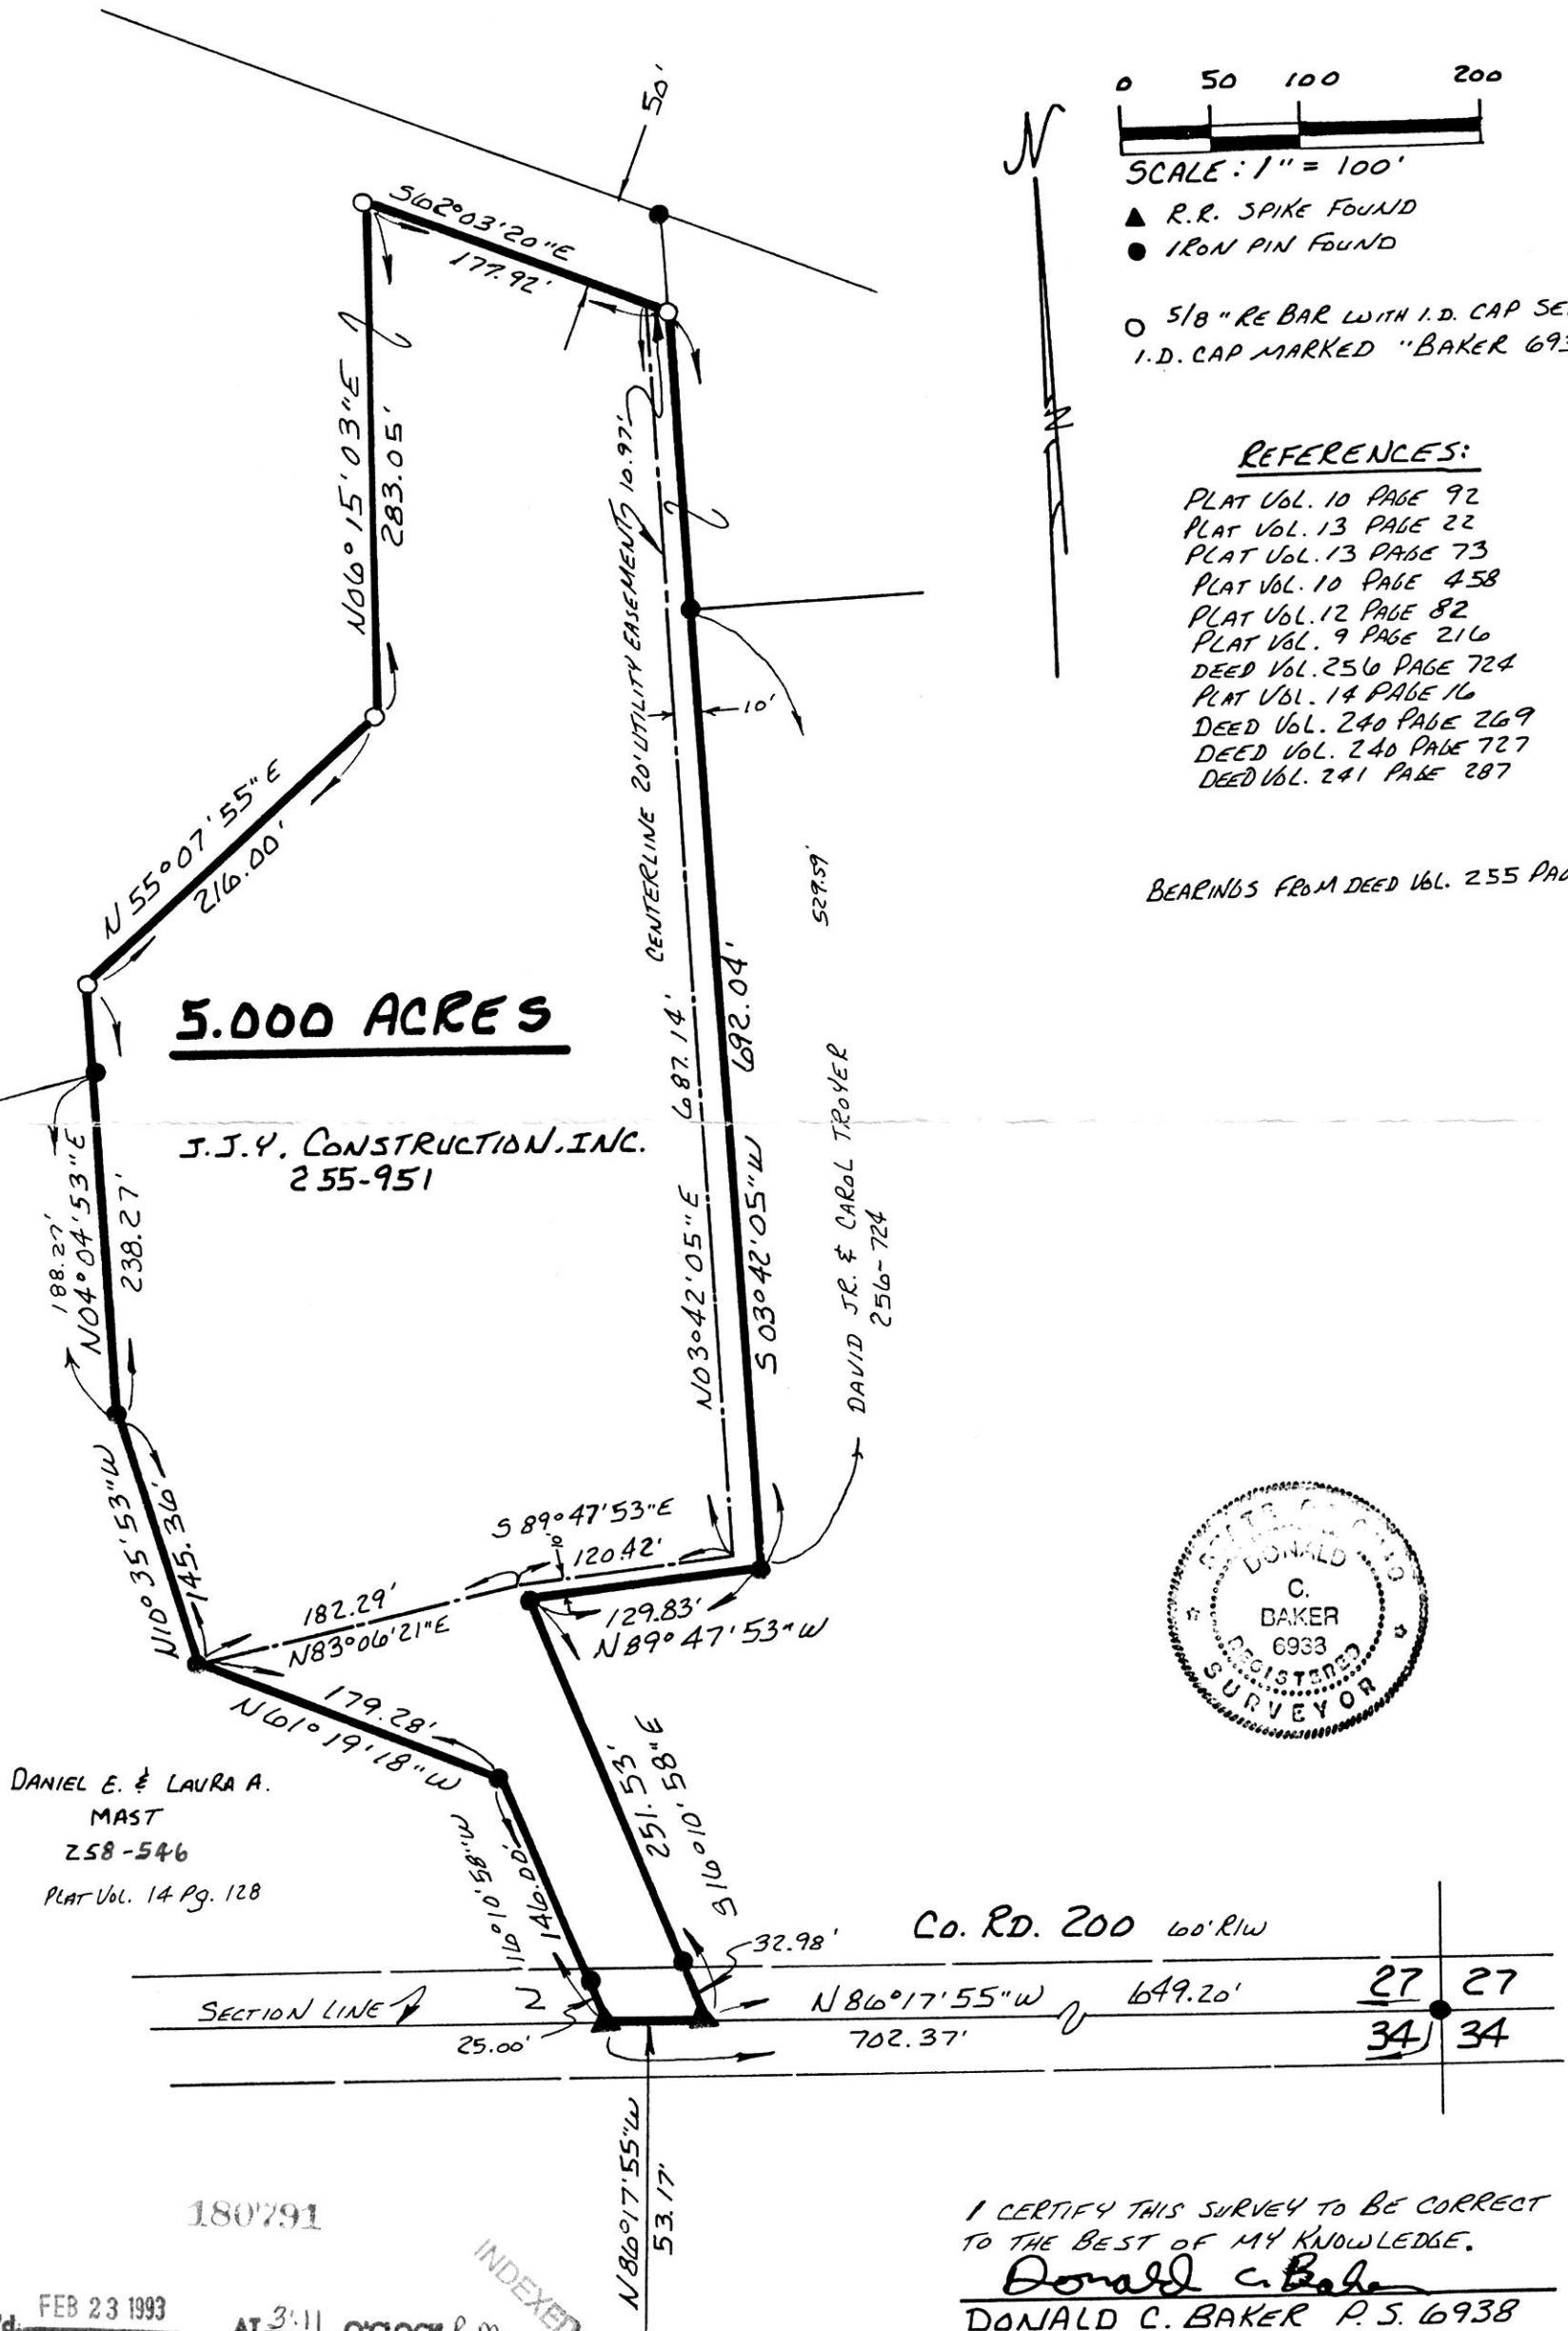

I CERTIFY THIS SURVEY TO BE CORRECT TO THE BEST OF MY KNOWLEDGE.  
*Donald C. Baker*  
DONALD C. BAKER P.S. 6938  
5958 T.R. 322  
MILLERSBURG, OHIO 44654  
PH. (216) 674-4788  
FEBRUARY 17, 1993

180791  
INDEXED  
Rec'd. FEB 23 1993 AT 3:11 O'CLOCK P.M.  
Recorded FEB 24 1993 Holmes Co. Ohio Fee 9.35  
Plat Vol. 14 Pg. 153 Recorder Sally Miller  
Deed vol. 258 pg. 1015  
*Lance Hines*