


KILLBUCK TOWNSHIP  
 S.E. & S.W. QTRS. SECTION 13  
 T-8N; R-8W  
 HOLMES COUNTY, OHIO

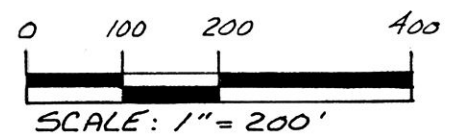

- IRON PIN FOUND
- 5/8" RE BAR WITH I.D. CAP SET
- I.D. CAP MARKED "BAKER 6938"

REFERENCES:

- PLAT VOL. 5 PAGE 64
- PLAT VOL. 12 PAGE 730
- DEED VOL. 231 PAGE 536
- DEED VOL. 175 PAGE 595
- DEED VOL. 252 PAGE 572


BEARINGS FROM PLAT VOL. 9 PAGE 167



I CERTIFY THIS SURVEY TO BE CORRECT TO THE BEST OF MY KNOWLEDGE.

Donald C. Baker  
 DONALD C. BAKER P.S. 6938  
 5958 T.R. 322  
 MILLERSBURG, OHIO 44654  
 PH. 216 674-4788  
 JANUARY 7, 1993

48092E-MLS

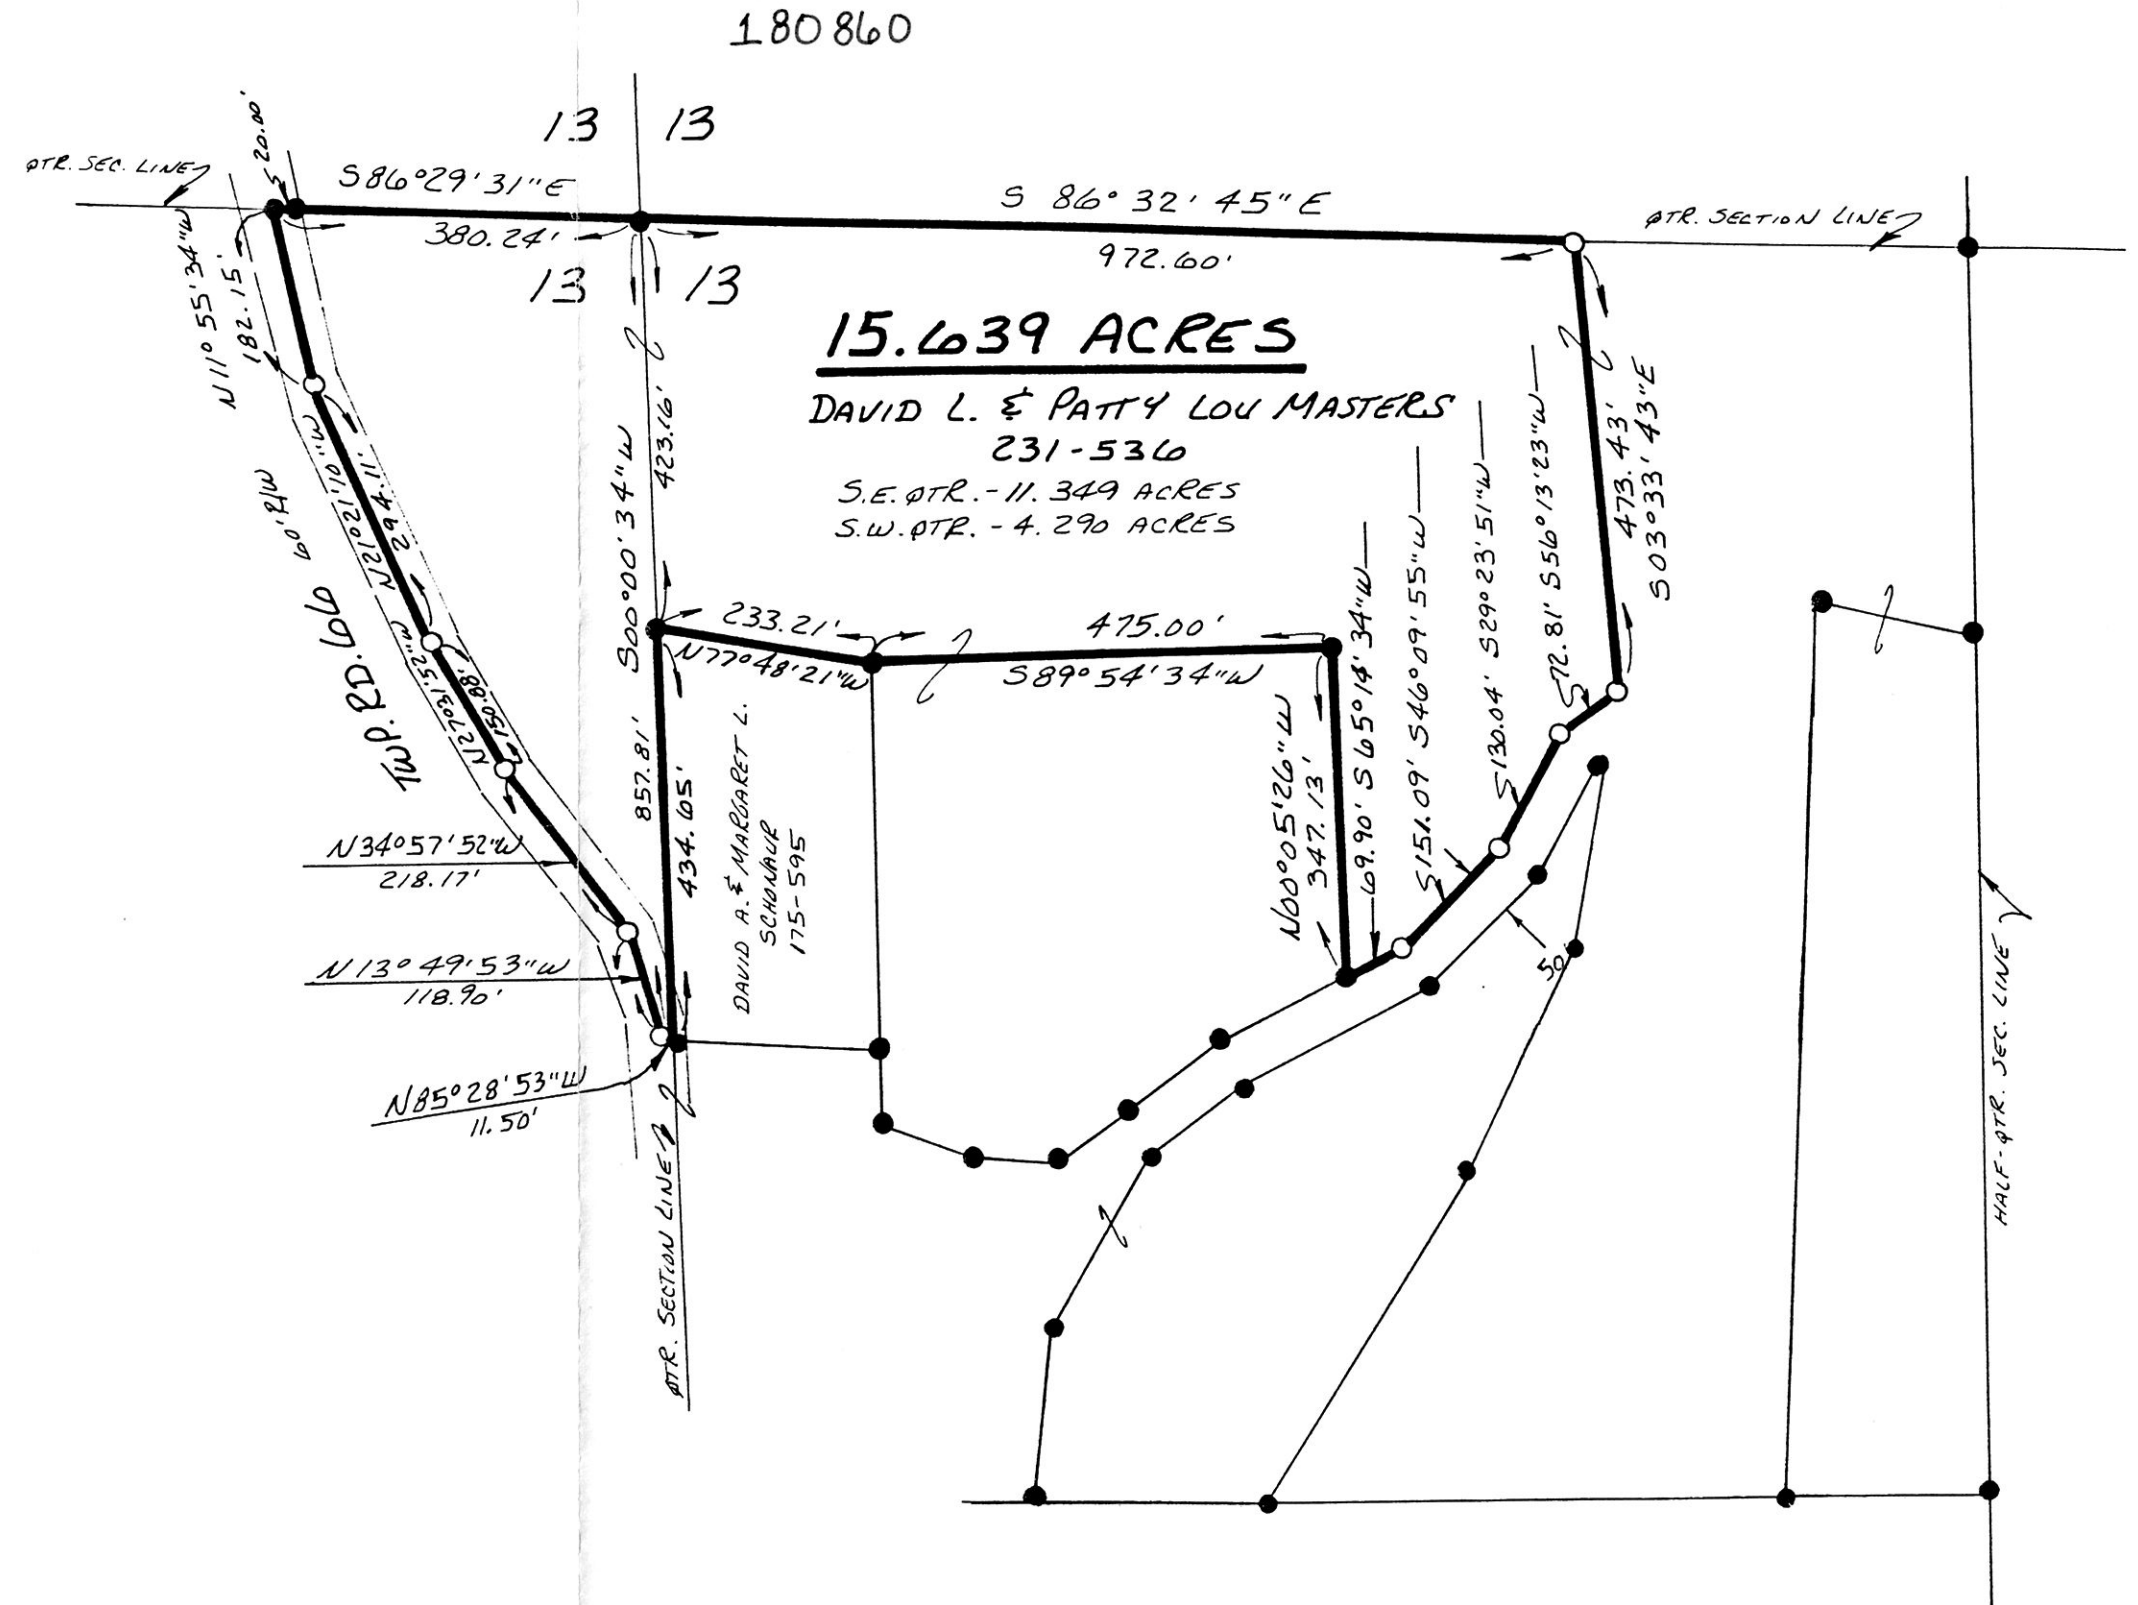

180860

Rec'd. MAR 02 1993 AT 12:46 O'CLOCK P.M.  
 Recorded MAR 03 1993 Holmes Co. Ohio Fee \$9.35  
 Plat Vol. 14 Pg. 157 Recorder: Sally Miller  
 Deed vol. 259 pg 48

INDEXED

PLAT APPROVED  
 2/26/93B