


181726 WALNUT CREEK TOWNSHIP  
1ST. QTR. LOTS 2 & 3  
T-9N R-5W  
HOLMES COUNTY, OHIO

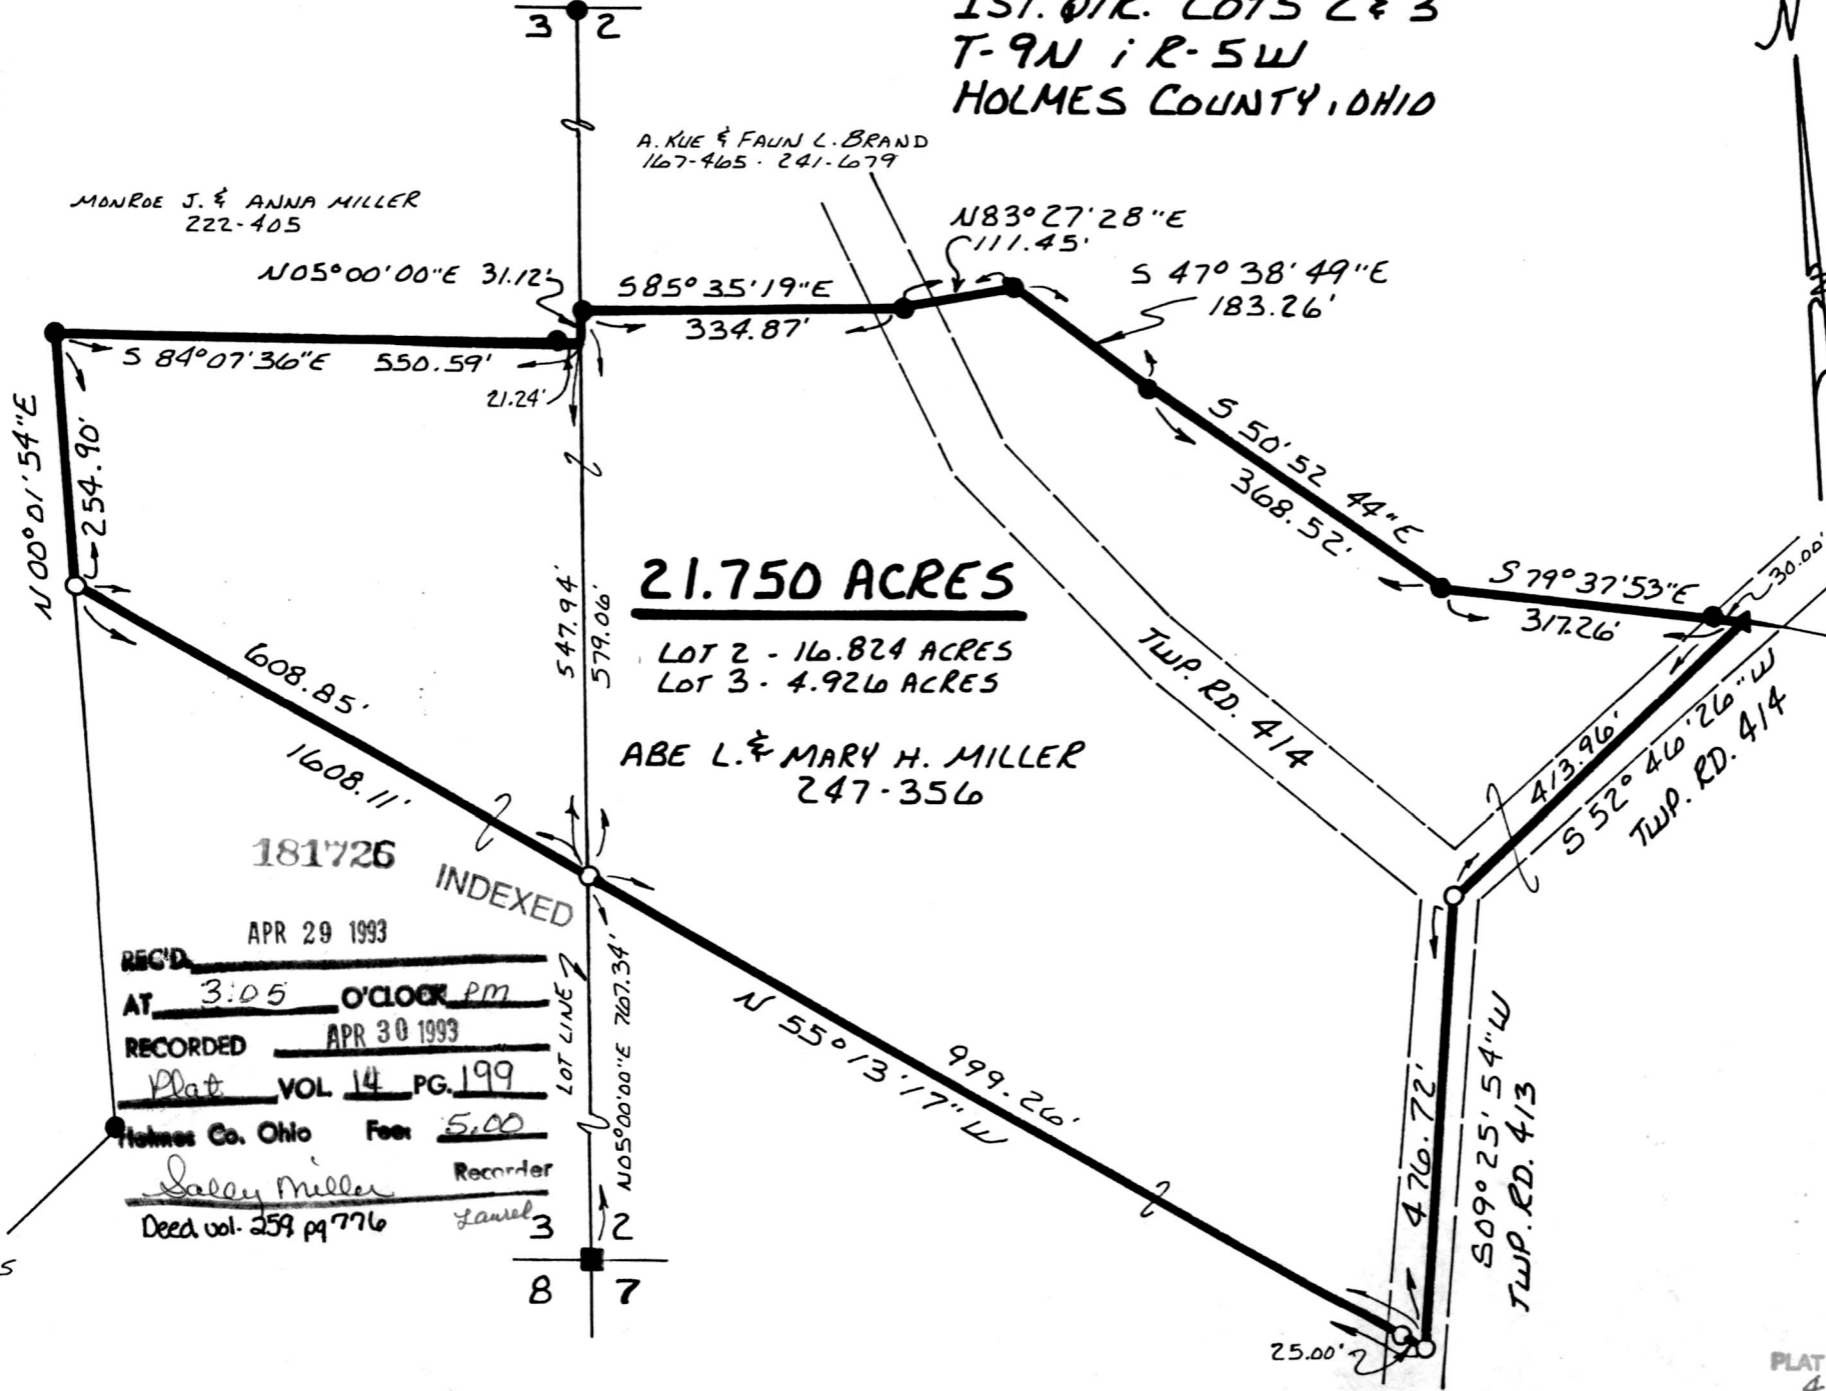

- SCALE: 1" = 200'
- ▲ R.R. SPIKE FOUND
  - IRON PIN FOUND
  - 5/8" RE BAR WITH I.D. CAP SET
  - I.D. CAP MARKED "BAKER 6938"



REFERENCES:

- PLAT VOL. 6 PAGE 126
- PLAT VOL. 9 PAGE 84
- DEED VOL. 247 PAGE 356
- PLAT VOL. 12 PAGE 444
- DEED VOL. 222 PAGE 405

BEARINGS FROM DEED  
VOL. 241 PAGE 677


**21.750 ACRES**

LOT 2 - 16.824 ACRES  
LOT 3 - 4.926 ACRES

ABE L. & MARY H. MILLER  
247-356

181726

REC'D APR 29 1993  
 AT 3:05 O'CLOCK PM  
 RECORDED APR 30 1993  
 Plat VOL 14 PG 199  
 Holmes Co. Ohio Fees 5.00  
 Sally Miller Recorder  
 Deed vol. 259 pg 776 Laurel 3

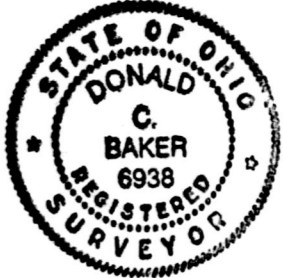

I CERTIFY THIS SURVEY TO BE  
CORRECT TO THE BEST OF MY  
KNOWLEDGE.

*Donald C. Baker*  
 DONALD C. BAKER P.S. 6938  
 4321 T.R. 252  
 GLENMONT, OHIO 44628

OCT. 23, 1991

PLAT APPROVED  
4/28/93 B