

WALNUT CREEK TOWNSHIP
 S.E. QTR. SECTION 23
 T-9N; R-5W
 HOLMES COUNTY, OHIO



SCALE: 1" = 200'

- IRON PIN FOUND
- 5/8" RE BAR WITH I.D. CAP SET I.D. CAP MARKED "BAKER 6938"

REFERENCES:

- PLAT Vol. 8 PAGE 432
- PLAT Vol. 10 PAGE 412
- DEED Vol. 221 PAGE 485
- PLAT Vol. 5 PAGE 31
- PLAT Vol. 8 PAGE 99
- BEARINGS FROM SURVEY
- RECORD 5 PAGE 78




I CERTIFY THIS SURVEY TO BE CORRECT TO THE BEST OF MY KNOWLEDGE.

Donald C Baker
 DONALD C. BAKER P.S. 6938
 4321 T.R. 252
 GLENMONT OHIO 44628

NOVEMBER 20, 1991

192B-MLS
 A

PLAT APPROVED
6/29/92B

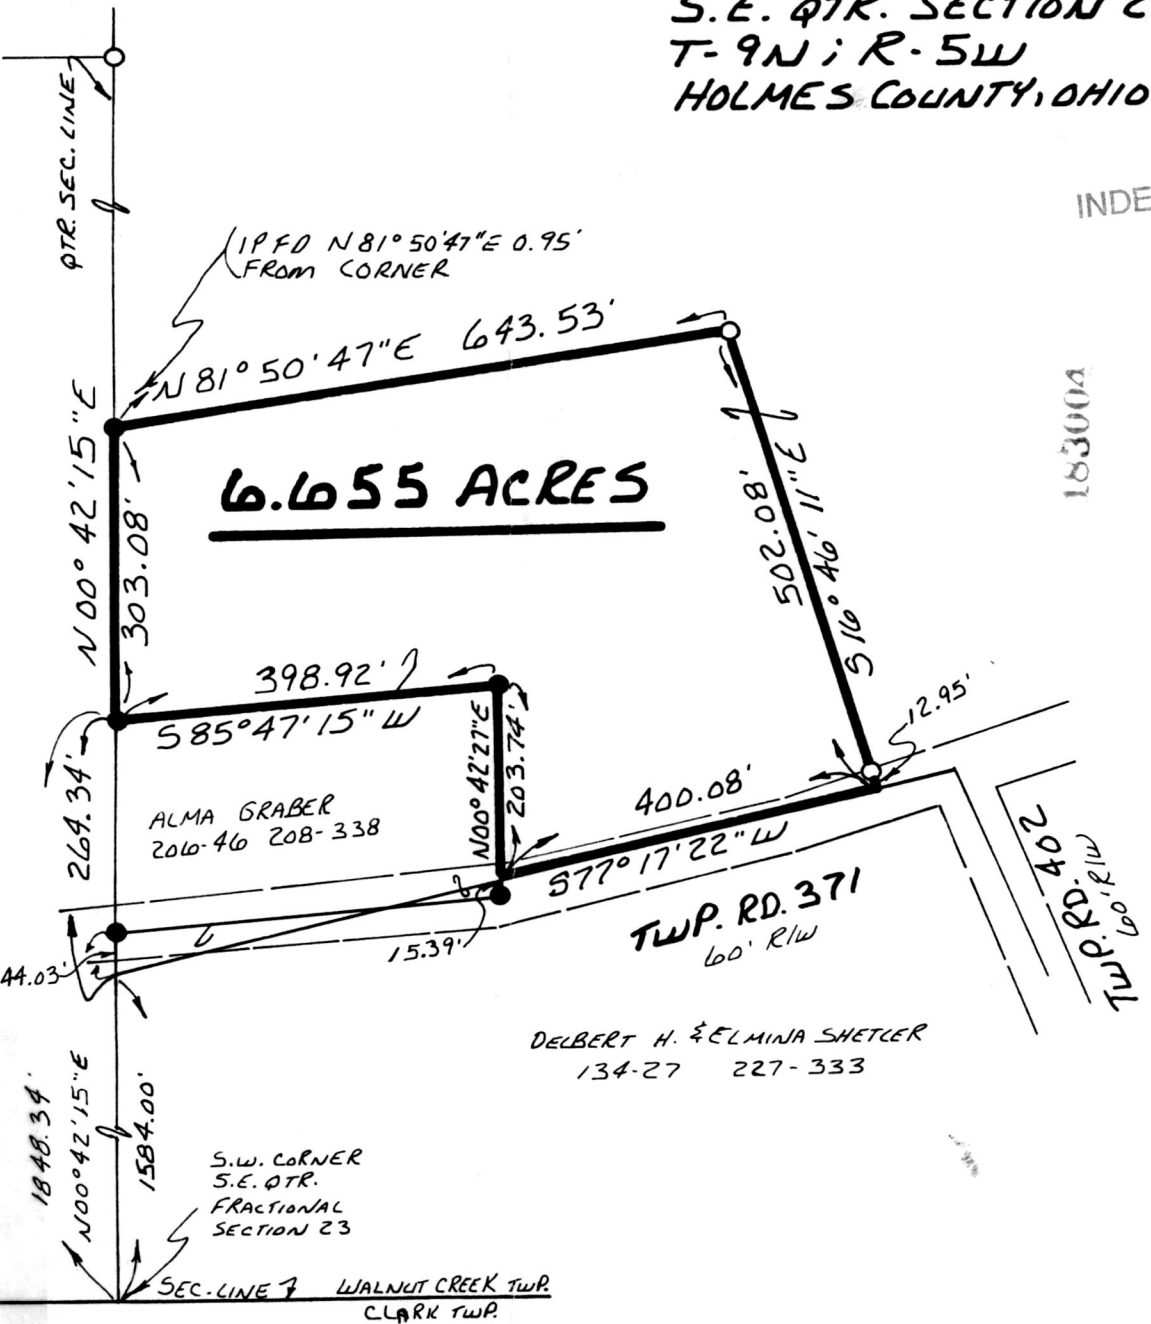

INDEXED

AT 11:20 O'CLOCK A.M.
 JUL 15 1993
 JUL 16 1993
 Holmes Co. Ohio Recorder
 Vol. 14 Pg. 256
 Deed Vol. 260 Pg. 746
 Recorder: Sally Miller

183004

VOL 14 PAGE 256