


120.00

VILLAGE OF MILLERSBURG
PART OF O.L. 95

HARDY TOWNSHIP
N.E. QTR. SEC. 19
T-9N ; R-7W
HOLMES COUNTY, OHIO

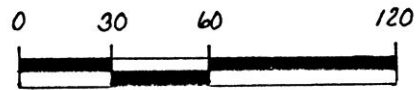

SCALE: 1" = 60'


● IRON PIN FOUND



REFERENCES:

- DEED VOL. 115 PAGE 166
- DEED VOL. 223 PAGE 444
- DEED VOL. 248 PAGE 6
- DEED VOL. 246 PAGE 123
- DEED VOL. 164 PAGE 381
- DEED VOL. 177 PAGE 573
- PLAT VOL. 12 PAGE 369
- PLAT VOL. 1 PAGE 415
- PLAT VOL 9 PAGE 14


BEARINGS FROM PLAT VOL. 12
PAGE 479

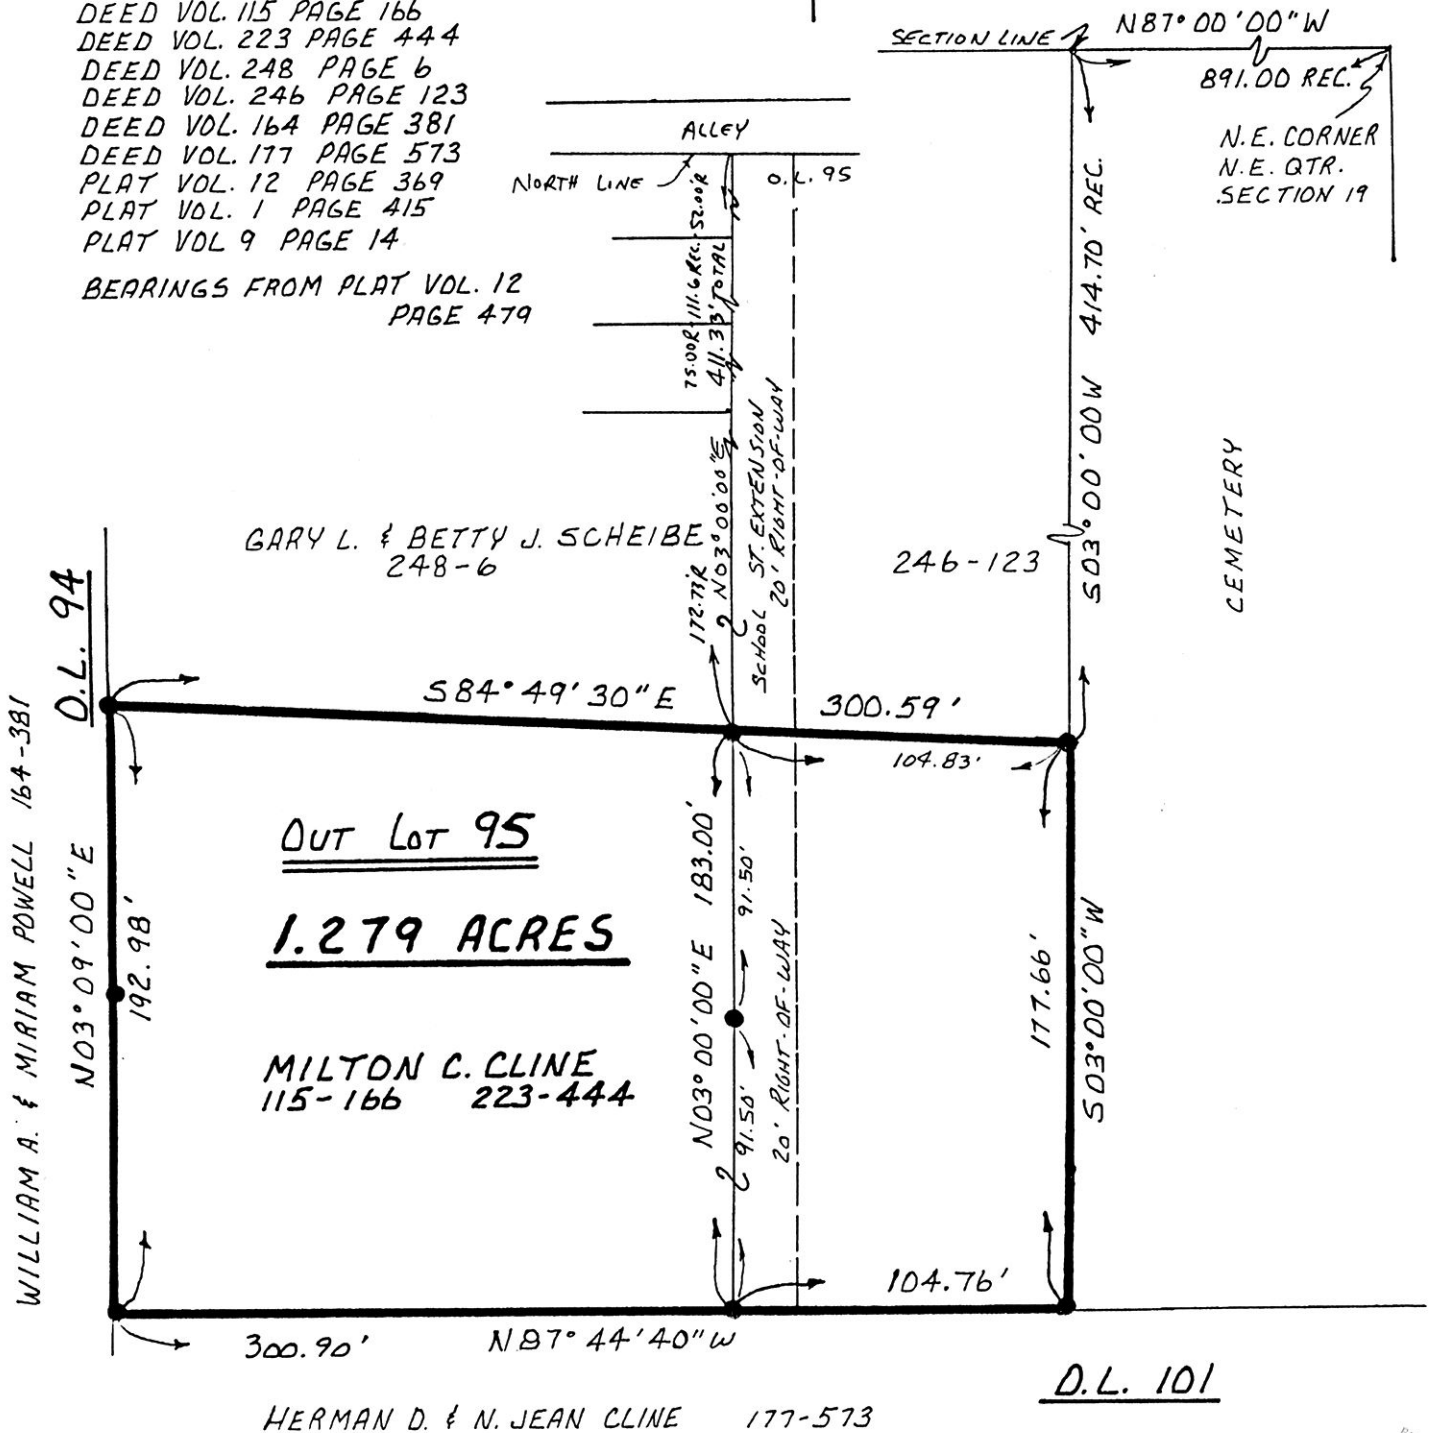

I CERTIFY THIS SURVEY TO BE CORRECT TO THE BEST OF MY KNOWLEDGE.

Donald C. Baker
DONALD C. BAKER P.S. 6938
5958 Y.R. 322
MILLERSBURG, OHIO 44654
PH: (216) 674-4788

AUGUST 6, 1993
38993-BEC

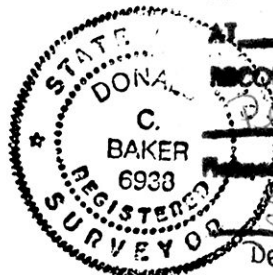

REC'D. SEP 02 1993
AT 1:30 O'CLOCK PM
RECORDED SEP 03 1993
Plat VOL 14 PG 294
Co. Ohio Fee: \$20.00
Sally Miller Recorder
Deed vol. 261 pg. 458

PLAT APPROVED
8/30/93 B

INDEXED