


SALTCREEK TOWNSHIP  
N.W. QTR. SECTION 8  
T-14N; R-12W  
HOLMES COUNTY, OHIO

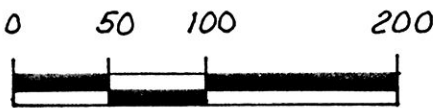


SCALE: 1" = 100'


- STONE FOUND
- IRON PIN FOUND
- ▲ R. R. SPIKE FOUND
- 5/8" REBAR WITH I. D. CAP SET.  
I. D. CAP MARKED "BAKER 6938."

REFERENCES:

DEED VOL. 256 PAGE 507  
 DEED VOL. 161-PAGE 469  
 DEED VOL. 251-PAGE 875  
 BEARINGS FROM DEED VOL 259 PAGE 587

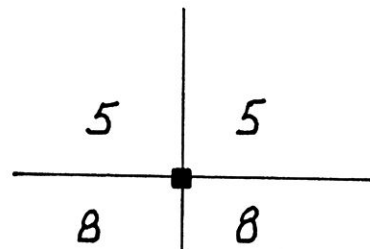

MOSE J.S. & ANNA YODER  
 161-469 251-875

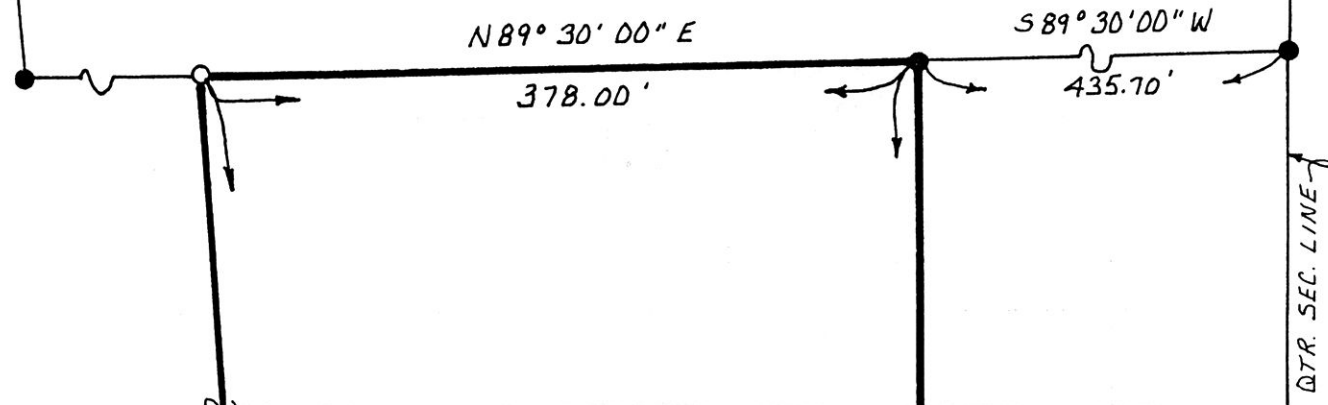


**5.502 AC.**

ALBERT J. & FANNIE D.  
 MILLER  
 256-507

HUBERTUS & BETTY E.  
 HORSTING  
 259-587

N03°13'53" W  
 711.38'

643.93'  
 S00°50'14" W

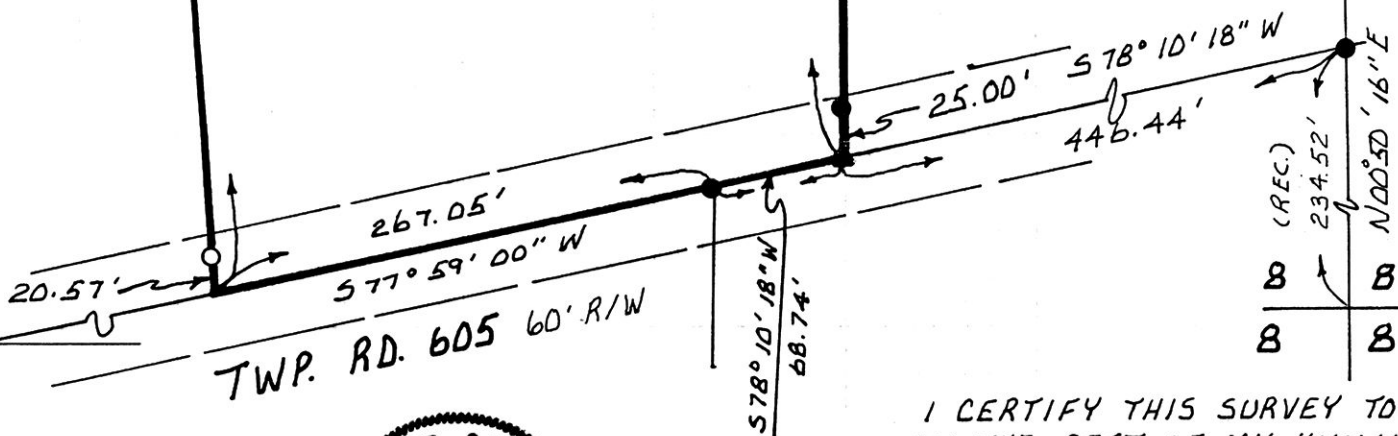

I CERTIFY THIS SURVEY TO BE CORRECT  
 TO THE BEST OF MY KNOWLEDGE.

*Donald C. Baker*  
 DONALD C. BAKER P. S. 6938  
 5958 T. R. 322  
 MILLERSBURG, OHIO 44654  
 PH: (216) 674-4788

AUGUST 27, 1993

Rec'd OCT 08 1993  
 Recorded OCT 12 1993  
 Plat Vol. 14  
 Deed vol. 261 pg 849

AT 9:26 O'CLOCK A.M.  
 Holmes Co. Ohio Fee \$20.00  
 Pg. 319 Recorder Sally Miller

43193-BEC

PLAT APPROVED  
 9/3/93B