



KNOX TOWNSHIP  
N.W. & S.W. QTR. SECTION 23  
T-9N; R-9W  
HOLMES COUNTY, OHIO

RESURVEY OF DEED VOL. 194 PG. 229 (31.969 AC. TRACT)  
AND DEED VOL. 194 PG. 232 (0.066 AC. TRACT)

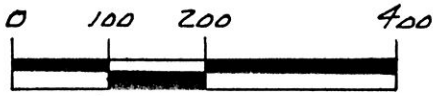

SCALE: 1" = 200'

- STONE FOUND
- IRON PIN FOUND
- 5/8" RE BAR WITH I.D. CAP SET
- I.D. CAP MARKED "BAKER 6938"

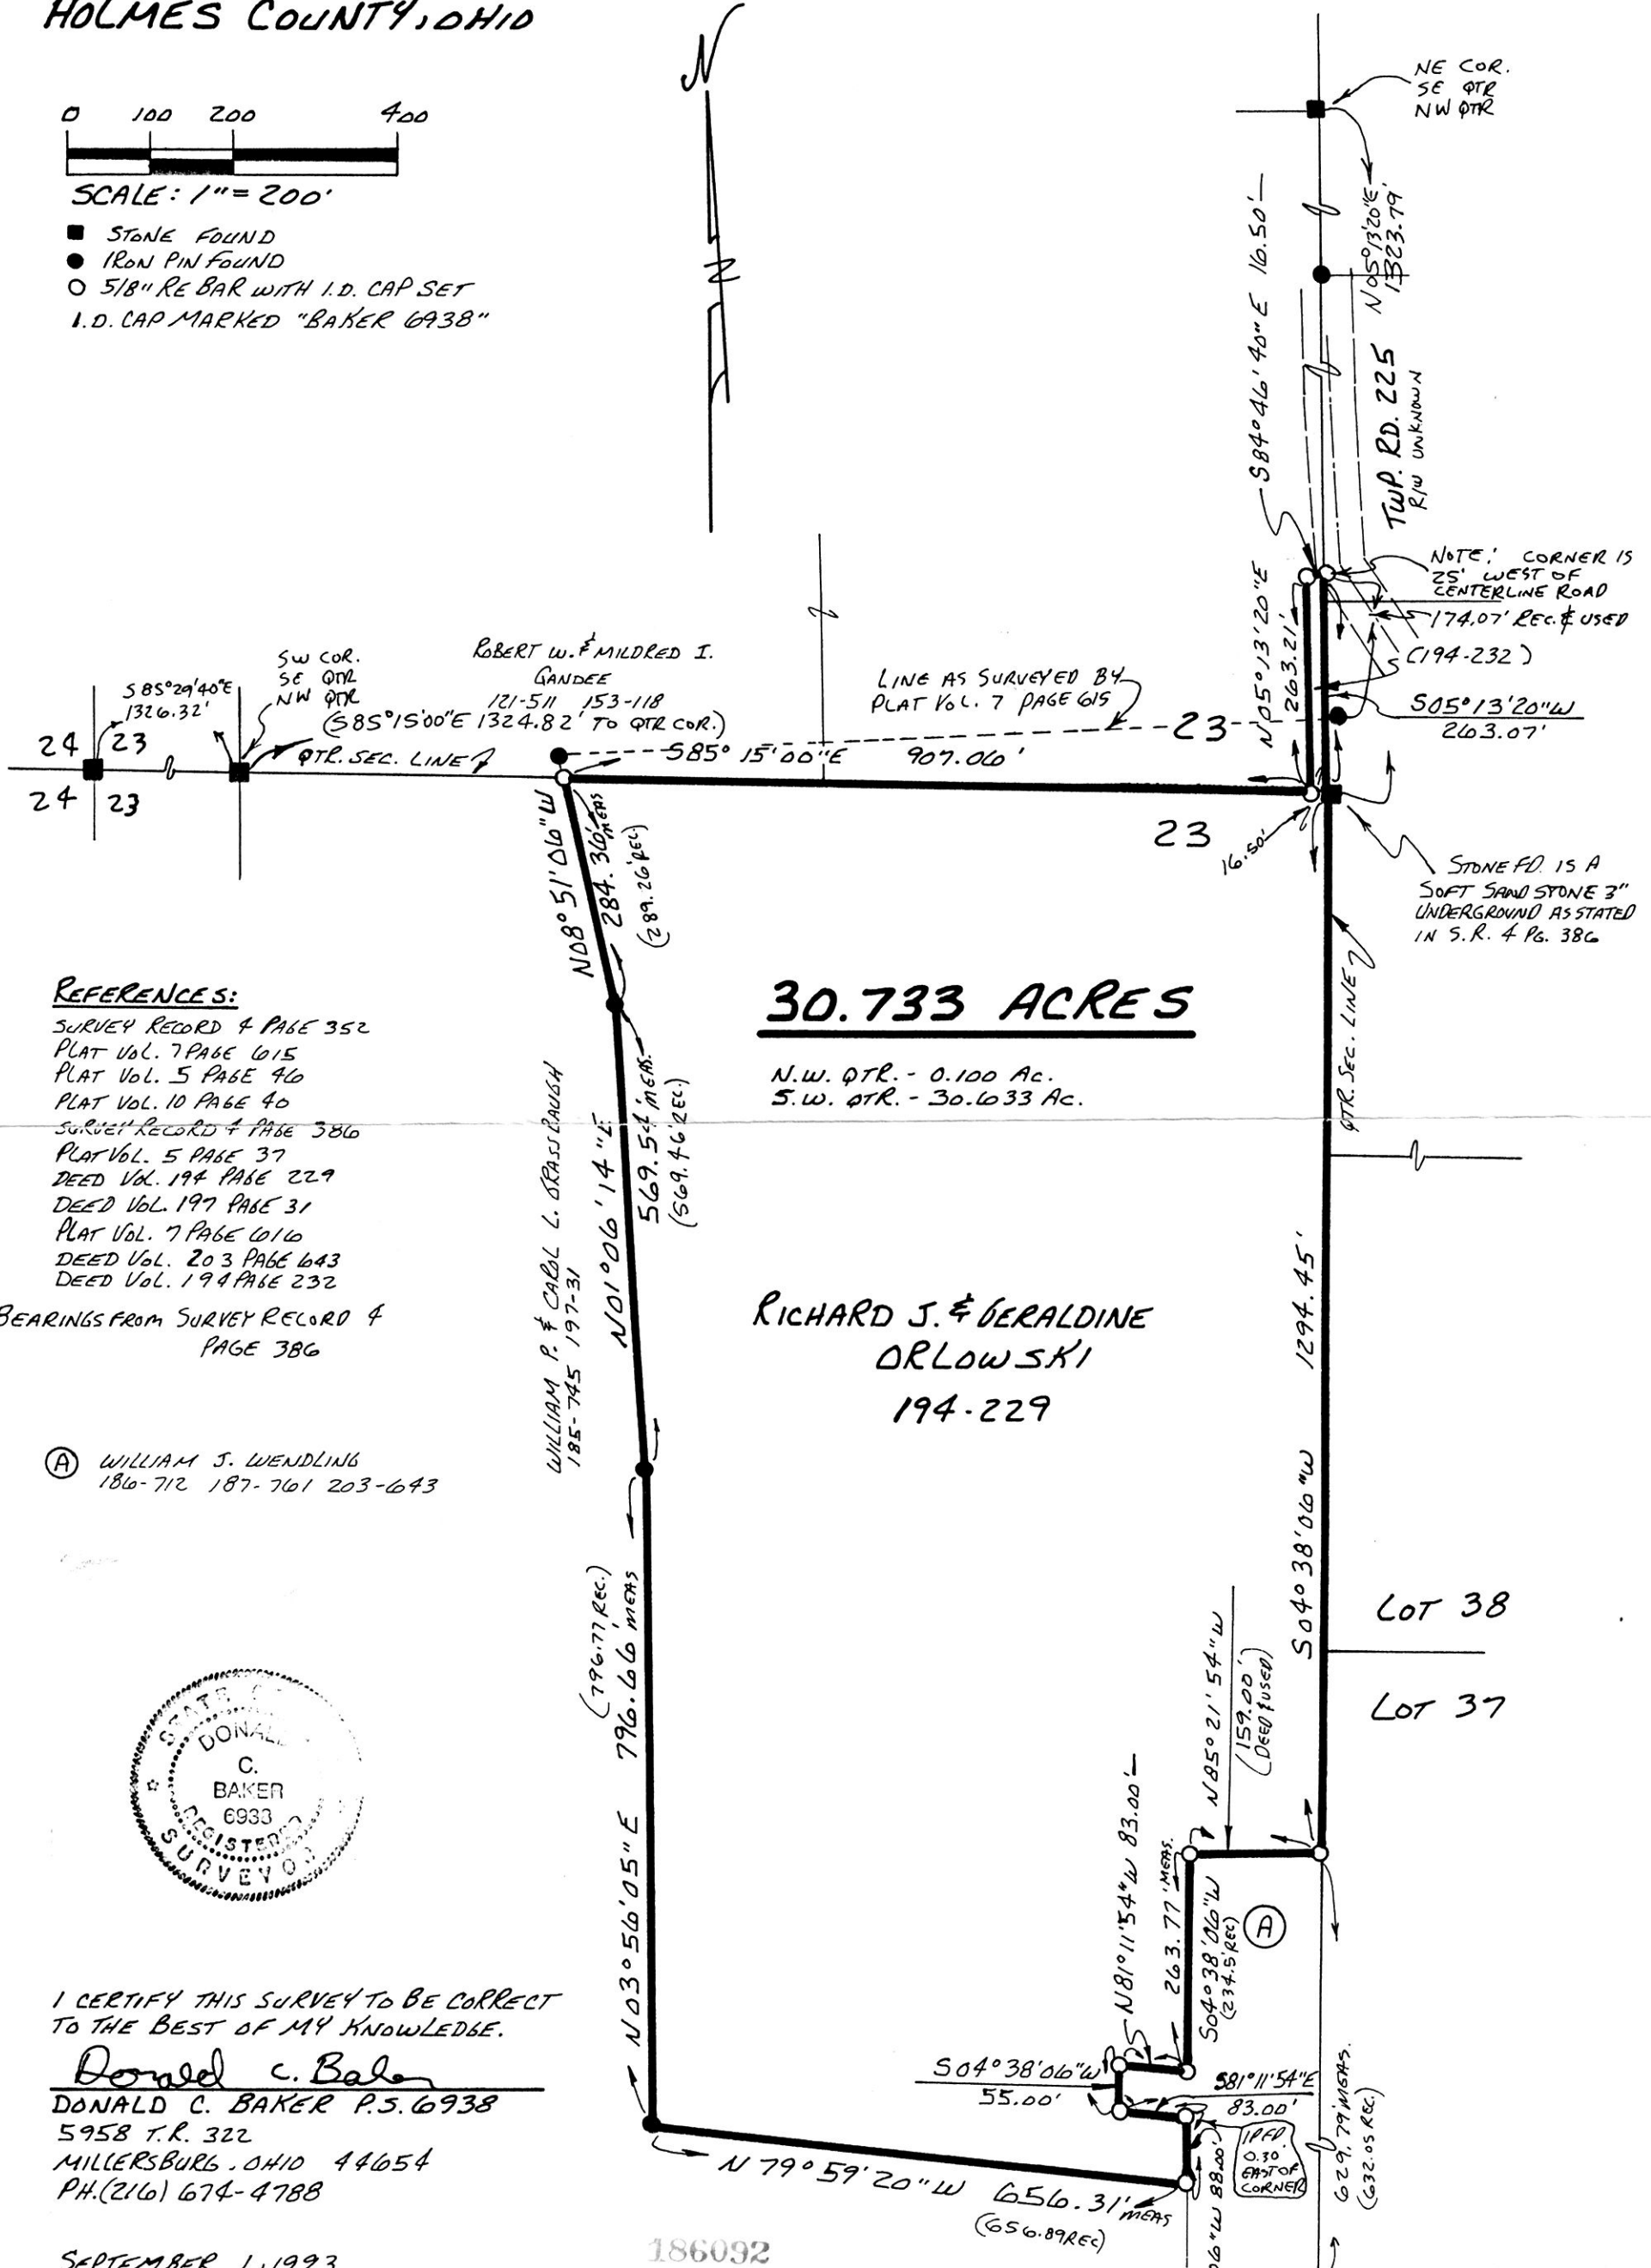

**30.733 ACRES**

N.W. QTR. - 0.100 Ac.  
S.W. QTR. - 30.633 Ac.

**RICHARD J. & GERALDINE  
ORLOFSKI  
194-229**

**REFERENCES:**

- SURVEY RECORD 4 PAGE 352
- PLAT VOL. 7 PAGE 615
- PLAT VOL. 5 PAGE 46
- PLAT VOL. 10 PAGE 40
- SURVEY RECORD 4 PAGE 386
- PLAT VOL. 5 PAGE 37
- DEED VOL. 194 PAGE 229
- DEED VOL. 197 PAGE 31
- PLAT VOL. 7 PAGE 616
- DEED VOL. 203 PAGE 643
- DEED VOL. 194 PAGE 232

BEARINGS FROM SURVEY RECORD 4  
PAGE 386

(A) WILLIAM J. WENDLING  
186-712 187-761 203-643



I CERTIFY THIS SURVEY TO BE CORRECT  
TO THE BEST OF MY KNOWLEDGE.

Donald C. Baker  
DONALD C. BAKER P.S. 6938  
5958 T.R. 322  
MILLERSBURG, OHIO 44654  
PH. (216) 674-4788

SEPTEMBER 1, 1993

42493-MLS

Recorded JAN 28 1994

Recorded JAN 31 1994

Plat Vol. 14

Deed vol. 263 pgs 310-312

AT 3:16 O'CLOCK P.M.

Holmes Co. Ohio Fee \$20.00

Page 425

Recorder Jerry Miller

R.R.

INDEXED

(See Split # 940006)

PLAT APPROVED  
1-14-94