VOL 14 PAGE 532

188077

#20.00 pd.

KNOX TOWNSHIP
S.E. QTR. SECTION 24
T-19N ; R-15W
HOLMES COUNTY, OHIO

REFERENCES:

DEED VOL. 180 PAGE 558
DEED VOL. 158 PAGE 519
DEED VOL. 216 PAGE 460
SURVEY RECORD 4 PAGE 86
SURVEY RECORD 3 PAGE 259
PLAT VOL. 12 PAGE 797
BEARINGS FROM PLAT VOL. 14 PAGE 415

0 150 300 600

SCALE : 1" = 300'

- ■ STONE FOUND
- ▲ R.R. SPIKE FOUND
- ● IRON PIN FOUND
- △ R. R. SPIKE SET
- ○ 5/8" REBAR WITH I.D. CAP SET

I.D. CAP MARKED "BAKER 6938"

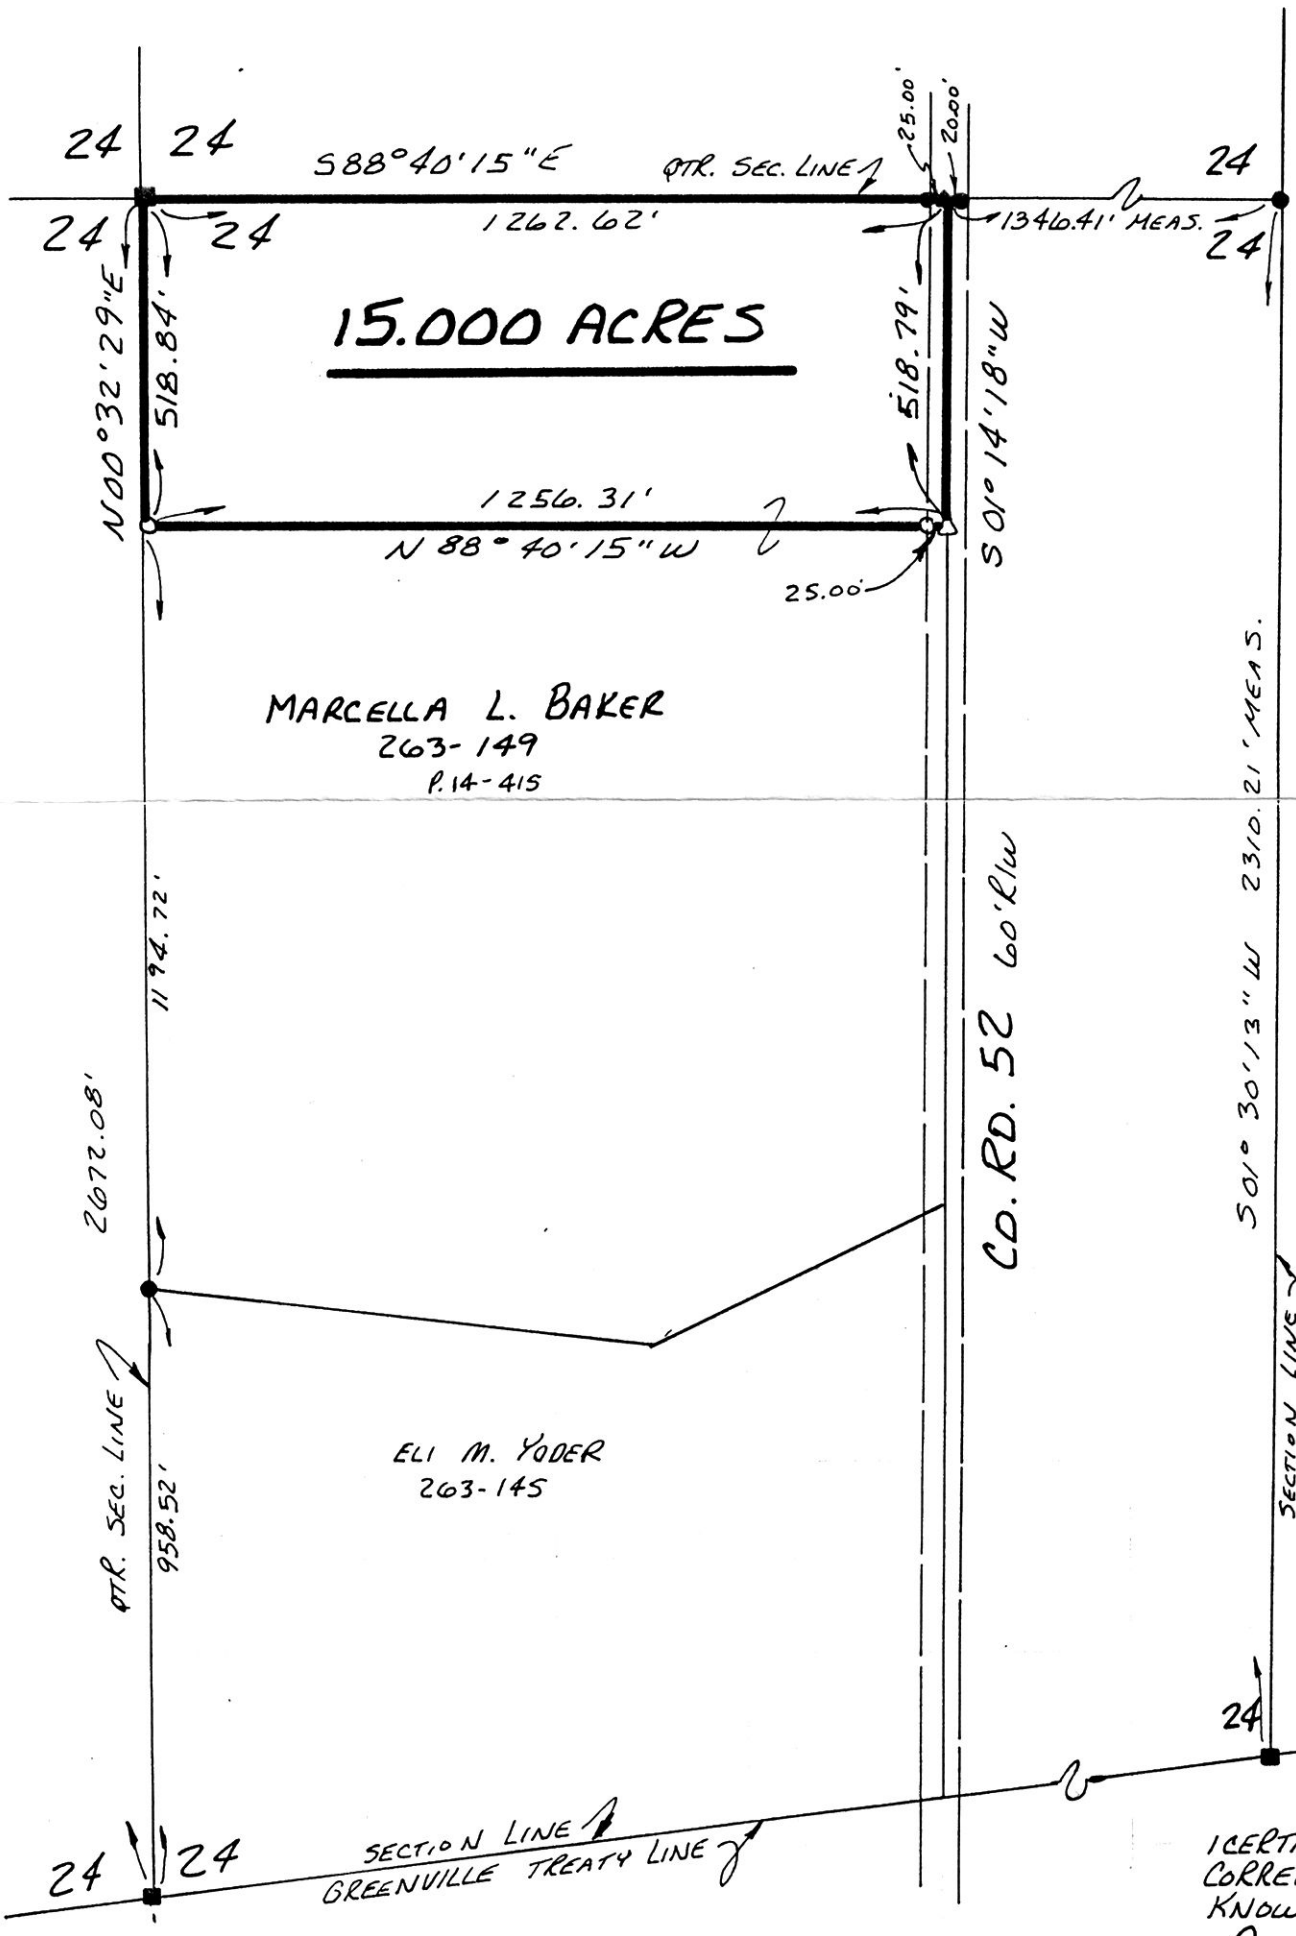

STATE OF OHIO
DONALD C. BAKER 6938
PROFESSIONAL SURVEYOR

I CERTIFY THIS SURVEY TO BE CORRECT TO THE BEST OF MY KNOWLEDGE.

Donald C. Baker

DONALD C. BAKER PS. 6938
5958 T.R. 322
MILLERS BURG, OHIO 44654
PH. (216) 674-4788

MAY 12, 1993

27194.MCS

188077

INDEXED

REC'D
AT 2:24 o'clock P.m.
JUN 14 '94

RECORDED
FEE #20.00
JUN 15 '94

Plat
VOL 14 PAGE 532 Sally Miller RECORDER
Deed vol. 264 pg 823

S S

PLAT APPROVED
6/9/94 b