

189366

HARDY TOWNSHIP  
1ST. QTR. LOTS 16 & 17  
T-9N ; R-7W  
HOLMES COUNTY, OHIO

pd. = 20.00  
0 100 200 400

SCALE: 1" = 200'



▲ R.R. SPIKE FOUND

● P.K. NAIL FOUND

● 5/8" REBAR WITH I.D. CAP FOUND  
I.D. CAP MARKED "BAKER 6938"

REFERENCES:

DEED VOL. 230 PAGE 462  
DEED VOL. 230 PAGE 464  
DEED VOL. 257 PAGE 634  
PLAT VOL. 12 PAGE 502  
PLAT VOL. 3 PAGE 73  
PLAT VOL. 7 PAGE 115  
BEARINGS FROM DEED VOL. 257  
PAGE 417

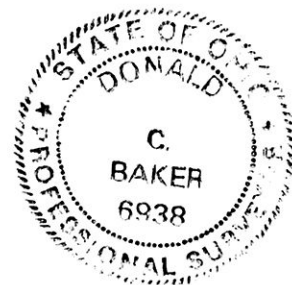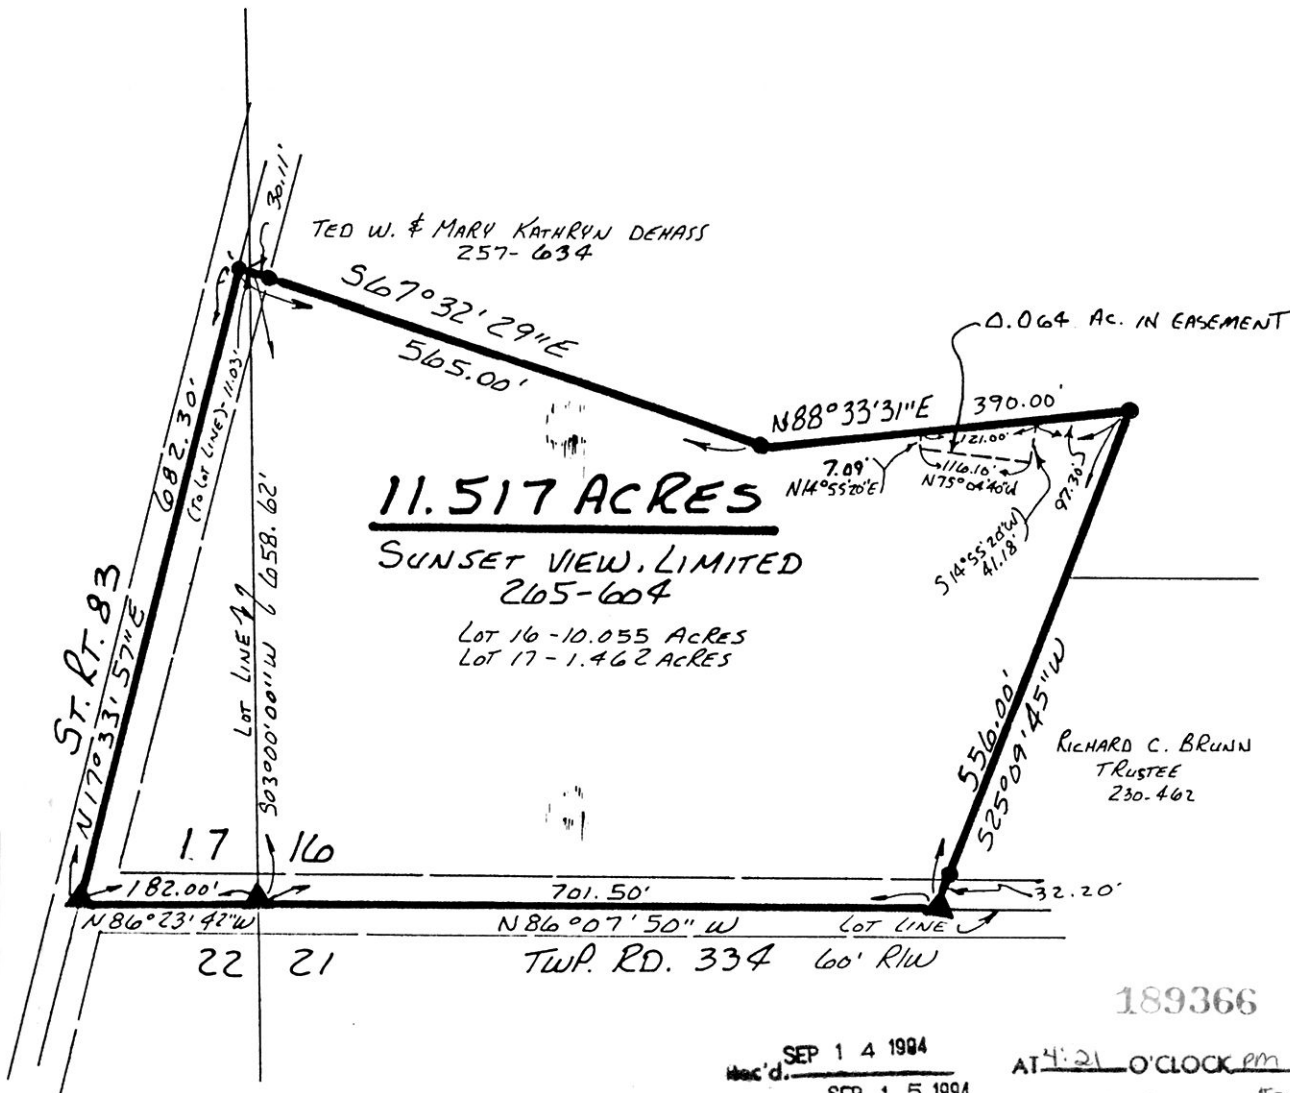

I CERTIFY THIS SURVEY TO BE CORRECT TO THE BEST OF MY KNOWLEDGE.

Donald C. Baker  
DONALD C. BAKER P.S. 6938  
5958 T.R. 322  
MILLERSBURG, OHIO 44654  
PH. (216) 674-4788  
SEPT. 9, 1994

189366

Rec'd. SEP 14 1994  
Recorded SEP 15 1994  
Plat Vol. 14  
Deed vol. 265 pg 945

AT 4:21 O'CLOCK pm  
Holmes Co. Ohio Fee: \$2000  
Pg 604 Recorder Sally Miller

INDEXED

50894-MLS

PLAT APPROVED  
9/14/94

VOL 14 PAGE 604