

REFERENCES:

- DEED VOL. 243 PAGE 973
- DEED VOL. 143 PAGE 495
- PLAT VOL. 3 PAGE 8 B
- PLAT VOL. 7 PAGE 3
- PLAT VOL. 3 PAGE 25
- PLAT VOL. 5 PAGE 130
- SURVEY RECORD 3 PAGE 187


VILLAGE OF WINESBURG
OUT LOT 27

PAINT TWP. 3RD. QTR.
LOT 38, T-16N R-4W
HOLMES COUNTY, OHIO

0 50 100 200
SCALE: 1" = 100'

- STONE FOUND
- IRON PIN FOUND
- △ R.R. SPIKE SET
- P.K. NAIL SET
- 5/8" REBAR WITH I.D. CAP SET
- I.D. CAP MARKED "BAKER 6938"

BEARINGS FROM PLAT VOL. 3 PAGE 25

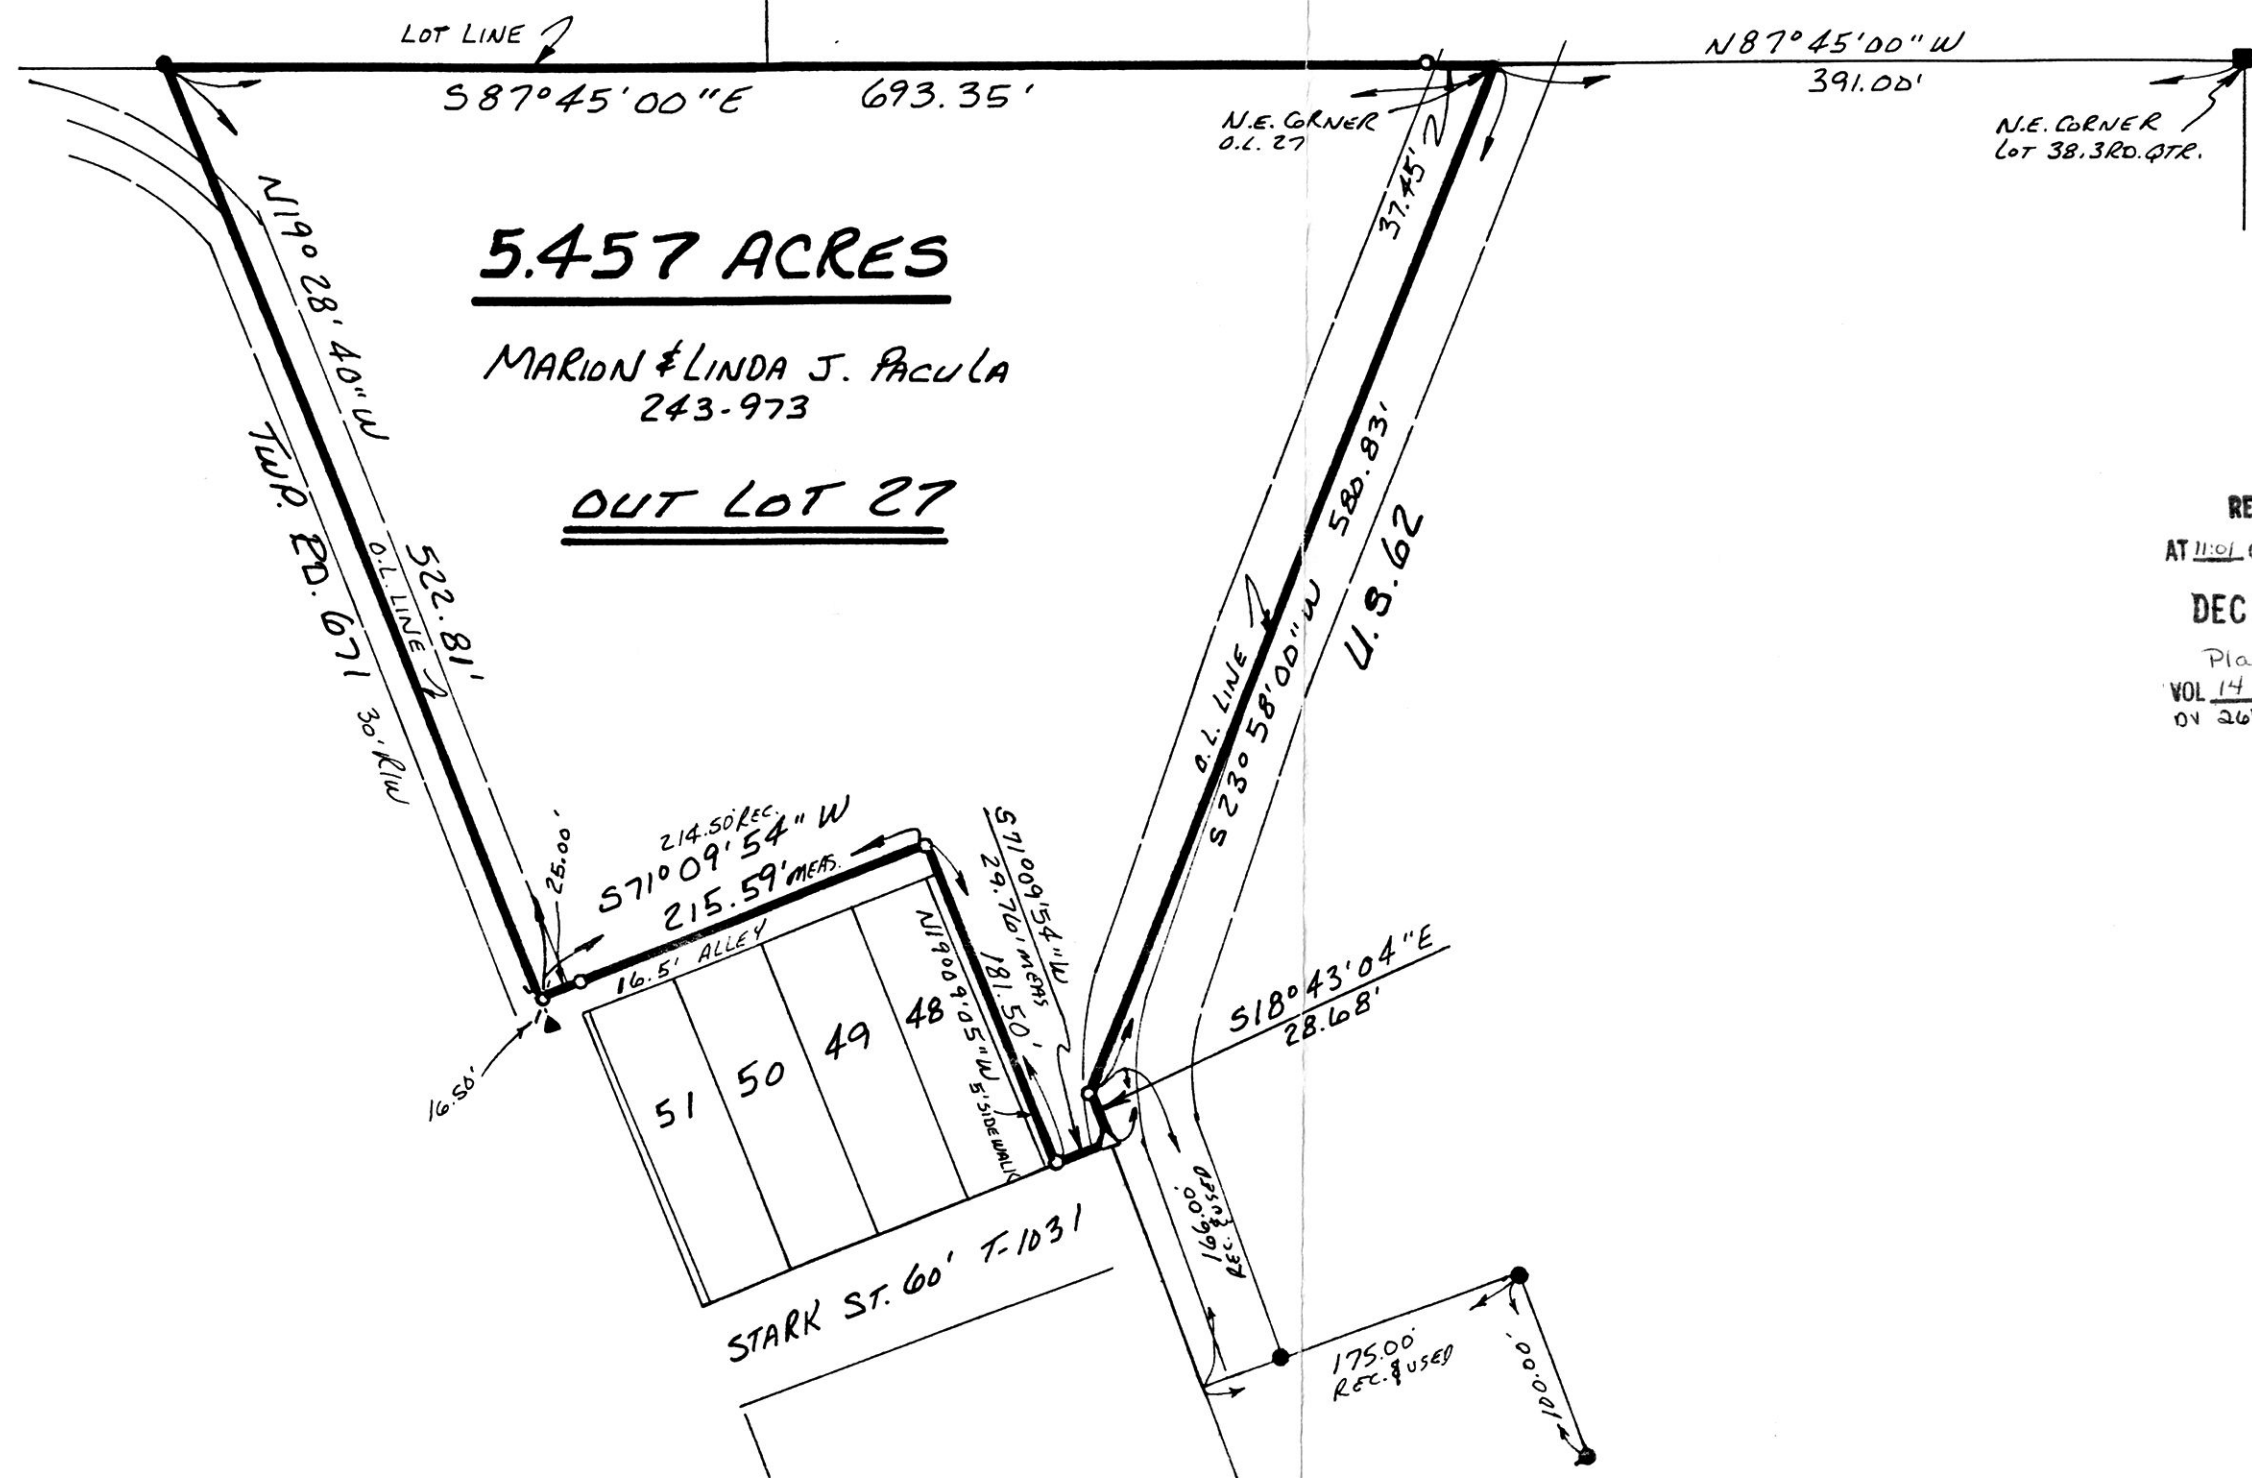

190659


INDEXED

REC'D AT 11:01 o'clock A.M.
DEC 29 '94

RECORDED FEE #20.00
DEC 30 '94

Plat. VOL 14 PAGE 680
04 267-74

Sally Miller RECORDER

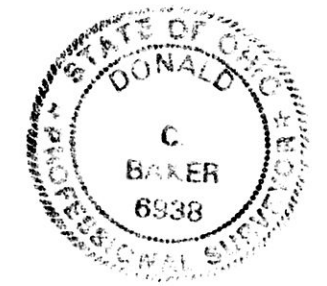

I CERTIFY THIS SURVEY TO BE CORRECT TO THE BEST OF MY KNOWLEDGE.
Donald C. Baker
DONALD C. BAKER P.S. 6938
5958 T.R. 322
MILLERSBURG OHIO 44654
PH. (216) 674-4788
DECEMBER 22, 1994

PLAT APPROVED
12-29-94

68094-MLS