

190706

WALNUT CREEK TOWNSHIP 1ST. QTR., LOT 8, T-9N; R-5W HOLMES COUNTY, OHIO

VOL 14 PAGE 693

0 50 100 200

SCALE: 1" = 100'

■ STONE FOUND

● IRON PIN FOUND

○ 5/8" RE BAR WITH I.D. CAP SET
I.D. CAP MARKED "BAKER 6938"

REFERENCES:

- DEED VOL. 177 PAGE 431
- DEED VOL. 261 PAGE 1017
- DEED VOL. 211 PAGE 340
- PLAT VOL. 10 PAGE 689

BEARINGS FROM PLAT VOL. 9 PAGE 84



940243
 APPROVED FOR TRANSFER ONLY
 NO SUBDIVISION PLAT REQUIRED
 (O.R.C. 711.001 & 711.131)
 Lot(s) not for building unless
 approved by Board of Health.
 HOLMES CO. PLANNING COMM.
 By TRM Date 12-29-94



I CERTIFY THIS SURVEY TO BE CORRECT
TO THE BEST OF MY KNOWLEDGE.

Donald C. Baker
DONALD C. BAKER P.S. 6938

5958 T.R. 322
 MILLERSBURG, OHIO 44654
 PH. (216) 674-4788
 AUGUST 11, 1994
 46194-MLS

190706

REC'D

AT 10:20 clock pm

DEC 30 '94

Plat

VOL 14 PAGE 693
 DV 267 pg 146

RECORDED


FEE \$20.00

JAN 03 '95

RECORDER

Laurel

INDEXED

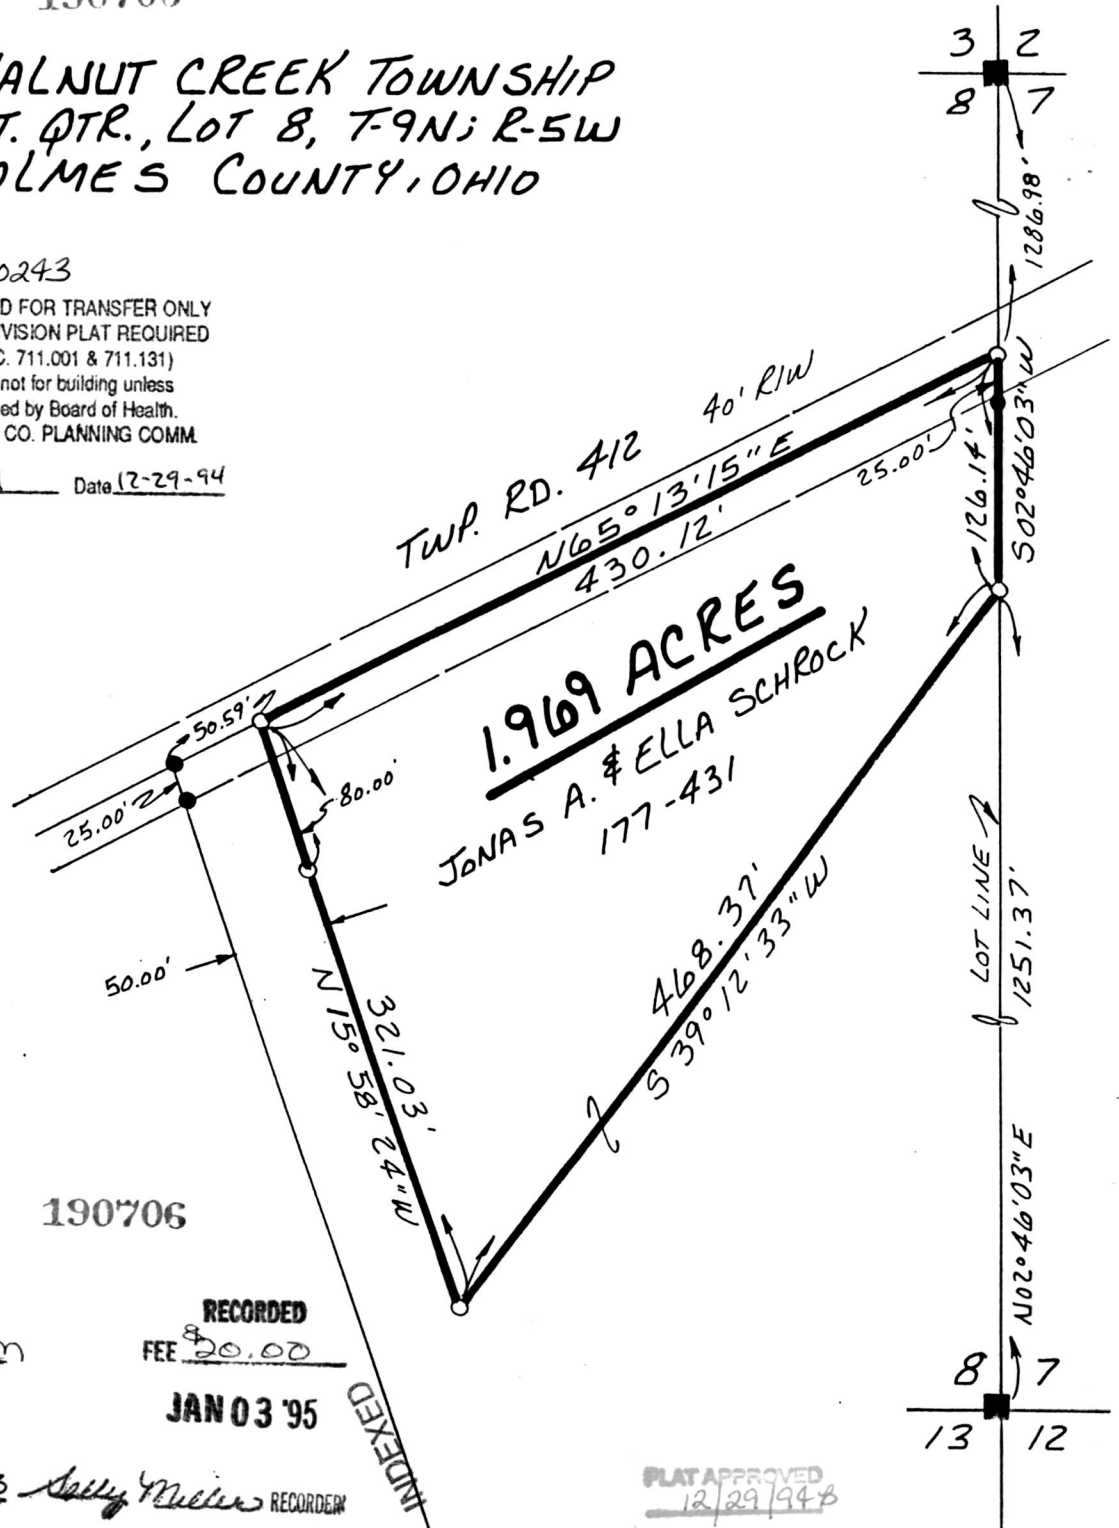

3 2
8 7

8 7
13 12

PLAT APPROVED
12/29/94