


CLARK TOWNSHIP
S.W. QTR. SECTION 14
T-8N ; R-4W
HOLMES COUNTY, OHIO

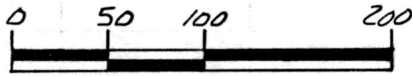


SCALE: 1" = 100'

- IRON PIN FOUND
- 5/8" RE BAR WITH I.D. CAP SET I.D. CAP MARKED "BAKER 6938"

REFERENCES:

- DEED VOL. 244 PAGE 443
- DEED VOL. 189 PAGE 213
- DEED VOL. 202 PAGE 234
- DEED VOL. 243 PAGE 708
- PLAT VOL. 5 PAGE 12
- PLAT VOL. 2 PAGE 130
- PLAT VOL. 7 PAGE 368

BEARINGS FROM PLAT VOL. 2 PG. 130

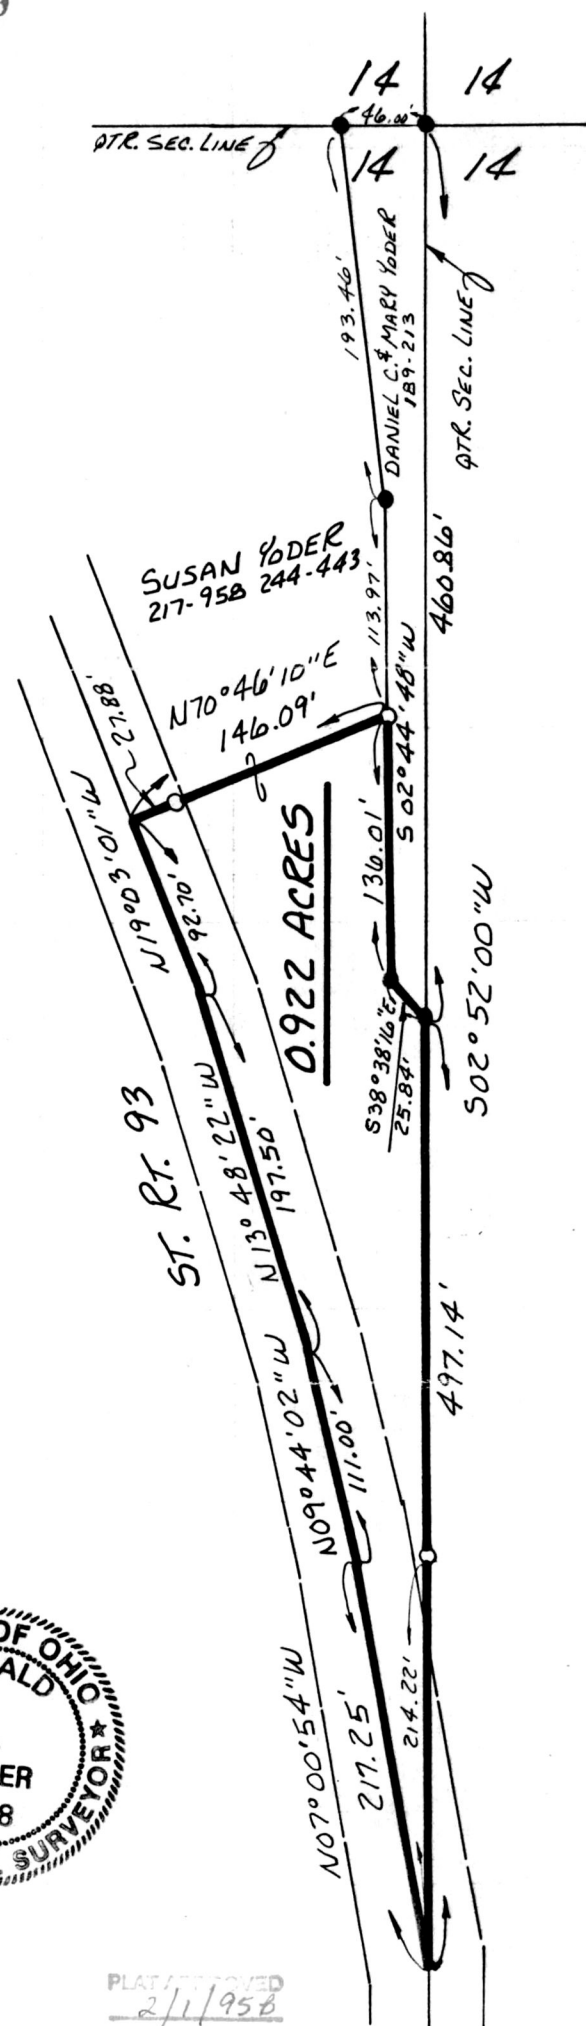

191079

INDEXED

REC'D AT 11:06 o'clock A.M.

RECORDED FEE \$20.00

FEB 01 '95

FEB 02 '95

Plat.
VOL 14 PAGE 720
of 267 pg 474

Sally Miller RECORDER
Jonas P. Miller

I CERTIFY THIS SURVEY TO BE CORRECT TO THE BEST OF MY KNOWLEDGE.

Donald C. Baker
DONALD C. BAKER P.S. 6938
5958 T.R. 322
MILLERSBURG, OHIO 44654
PH (216) 674-4788



AUGUST 10, 1994

45494-MLS

PLAT APPROVED
2/1/95