#20 appd

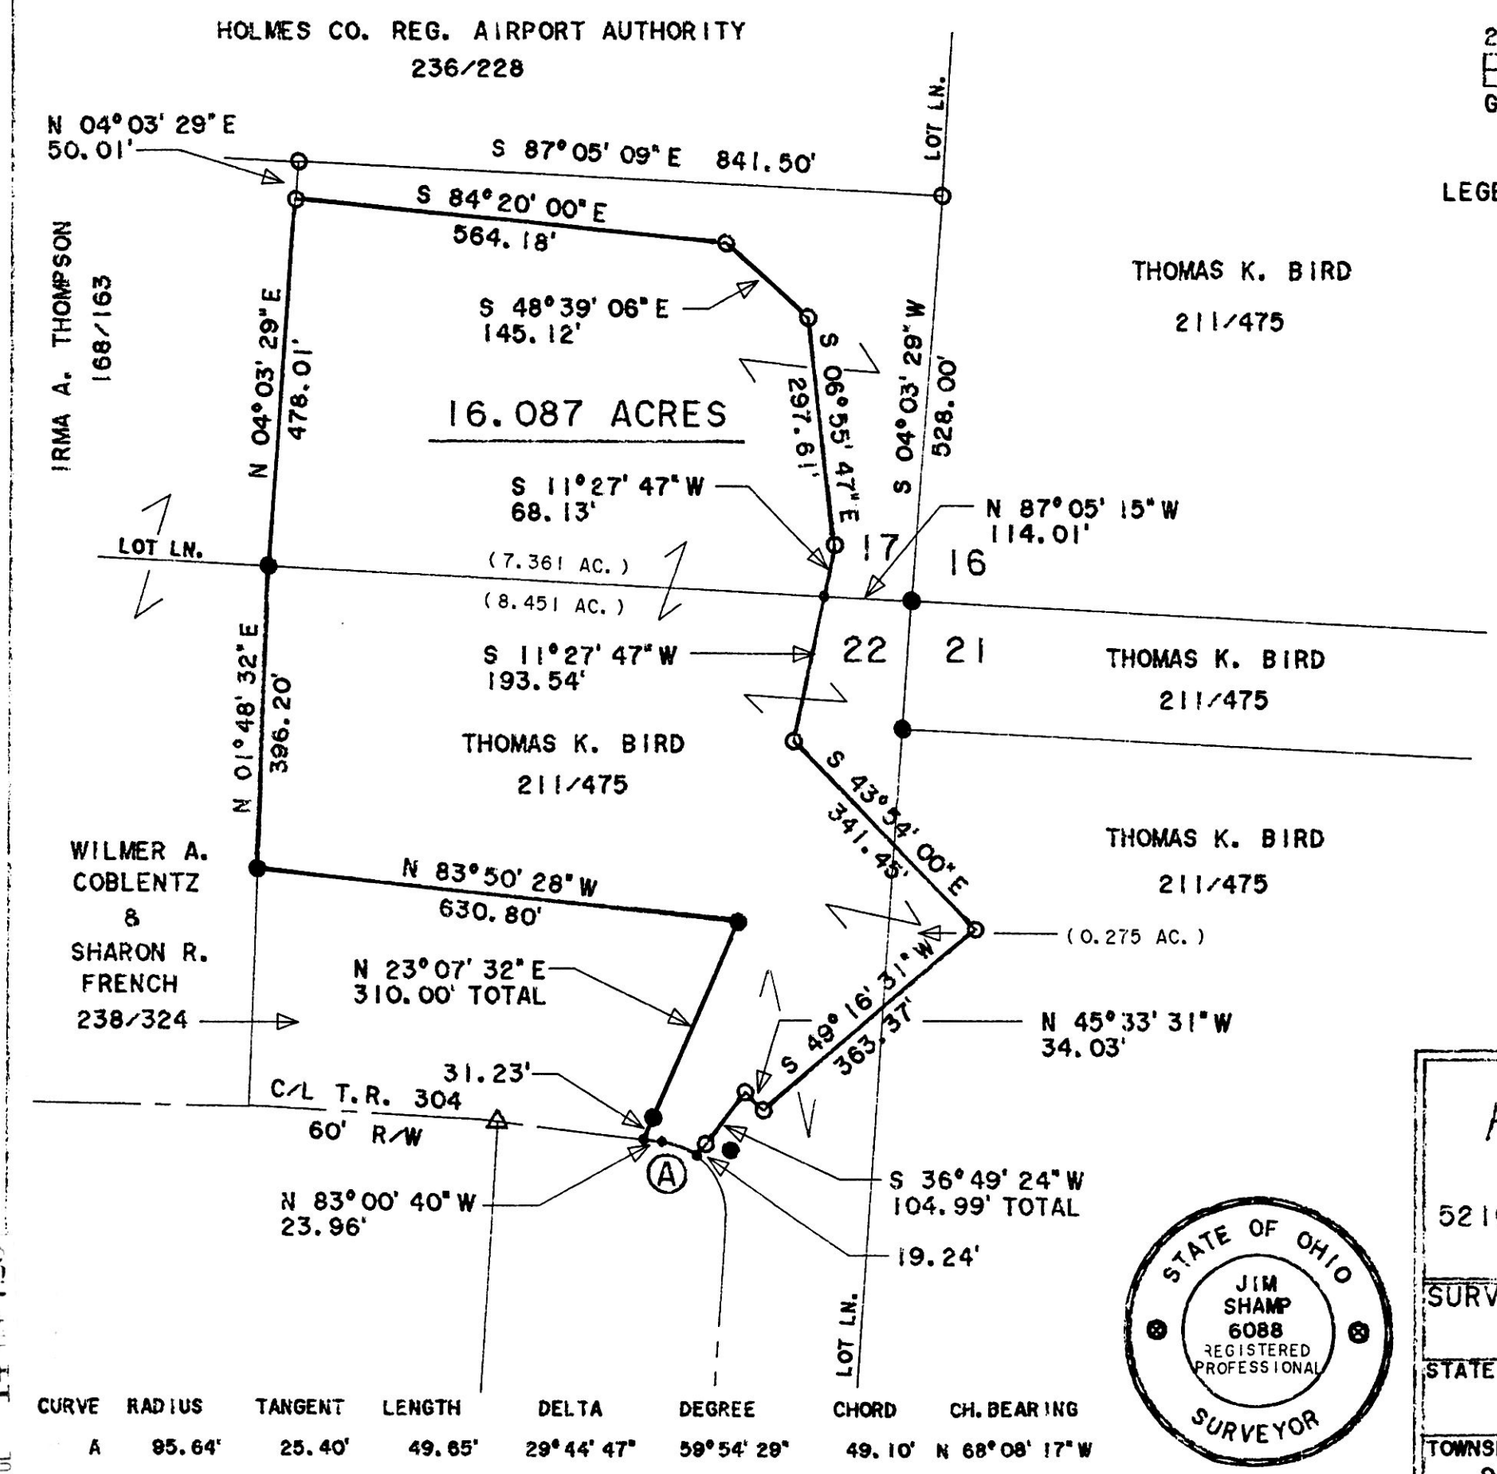

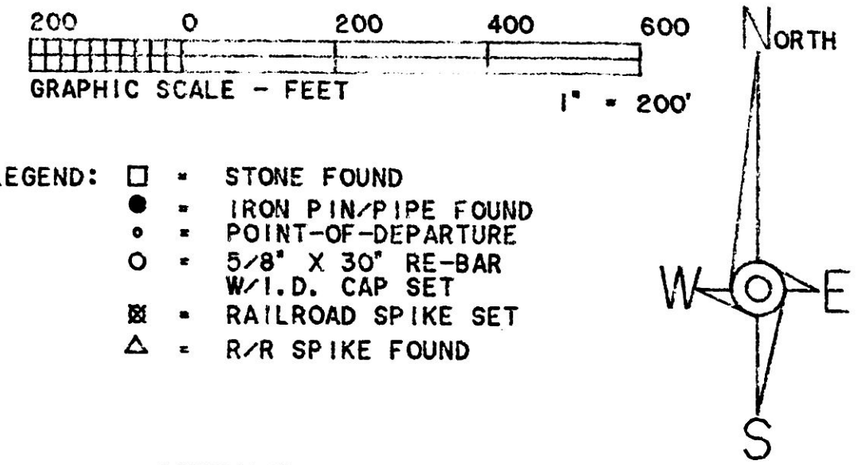

LEGEND:
- □ = STONE FOUND
- ● = IRON PIN/PIPE FOUND
- ⊙ = POINT-OF-DEPARTURE
- ○ = 5/8" X 30" RE-BAR W/I.D. CAP SET
- ⊠ = RAILROAD SPIKE SET
- △ = R/R SPIKE FOUND

REFERENCE DOCUMENTS:
TAX MAP
DEEDS AS SHOWN
SURVEY PLATS:

14/351

BEARINGS EST. FROM PLAT 14/351

SURVEY FOR THOMAS BIRD BY JIM SHAMP DATED 12/06/94 AND ALL DOCUMENTS REFERENCED THEREON.

191182

INDEXED

Rec'd. FEB 09 1995 AT 2:56 O'CLOCK p.m.
Recorded FEB 10 1995 Holmes Co. Ohio Fee #20.00
DV 267-552 Plat Vol. 14 Pg. 726 Recorder, Kelly Miller

I CERTIFY THIS TO BE A TRUE PLAT OF A FIELD SURVEY COMPLETED ON DECEMBER 20, 1994:

JIM SHAMP, REG. SUR. NO. S-6088

STATE OF OHIO
JIM SHAMP
6088
REGISTERED PROFESSIONAL
SURVEYOR

HEARTLAND Surveying
Jim Shamp
5210 Twp. Rd. 257 Millersburg, OH 44654
Phone: 216-674-4698

SURVEY: TOM BIRD			DATE: DECEMBER 21, 1994
STATE: OHIO	COUNTY: HOLMES	TOWNSHIP: HARDY	RANGE: 7 WEST
TOWNSHIP: 9 NORTH	3RD QUARTER LOTS 17, 21, 22		941108.CRD 941231.PL DISK 94/11

VOL 14 PAGE 726

APPROVED 2-9-95 BZ