


VOL 14 PAGE 728


WM. TERRY BURKEY SURVEYING



THOMAS CLARK SURVEY
LOT #34
2ND QTR. TOWNSHIP
TOWNSHIP 9 RANGE 7
HARDY TOWNSHIP
HOLMES COUNTY, OHIO
COMPLETED 3/27/1977

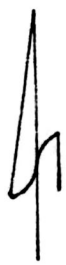


- P. in Set
 - P. in fd.
 - ⊠ Spike Set
 - ⊡ Spike Fd.
- Scale 1" = 100'

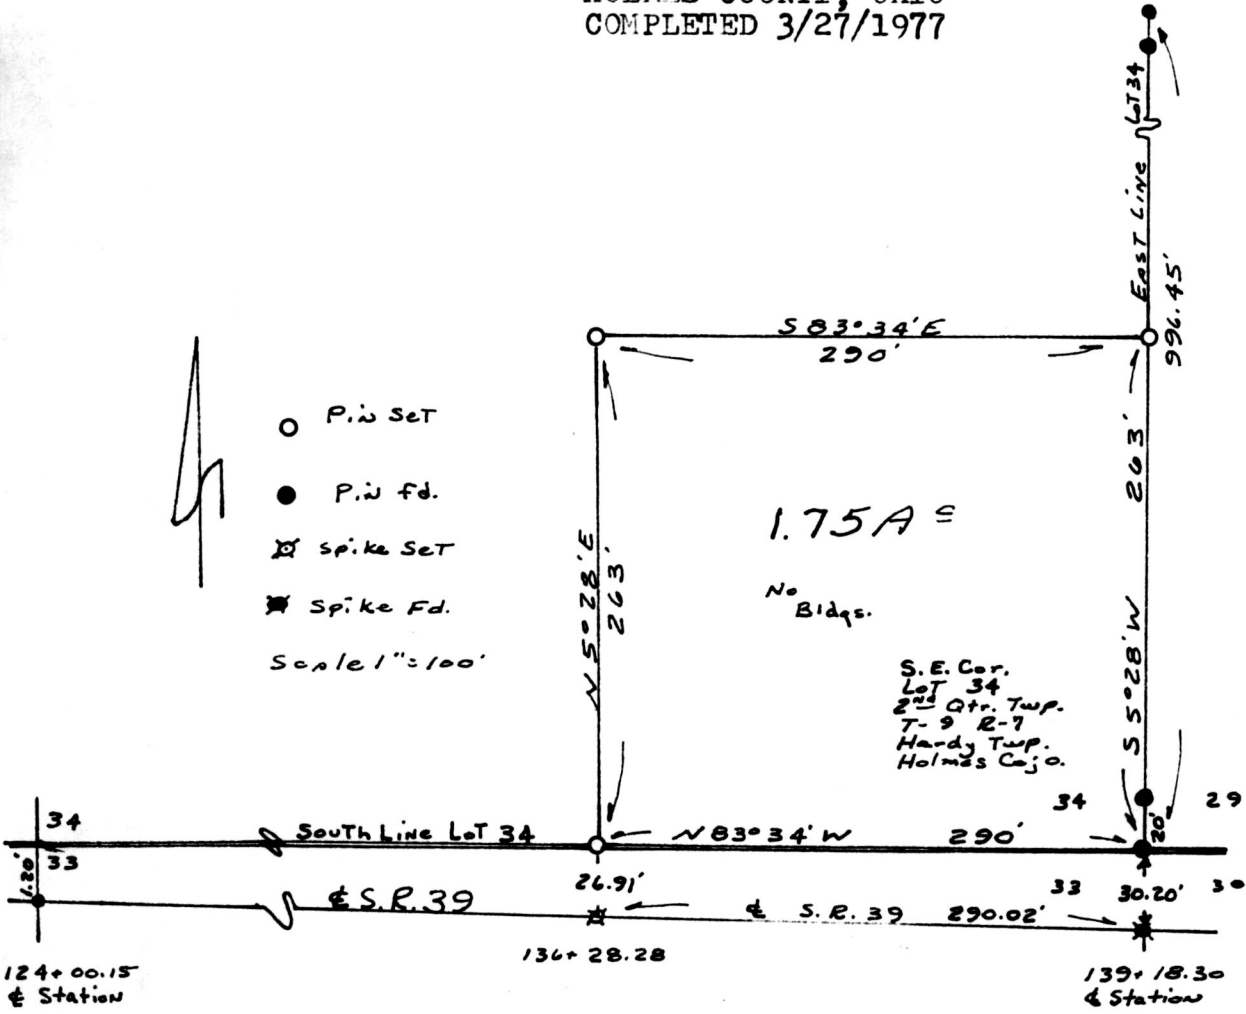

I CERTIFY THIS SURVEY TO BE CORRECT TO THE BEST OF MY KNOWLEDGE AND BELIEF.

SIGNED William T. Burkey
WILLIAM T. BURKEY
REGISTERED SURVEYOR #5107
STATE OF OHIO
191192

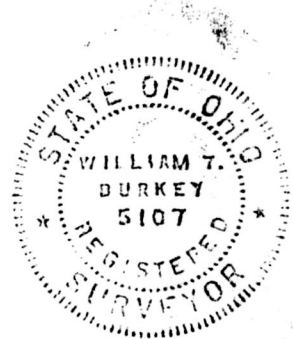

Deed Vol. 267 Page 558

REC'D AT 9:53 o'clock A.M. RECORDED FEE \$20.00

FEB 13 '95 FEB 14 '95

Plat VOL 14 PAGE 728 Sully Miller RECORDER P.R.

INDEXED