
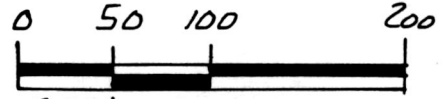


WALNUT CREEK TOWNSHIP
1ST. QTR. LOT 15
T-9N; R-5W
HOLMES COUNTY, OHIO

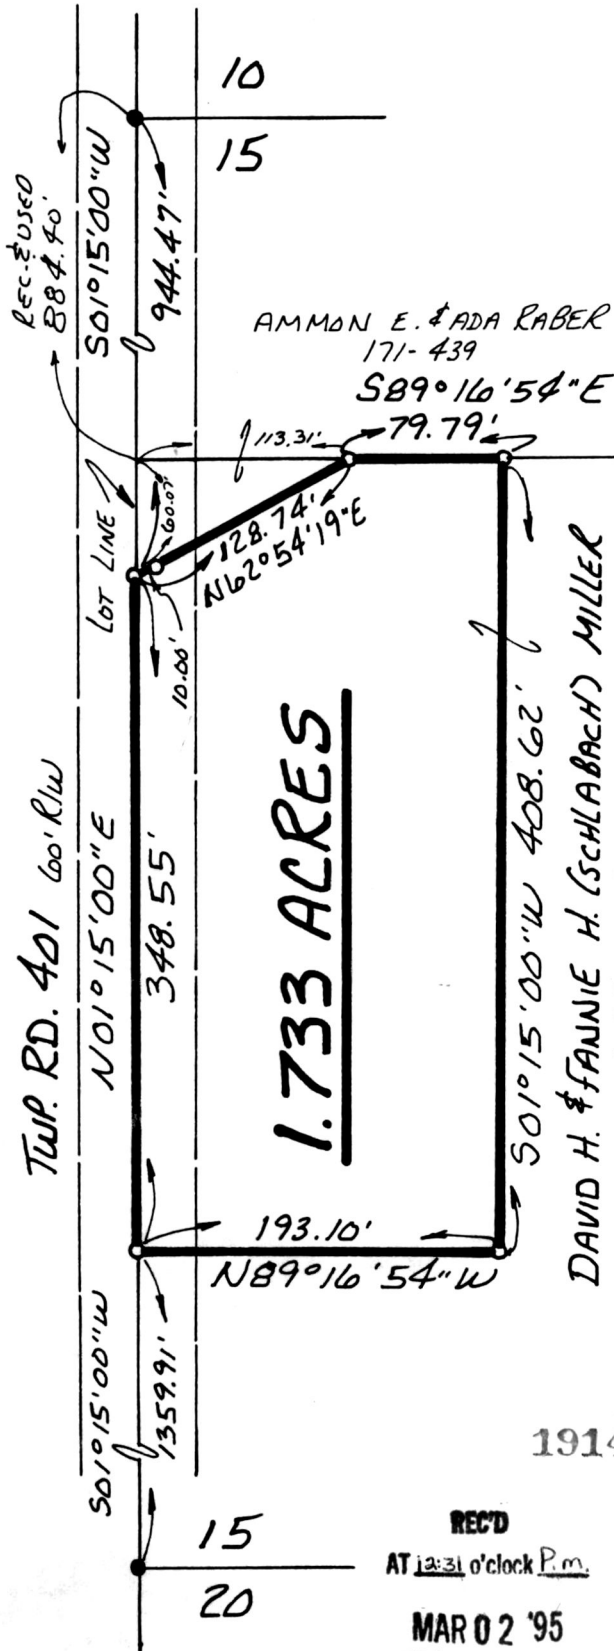

SCALE: 1" = 100'

- IRON PIN FOUND
- 5/8" RE BAR WITH I.D. CAP SET
I.D. CAP MARKED 'BAKER 6938'

REFERENCES:

DEED VOL. 171 PAGE 439
BEARINGS FROM DEED VOL. 249 PAGE 545

950050

APPROVED FOR TRANSFER ONLY
NO SUBDIVISION PLAT REQUIRED
(O.R.C. 711.001 & 711.131)
Lot(s) not for building unless
approved by Board of Health.
HOLMES CO. PLANNING COMM.

By TPM Date 3-1-95



I CERTIFY THIS SURVEY TO BE CORRECT
TO THE BEST OF MY KNOWLEDGE.

Donald C. Baker

DONALD C. BAKER P.S. 6938
5958 T.R. 322

MILLERSBURG, OHIO 44654
PH. (216) 674-4788

DECEMBER 9, 1994

MAR 03 '95

REC'D
AT 12:31 o'clock P.M.

RECORDED
FEE \$20.00

MAR 02 '95

Plat.
VOL 14 PAGE 750
ov 267 page 750

Sally Miller RECORDER

Jaurel

PLAT APPROVED
3/2/95

64694-MLS