

SALT CREEK TOWNSHIP  
 N.W. QTR. SECTION 2  
 T-14N; R-12W  
 HOLMES COUNTY, OHIO

192388

#20.00 pd.



SCALE: 1" = 100'

- STONE FOUND
- IRON PIN FOUND
- △ R.R. SPIKE SET
- 5/8" RE BAR WITH I.D. CAP SET
- I.D. CAP MARKED "BAKER 6938"

REFERENCES:

- DEED Vol. 257 PAGE 884
- " " 261 " 702
- " " 162 " 185
- PLAT Vol. 8 PAGE 836
- " " 12 " 569

BEARINGS FROM PLAT Vol. 5 PAGE 17



REC'D  
 AT 11:06 o'clock A.M.  
 192388

RECORDED  
 FEE \$20.00  
 INDEXED  
 MAY 09 '95  
 MAY 10 '95



950075  
 APPROVED FOR TRANSFER ONLY  
 NO SUBDIVISION PLAT REQUIRED  
 (O.R.C. 711.001 & 711.131)  
 Lot(s) not for building unless  
 approved by Board of Health.  
 HOLMES CO. PLANNING COMM.

Plat.  
 VOL 14 PAGE 794  
 By Sally Miller RECORDER  
D. Mathis

By TEM Date 4-17-95

I CERTIFY THIS SURVEY TO BE CORRECT TO THE BEST OF MY KNOWLEDGE.

Donald C. Baker  
 DONALD C. BAKER P.S. 6938  
 5958 T.R. 322  
 MILLERSBURG, OHIO 44654  
 PH. (216) 674-4788  
 MARCH 13, 1994  
 11195-MCS

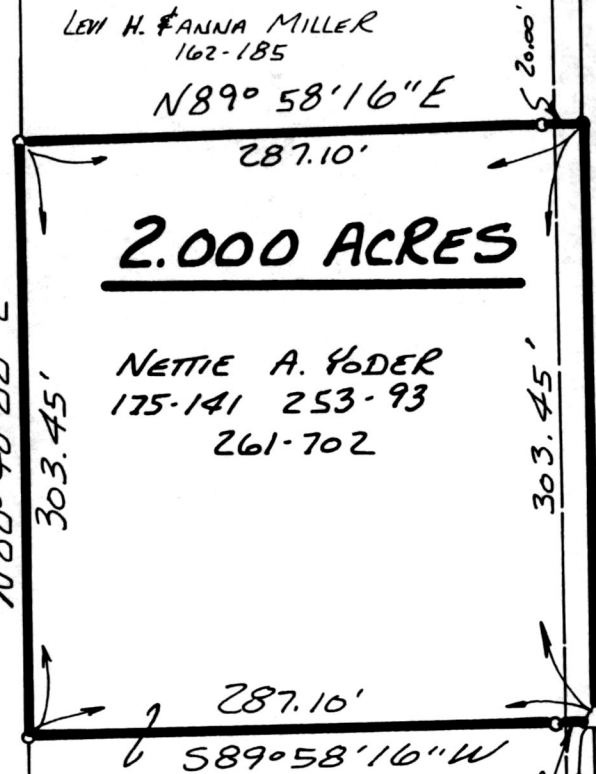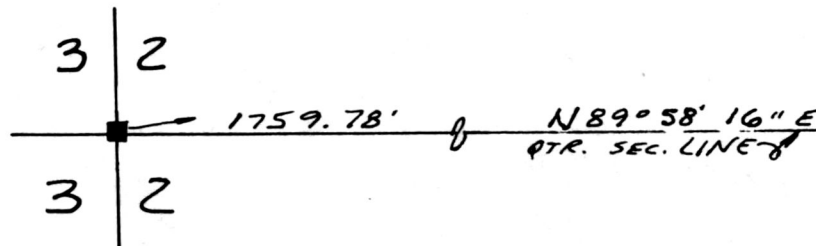

Twp. R. 616 30' R/W

PLAT APPROVED  
 4/18/95 B

VOL 14 PAGE 794