

HARDY TOWNSHIP
2ND. QTA. LOT 24
T-9N; R-7W
HOLMES COUNTY, OHIO





SCALE: 1" = 100'

- ▲ R.R. SPIKE FOUND
- IRON PIN FOUND
- △ R.R. SPIKE SET
- 5/8" REBAR WITH I.D. CAPSET
- I.D. CAP MARKED "BAKER 6938"

REFERENCES:

- DEED VOL. 264 PAGE 210
- DEED VOL. 251 PAGE 625
- DEED VOL. 180 PAGE 243
- PLAT VOL. 5 PAGE 151

BEARINGS FROM DEED VOL. 180 PAGE 243

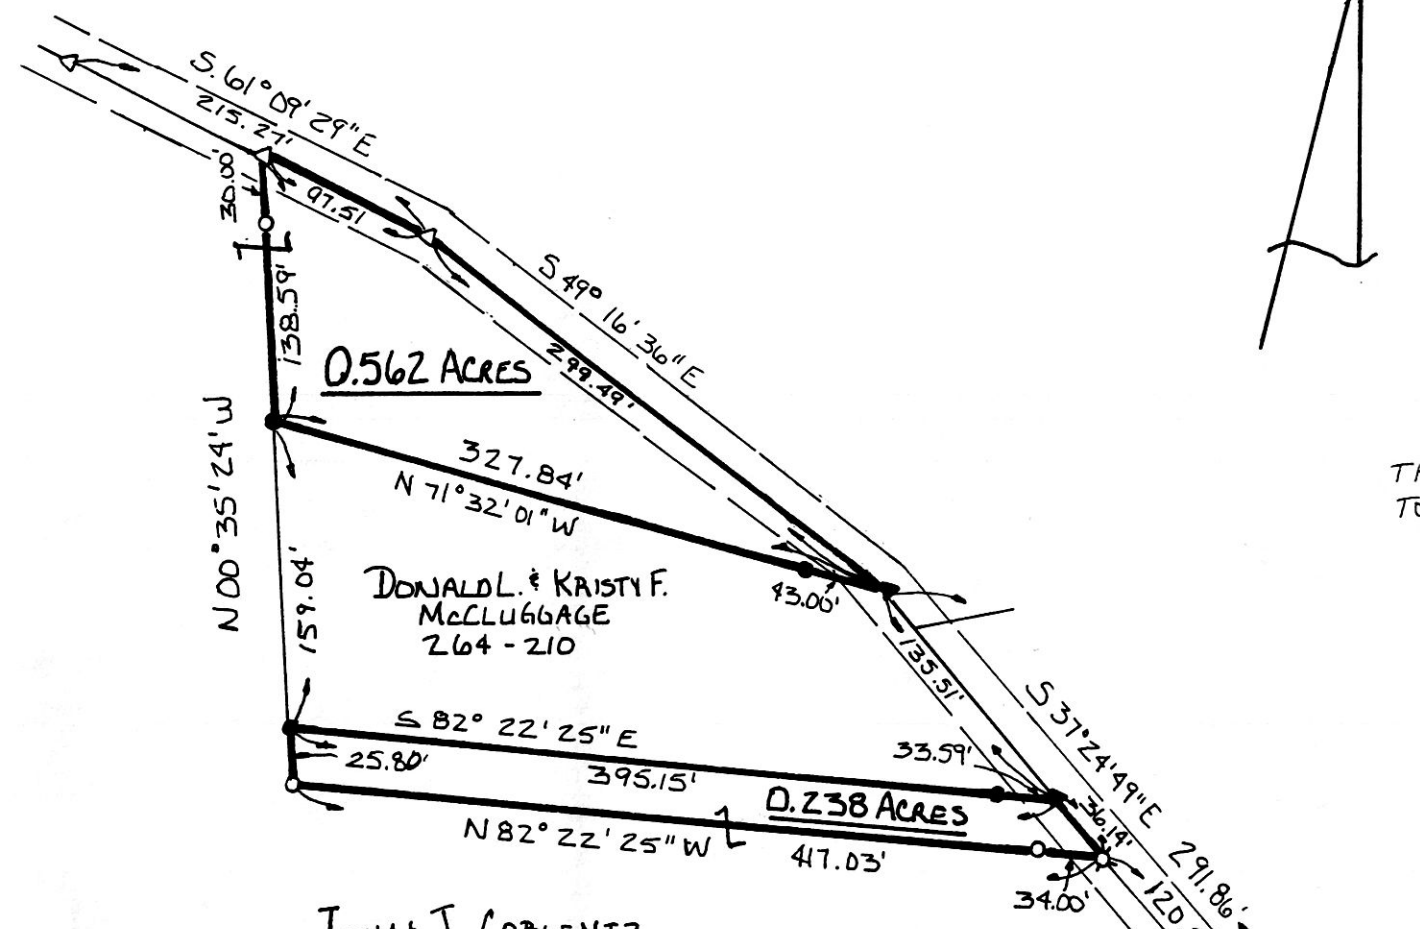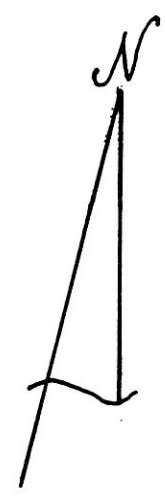

NOTE:
THE 0.562 AC. & 0.238 AC. PARCELS
TO BE ADDED TO McCLUGGAGE

JOHN J. COBLENTZ
251 - 625



I CERTIFY THIS SURVEY TO BE CORRECT
TO THE BEST OF MY KNOWLEDGE.
Donald C. Baker

DONALD C. BAKER P.S. 6938
5958 T.R. 322
MILLERSBURG, OHIO 44654
PH. (216) 674-4788
JUNE 6, 1995

26095 FSM


950118
APPROVED FOR TRANSFER ONLY
NO SUBDIVISION PLAT REQUIRED
(O.R.C. 711.001 & 711.131)
Lot(s) not for building unless
approved by Board of Health.
HOLMES CO. PLANNING COMM.
By TDH Date 6-29-95

193212

REC'D
AT 11:27 o'clock a.m.
JUN 30 '95
Plat
VOL 14 PAGE 840
OV 269 pg 217

RECORDED
FEE \$20.00
JUL 03 '95

Sally Miller RECORDER
Janet

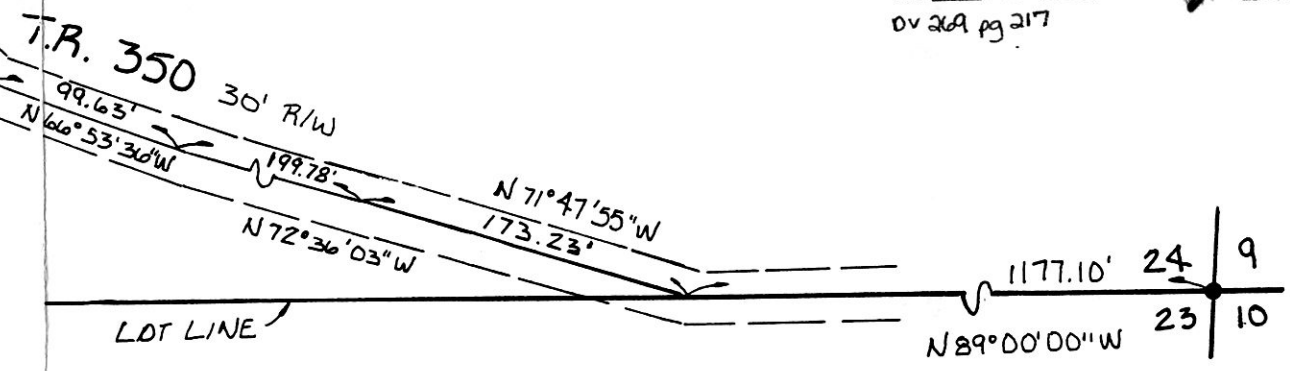

LOT LINE

PLAT APPROVED

6/30/95B