

196092


CLARK TOWNSHIP
N.W. QTR. SECTION 8
T-8N; R-5W
HOLMES COUNTY, OHIO

REFERENCES:

DEED VOL. 161 PAGE 397
" " 259 " 344
" " 149 " 377


PLAT VOL. 14 PAGE 179

BEARINGS FROM PLAT
VOL. 12 PAGE 597

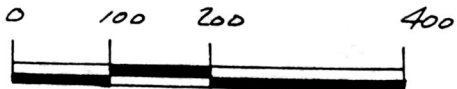

SCALE: 1" = 200'

- IRON PIN FOUND
- 5/8" RE BAR WITH I.D. CAP SET
- I.D. CAP MARKED "BAKER 6938"

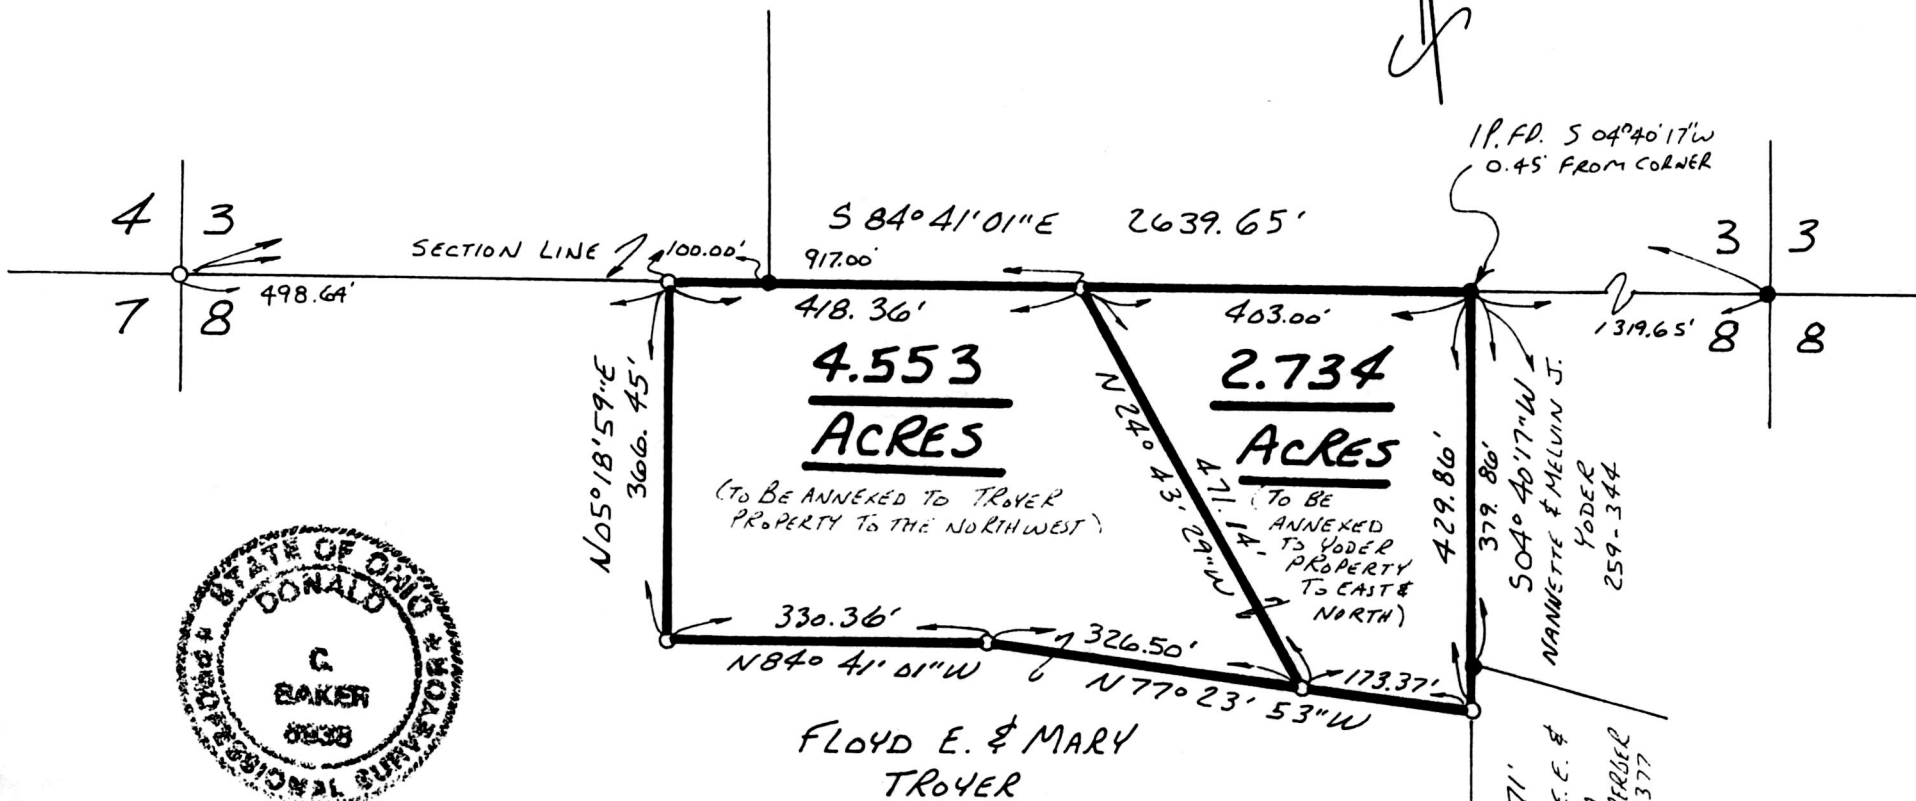

FLOYD E. & MARY
TROYER
161-397

950269
APPROVED FOR TRANSFER ONLY
NO SUBDIVISION PLAT REQUIRED
(O.R.C. 711.001 & 711.131)
Lot(s) not for building unless
approved by Board of Health.
HOLMES CO. PLANNING COMM.

I CERTIFY THIS SURVEY TO BE CORRECT
TO THE BEST OF MY KNOWLEDGE.

Donald C. Baker
DONALD C. BAKER P.S. 6938
5958 T.R. 322
MILLERSBURG, OHIO 44654
PH. (216) 674-4788

196092

DECEMBER 1, 1995
65095-MLS

Recorded Jan 2, 1996 AT 4:13 O'CLOCK PM By TRM Date 1-2-96
Recorded Jan 3, 1996 Holmes Co. Ohio Fee: \$20.00
Plat Vol. 14 Pg. 996 Recorder Jacey Miller
DV 271 pg 559 INDEXED

PLAT APPROVED

1/2/96 B-

VOL 14 PAGE 996

VOL