



SCALE: 1"=100'

- ▲ R.R. SPIKE FOUND
- IRON PIN FOUND
- △ R.R. SPIKE SET
- 5/8" REBAR WITH I.D. CAP SET
- I.D. CAP MARKED "BAKER 6938"




RIPLEY TOWNSHIP  
S.W. QTR. SECTION 3  
T-17N; R-14W  
HOLMES COUNTY, OHIO

9600000374  
Filed for Record in  
HOLMES COUNTY, OH  
SALLY MILLER  
On 04-01-1996 At 12:15 pm.  
PLSM 20.00  
Vol. 16 Page 62  
DV 272 pg 841

REFERENCES:  
DEED Vol. 214 PAGE 218  
" " 263 " 612  
" " 219 " 592  
  
PLAT Vol. 8 PAGE 220  
" " 10 " 99  
" " 10 " 349

BEARINGS FROM DEED  
Vol. 219 PAGE 592.

INDEXED

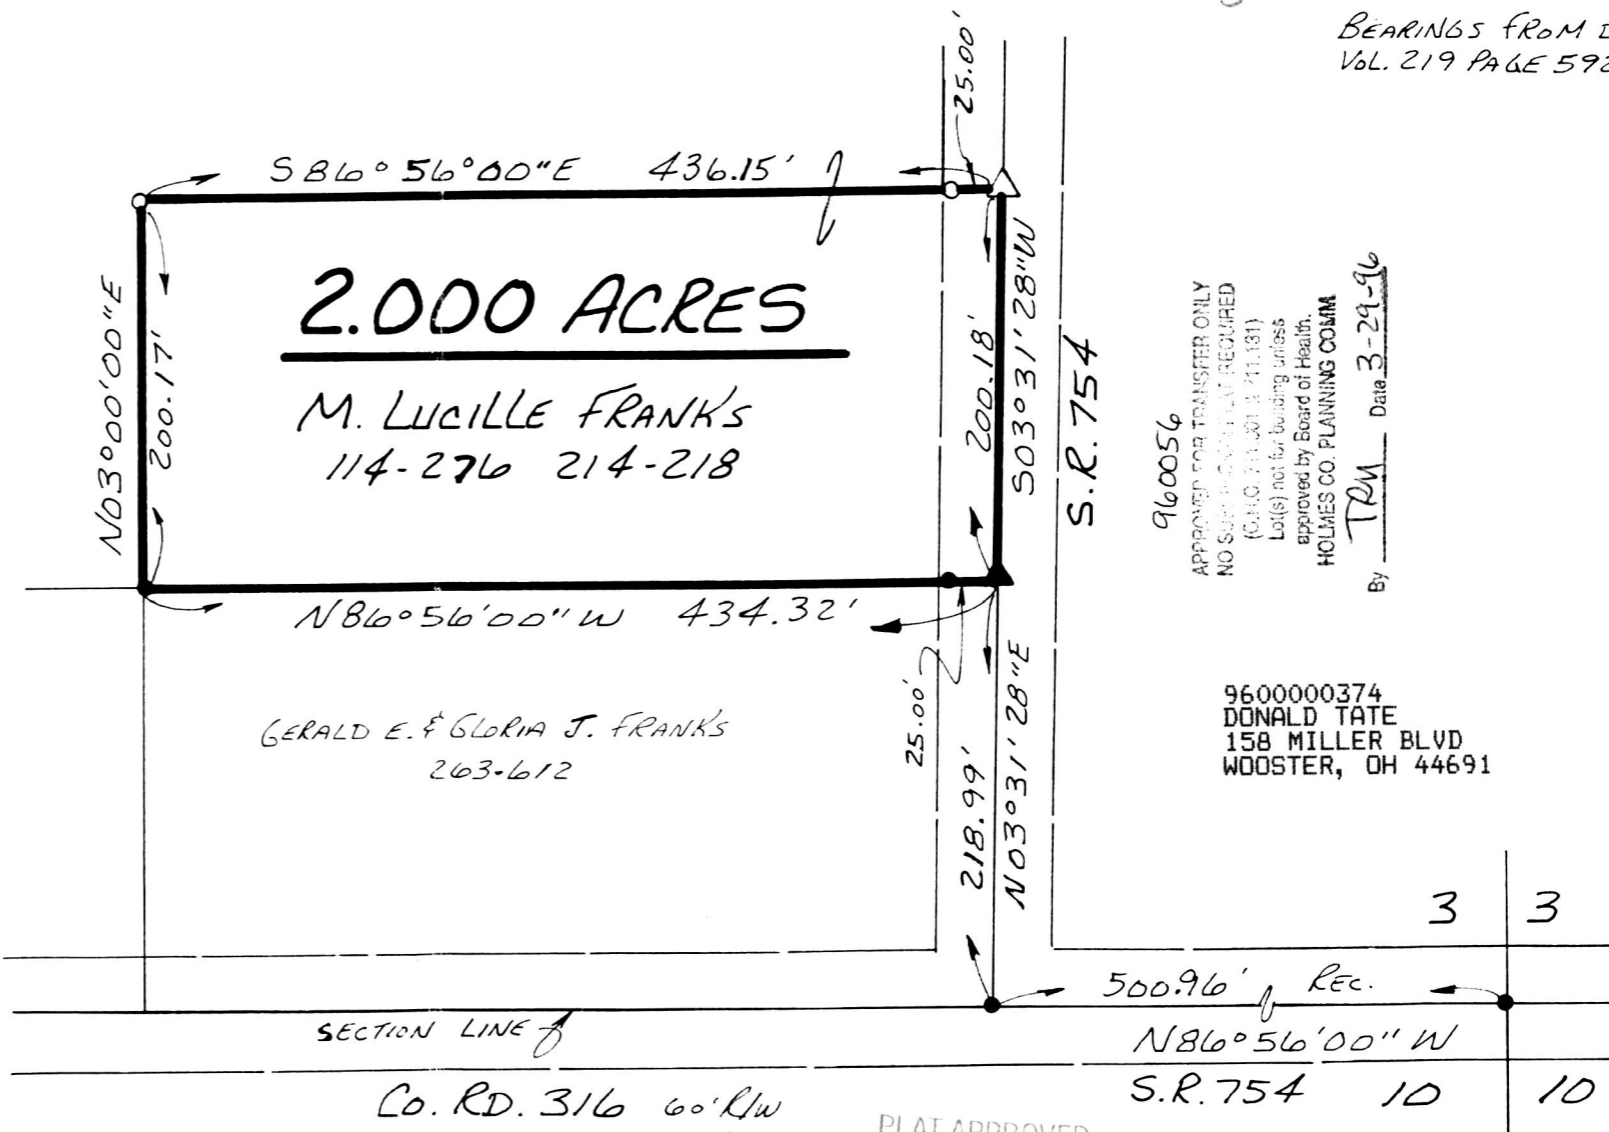

960056  
APPROVED FOR TRANSFER ONLY  
NO SURVEYOR'S PLAT REQUIRED  
(C.H.C. 711.01 & 711.011)  
Lot(s) not for binding unless  
approved by Board of Health.  
HOLMES CO. PLANNING COMM  
By TRM Date 3-29-96

9600000374  
DONALD TATE  
158 MILLER BLVD  
WOOSTER, OH 44691

I CERTIFY THIS SURVEY TO BE CORRECT  
TO THE BEST OF MY KNOWLEDGE.

Donald C. Baker

DONALD C. BAKER P.S. 6938

5958 T.R. 322

MILLERSBURG, OHIO 44654

PH. (216) 674-4788

MARCH 7, 1996

VOL 16 PAGE 62

12596-MLS

PLAT APPROVED

4/1/96