

VOIL 16 PAGE 97

VOIL 16 PAGE 97

9600001245
Filed for Record in
HOLMES COUNTY, OH
SALLY MILLER
On 05-13-1996 At 01:53 pm.
PLSM 20.00
Vol. 16 Page 97
DV 273pg475

HARDY TOWNSHIP 2ND. QTR. LOT 24 T-9N; R-7W HOLMES COUNTY, OHIO



SCALE: 1" = 100'

- ▲ R.R. SPIKE FOUND
- IRON PIN FOUND
- ⊙ R.R. SPIKE SET
- 5/8" REBAR WITH ID. CAP SET
- ID. CAP MARKED "BAKER 6938"


INDEXED

1.567 ACRES

JACOB R. & FRED A COBLENTZ
180-243
238-860
257-985

REFERENCES:

DEED	VOL. 257	PAGE 985
DEED	VOL. 272	PAGE 453
DEED	VOL. 251	PAGE 625
DEED	VOL. 264	PAGE 210
DEED	VOL. 269	PAGE 217
PLAT	VOL. 14	PAGE 88
PLAT	VOL. 5	PAGE 151

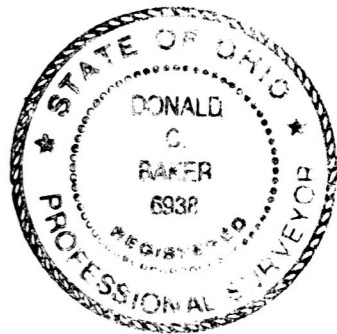




960083
APPROVED FOR TRANSFER ONLY
NO SUBDIVISION PLAT REQUIRED
(O.R.C. 711.001 & 711.131)
Lot(s) not for building unless
approved by Board of Health.
HOLMES CO. PLANNING COMM.

By TRM Date 5-10-96

I CERTIFY THIS SURVEY TO BE
CORRECT TO THE BEST OF MY
KNOWLEDGE.

Donald C. Baker
DONALD C. BAKER P.S. 6938
5958 T.R. 322
MILLERSBURG, OHIO 44654
PH. (330) 674-4788
APRIL 23, 1996

BEARINGS FROM DEED VOL. 257 PAGE 985

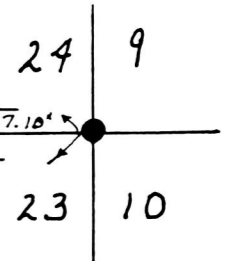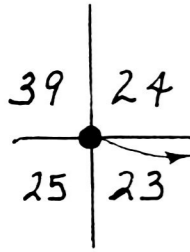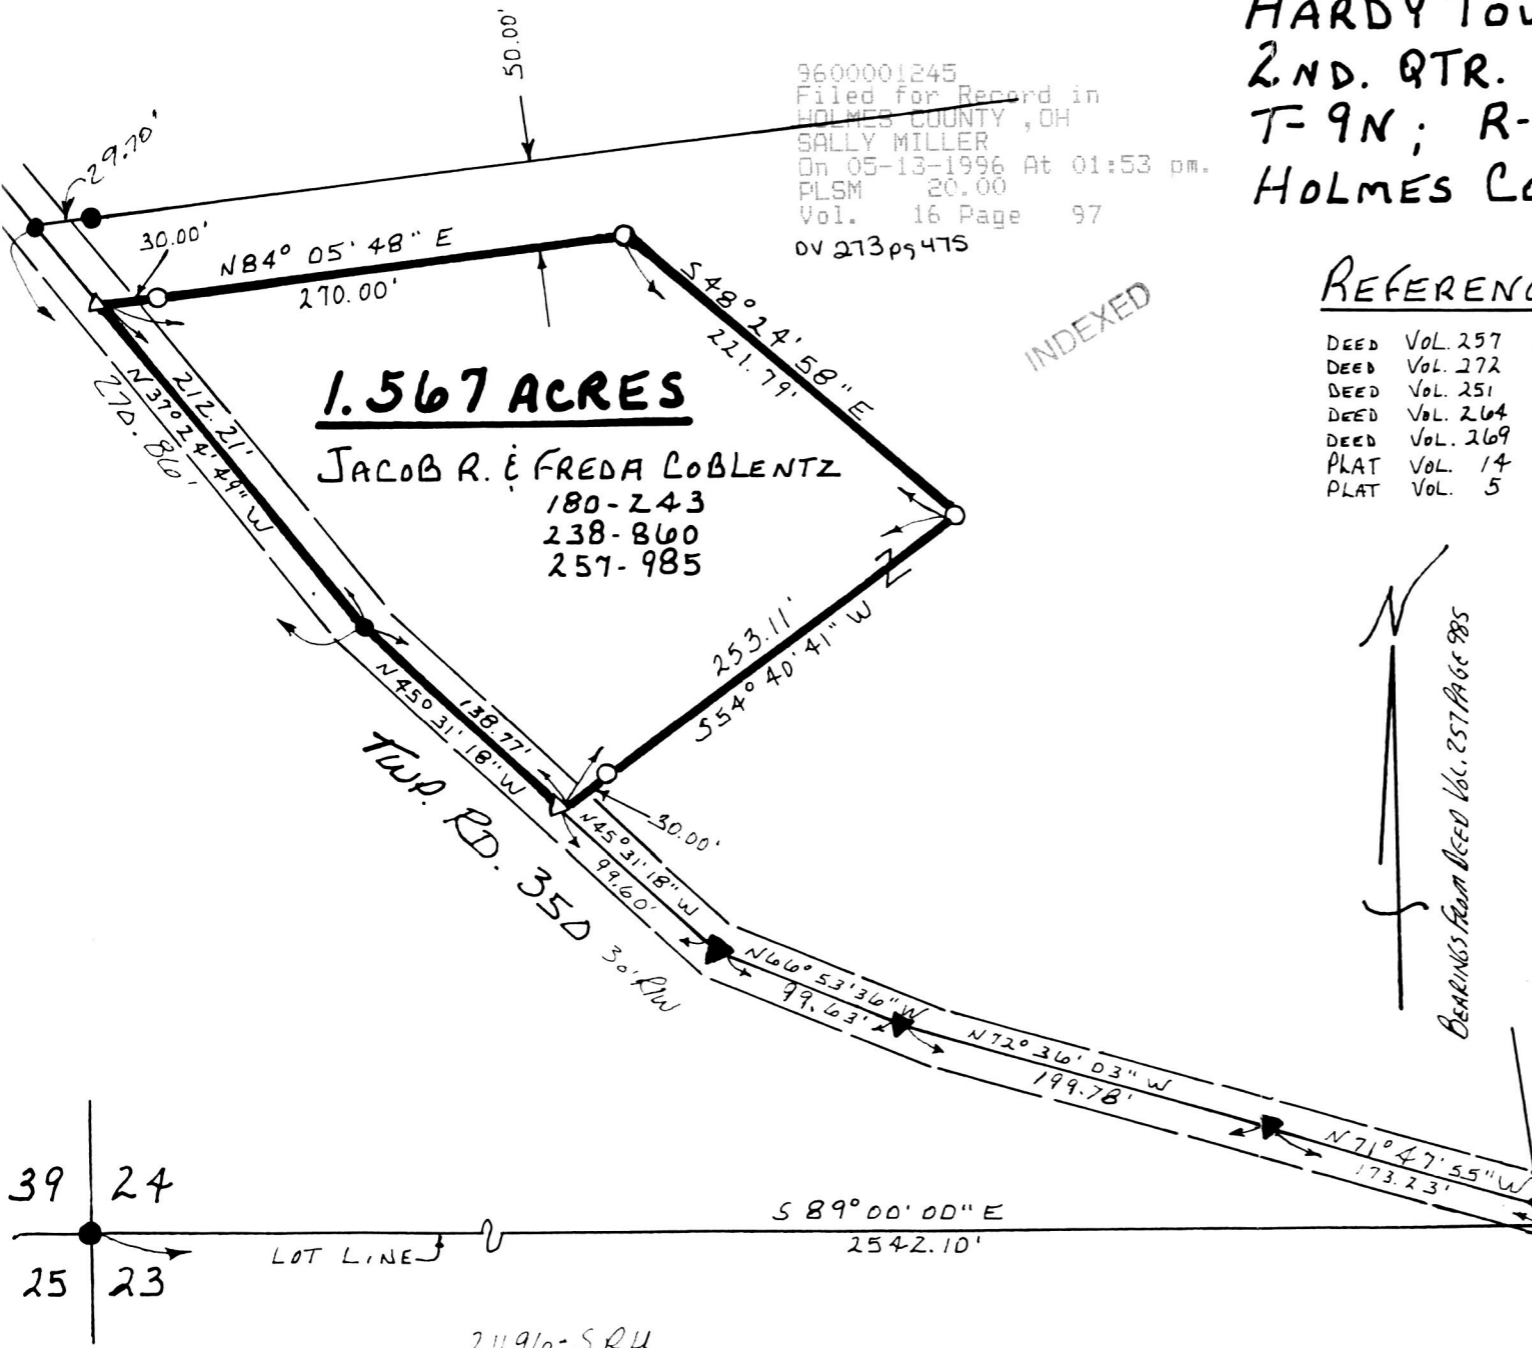

21196-SRU

PLAT APPROVED

5/13/96-B

9600001245
Laurel Hines, Atty
MILLERSBURG,