


SCALE: 1" = 200'

- IRON PIN FOUND
- 5/8" REBAR WITH ID. CAP SET
- ID. CAP MARKED "BAKER 6938"

CLARK TOWNSHIP
S.W. QTR. SECTION 10
T-8N; R-5W
HOLMES COUNTY, OHIO

SURVEYED FOR: AMOS YODER

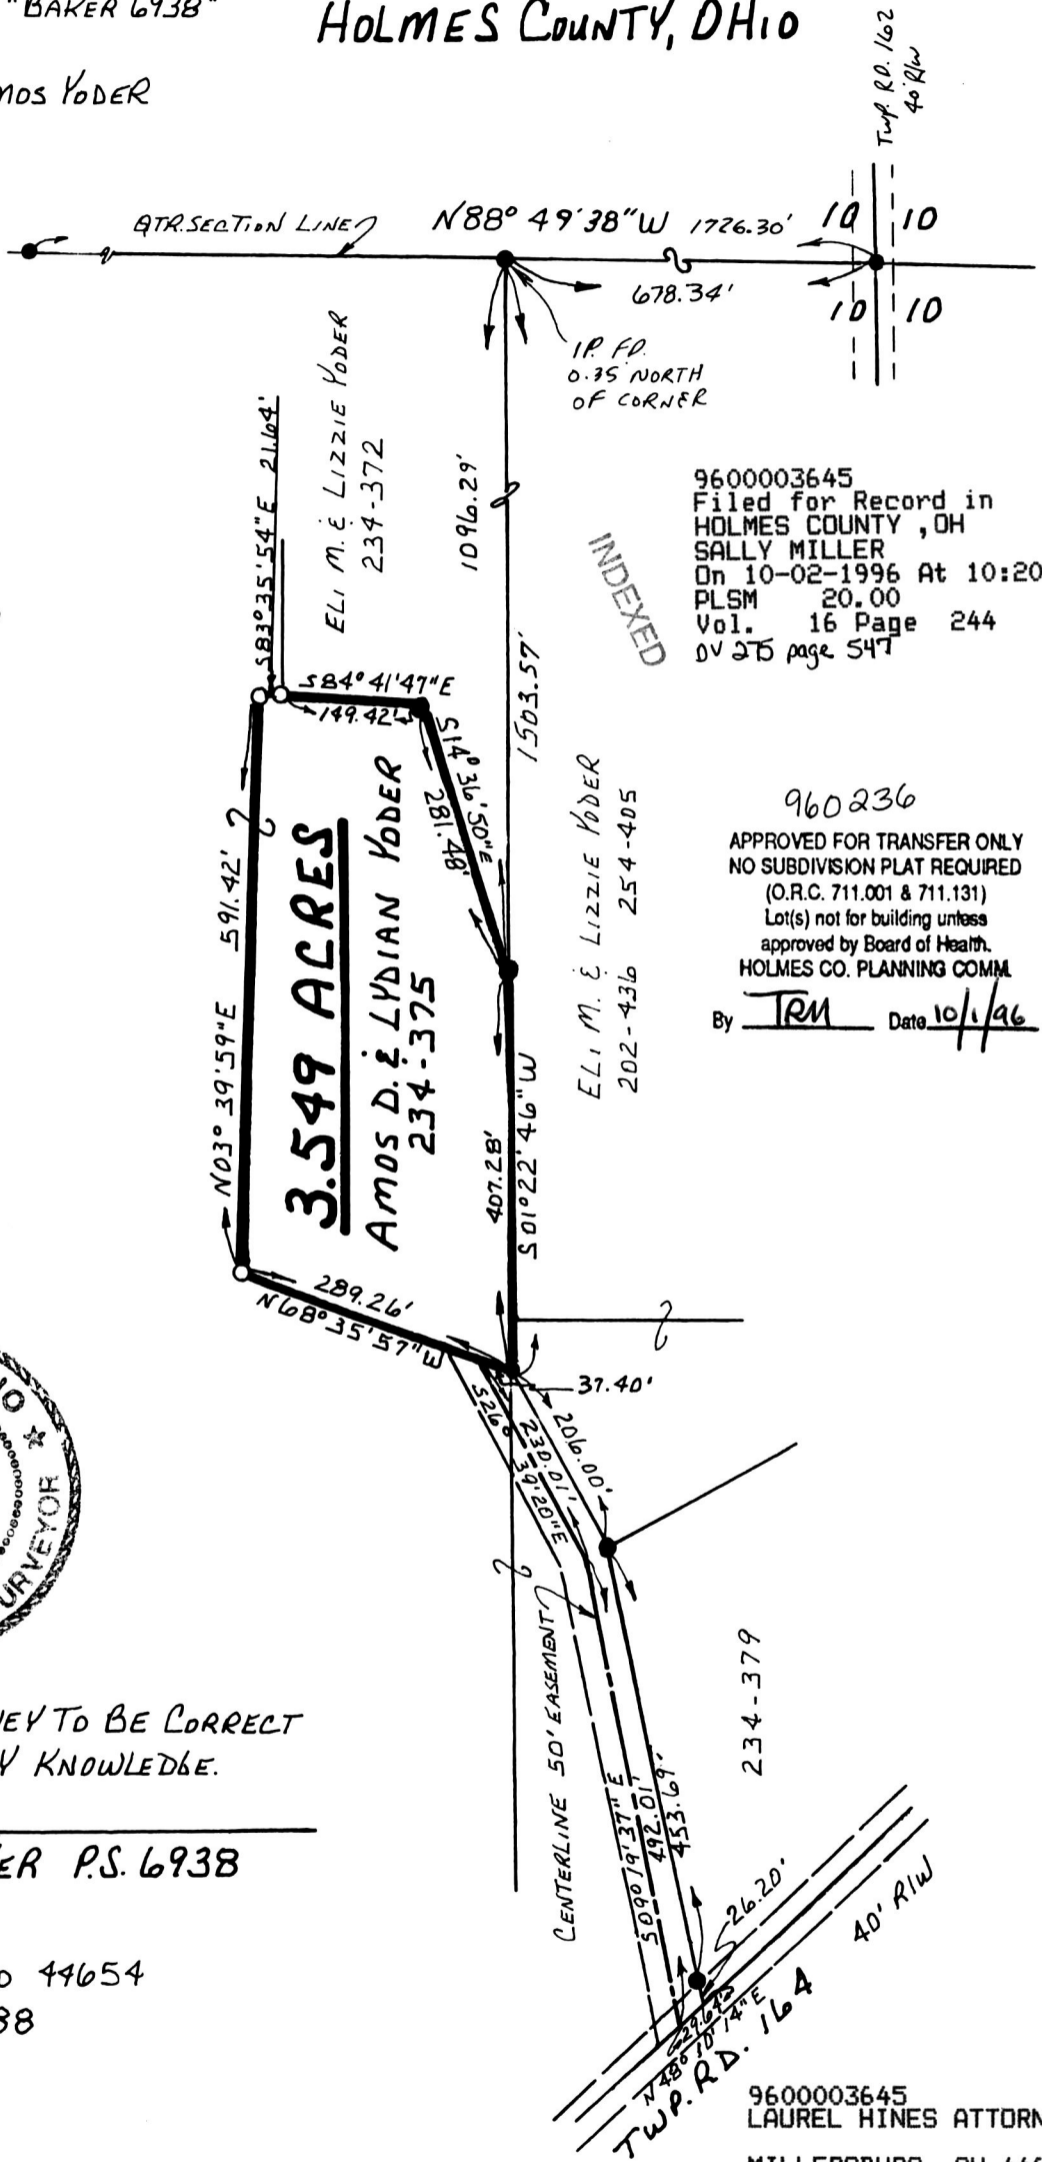

REFERENCES:

- DEED VOL. 234 PAGE 375
- DEED VOL. 234 PAGE 372
- DEED VOL. 202 PAGE 436
- DEED VOL. 254 PAGE 405
- DEED VOL. 234 PAGE 379

9600003645
Filed for Record in
HOLMES COUNTY, OH
SALLY MILLER
On 10-02-1996 At 10:20 am.
PLSM 20.00
Vol. 16 Page 244
DV 275 page 547


INDEXED

960236

APPROVED FOR TRANSFER ONLY
NO SUBDIVISION PLAT REQUIRED
(O.R.C. 711.001 & 711.131)
Lot(s) not for building unless
approved by Board of Health.
HOLMES CO. PLANNING COMM

By TRM Date 10/1/96

BEARINGS FROM PLAT VOL. 11 PAGE 138

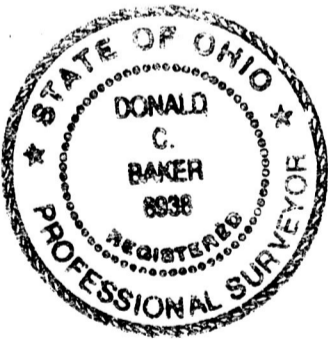

I CERTIFY THIS SURVEY TO BE CORRECT TO THE BEST OF MY KNOWLEDGE.

Donald C. Baker
DONALD C. BAKER P.S. 6938
5958 T.R. 322

MILLERSBURG, OHIO 44654
PH. (330) 674-4788
JULY 9, 1996

37996-SRU

9600003645
LAUREL HINES ATTORNEY
MILLERSBURG, OH 44654

PLAT APPROVED

10/1/96