


SALT CREEK TOWNSHIP
 N.E. QTR. SECTION 6
 T-14N; R-12W
 HOLMES COUNTY, OHIO

SURVEYED FOR: MARY BARKMAN

RESURVEY OF DEED VOL. 256 PAGE 20

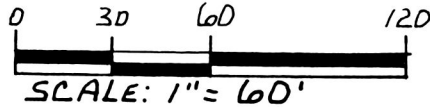


- IRON PIN FOUND
- △ R.R. SPIKE SET
- 5/8" REBAR WITH ID. CAP SET
ID. CAP MARKED "BAKER 693B"

REFERENCES:
 DEED VOL. 256 PAGE 20
 DEED VOL. 246 PAGE 341

9600004205
 Filed for Record in
 HOLMES COUNTY, OH
 SALLY MILLER
 On 11-04-1996 At 01:11 pm.
 PLSM 20.00
 Vol. 16 Page 268
 DV 275 page 14

INDEXED

BEARINGS FROM DEED VOL. 256 PAGE 20

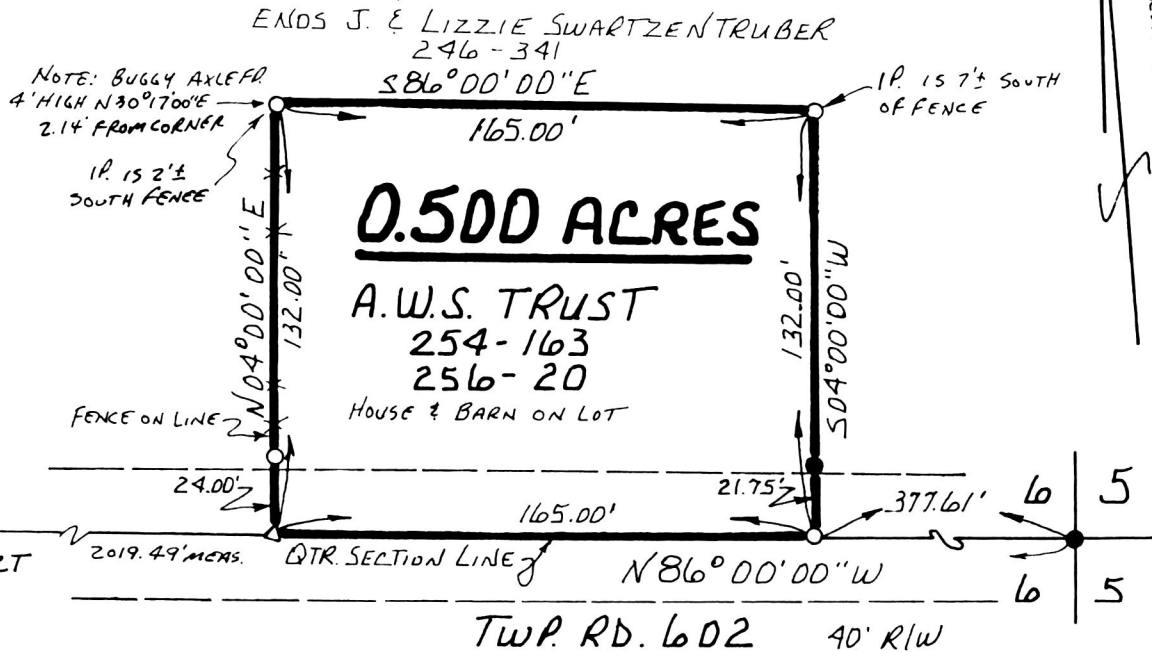

I CERTIFY THIS SURVEY TO BE CORRECT
 TO THE BEST OF MY KNOWLEDGE.

Donald C. Baker

DONALD C. BAKER P.S. 6938
 5958 T.R. 322
 MILLERSBURG, OHIO 44654
 PH. (330) 674-4788
 SEPTEMBER 24, 1996
 .55396 SRU

NOTE:

S.R. 5 PAGE 48 (DATED: 1838) SHOWS A 1/2 AC. TRACT S.P. 341. NORTH OF QTR. SEC. LINE
 THE 1/2 AC. TRACT IN DEED VOL. 254 PG. 163 IS A DIFFERENT 1/2 AC. TRACT
 & CALLS OUT THE SOUTH LINE AS BEING IN THE CENTER OF A 40' ROAD

PLAT APPROVED

9600004205
 BLAIR BOWER ATTORNEY
 MILLERSBURG, OH 44654

11/1/96