


HARDY TOWNSHIP  
2ND. QTR. LOT 16  
3RD. QTR. LOT 3  
T-9N; R-7W  
HOLMES COUNTY, OHIO

9600004712  
Filed for Record in  
HOLMES COUNTY, OH  
SALLY MILLER  
On 12-12-1996 At 01:31 pm.  
PLSM 20.00  
Vol. 16 Page 303  
Dv 276 page 450

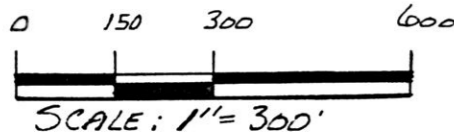

- HIGHWAY MONUMENT FOUND
- IRON PIN FOUND
- 5/8" RE BAR WITH I.D. CAP SET  
I.D. CAP MARKED "BAKER 6938"
- ▲ R.B. SPIKE FOUND R.U. RECORD & USED

REFERENCES:

DEED Vol. 269 PAGE 264  
" " 246 " 901  
" " 185 " 434

PLAT Vol. 5 PAGE 85  
" " 8 " 772  
" " 4 " 608  
" " 6 " 11




I CERTIFY THIS SURVEY TO BE CORRECT  
TO THE BEST OF MY KNOWLEDGE.

Donald C. Baker  
DONALD C. BAKER P.S. 6938  
5958 T.R. 322  
MILLERSBURG, OHIO 44654

PH. (330) 674-4788

OCTOBER 14, 1996

59296-MLD

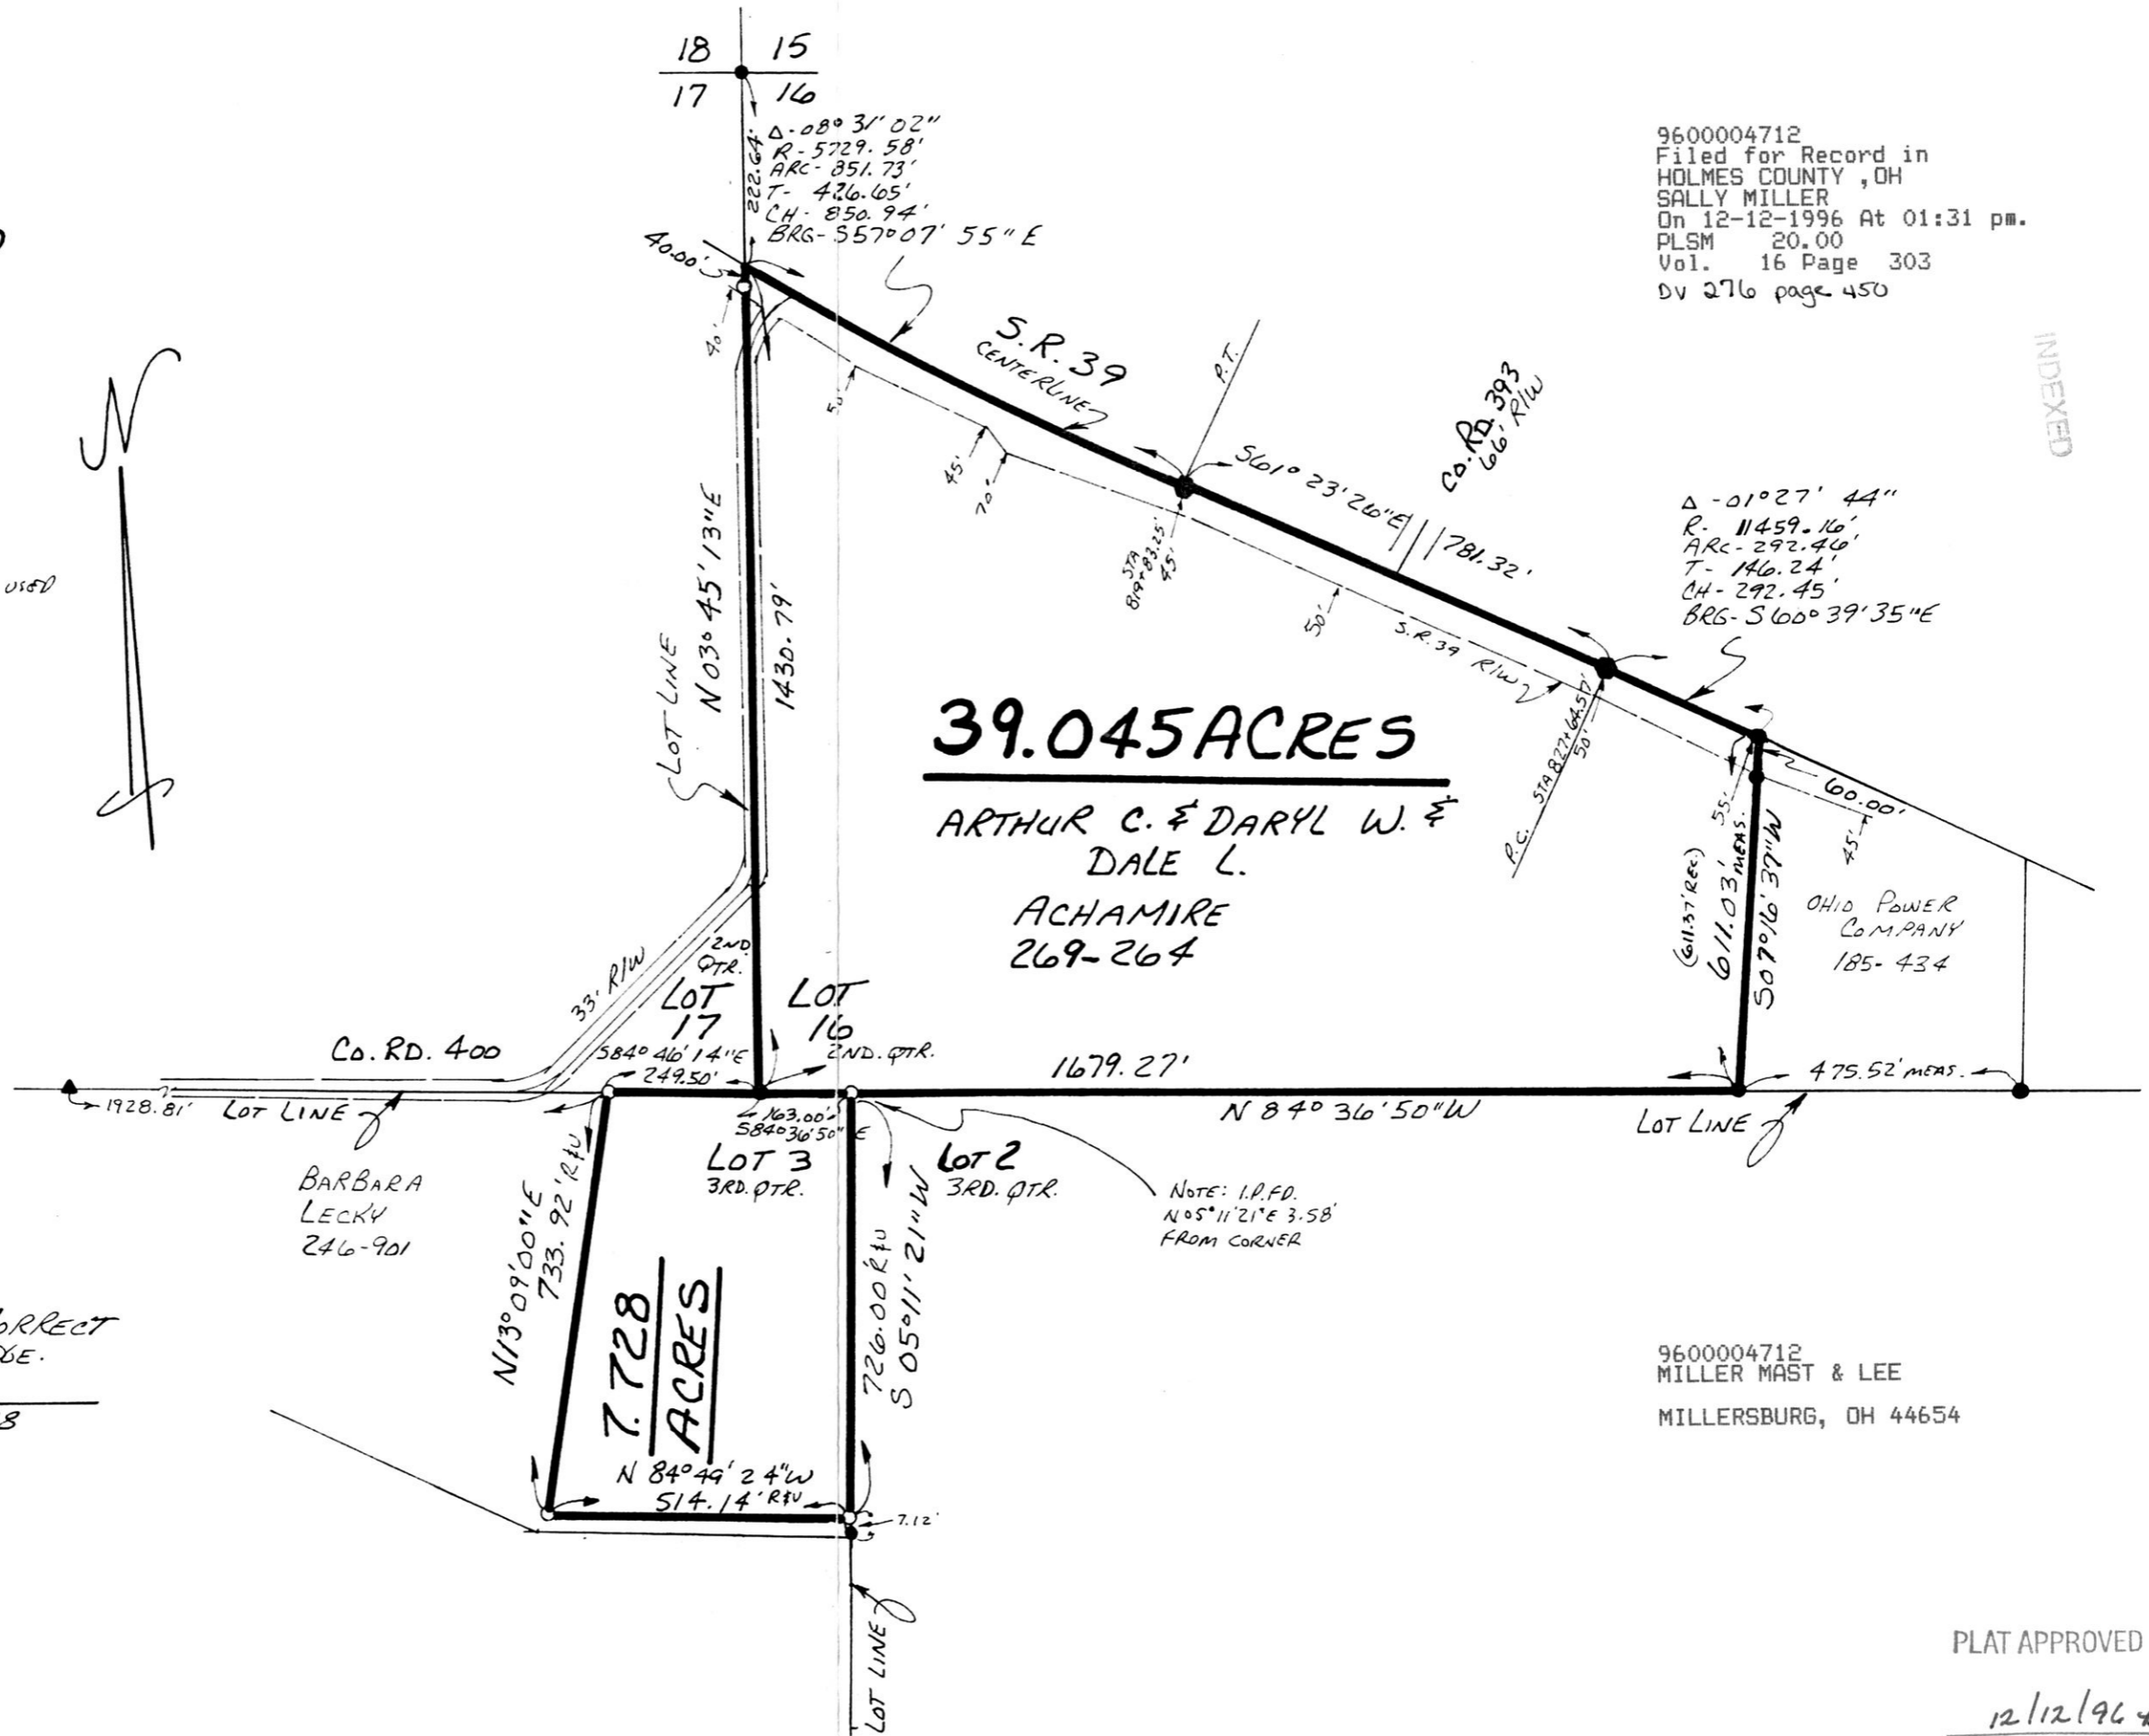

INDEXED

9600004712  
MILLER MAST & LEE  
MILLERSBURG, OH 44654

PLAT APPROVED  
12/12/96