

REFERENCES:

DEED VOL. 150 PAGE 465
DEED VOL. 214 PAGE 730
DEED VOL. 135 PAGE 19

PLAT VOL. 2 PAGE 67


BERLIN TOWNSHIP
3RD. QTR. LOT 22
T-9N; R-5W
HOLMES COUNTY, OHIO

0 100 200 400
SCALE: 1"=200'
● IRON PIN FOUND
△ R.R. SPIKE SET
○ 5/8" RE BAR WITH I.D. CAP SET
I.D. CAP MARKED "BAKER 6938"

9700005809
Filed for Record in
HOLMES COUNTY, OH
SALLY MILLER
On 02-27-1997 At 10:32 am
PLSM 20.00
Vol. 16 Page 359
Ov 277 page 325


INDEXED

9700005809
LAUREL HINES ATTORNEY
MILLERSBURG, OH 44644

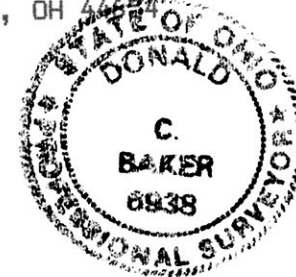

I CERTIFY THIS SURVEY TO BE
CORRECT TO THE BEST OF MY
KNOWLEDGE.

Donald C. Baker
DONALD C. BAKER P.S. 6938
5958 T.R. 322
MILLERSBURG, OHIO 44654
PH. (216) 674-4788
JANUARY 30, 1996

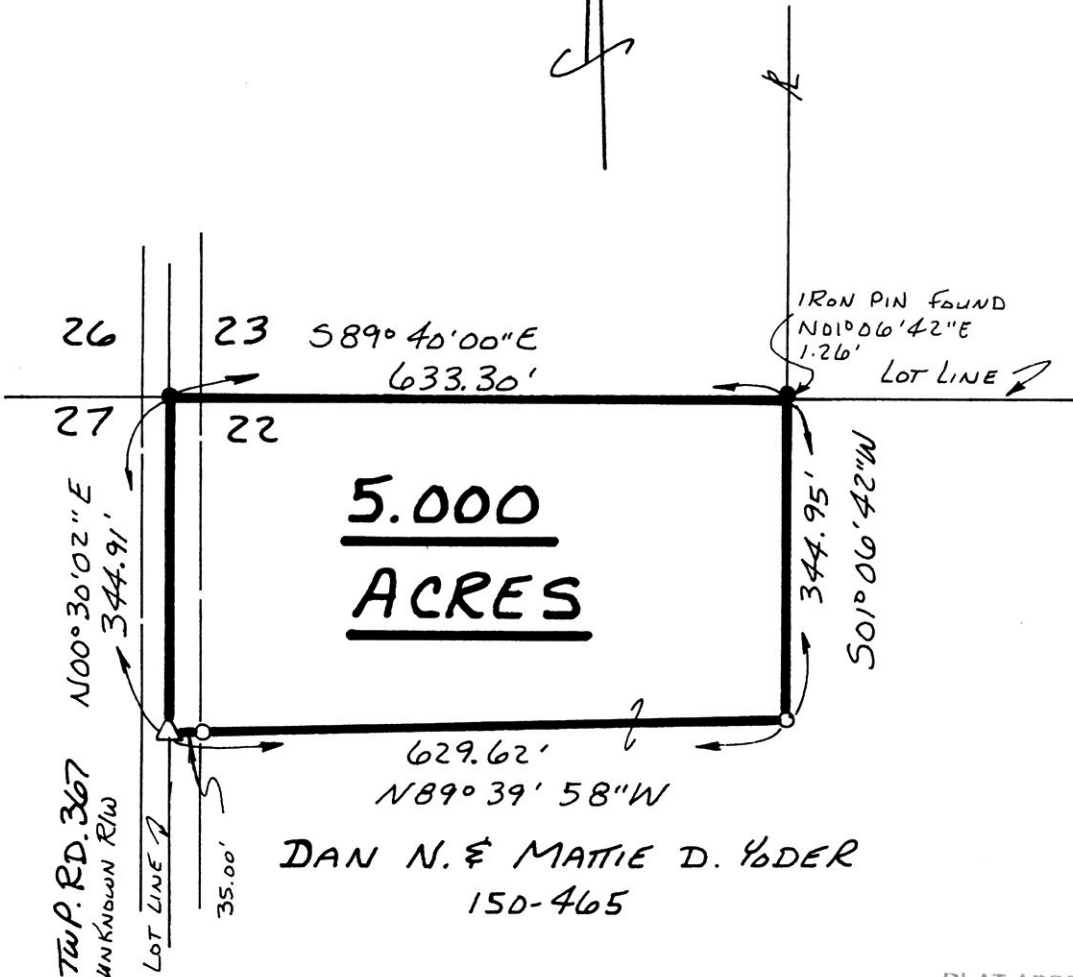

PLAT APPROVED

2/27/97