

CLARK TOWNSHIP
N.W. QTR. SECTION 4
T-8N; R-5W
HOLMES COUNTY, OHIO

SURVEYED FOR ATLEE & YODER

0 100 200 400




SCALE: 1" = 200'

- STONE FOUND
- IRON PIN FOUND
- 5/8" REBAR WITH ID. CAP SET ID. CAP MARKED "BAKER 6938"

9700007097
 Filed for Record in
 HOLMES COUNTY, OH
 SALLY MILLER
 On 05-19-1997 At 01:25 pm
 PLSM 20.00
 Vol. 16 Page 426
 0V 278 page 294

INDEXED

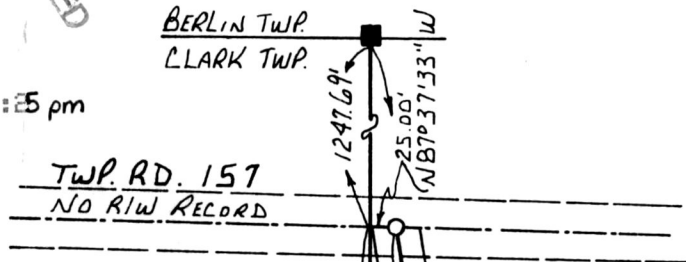

HENRY M. & VERBA RABER
187-57


REFERENCES:

- DEED VOL. 224 PAGE 14
- DEED VOL. 187 PAGE 57
- DEED VOL. 1060 PAGE 317
- PLAT VOL. 12 PAGE 446
- BEARINGS FROM PLAT VOL. 11 PAGE 34

970063

APPROVED FOR TRANSFER ONLY
 NO SUBDIVISION PLAT REQUIRED
 (O.R.C. 711.001 & 711.131)
 Lot(s) not for building unless
 approved by Board of Health.
 HOLMES CO. PLANNING COMM.


By TRM Date 4-21-97

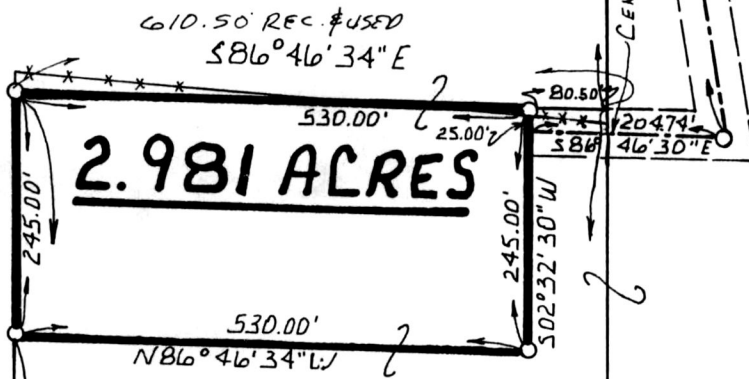

JACOB E. & CLARA MAST
 121-169
 130-59
 224-14



9700007097
 TOM MILLER ATTORNEY
 SUGARCREEK, OH

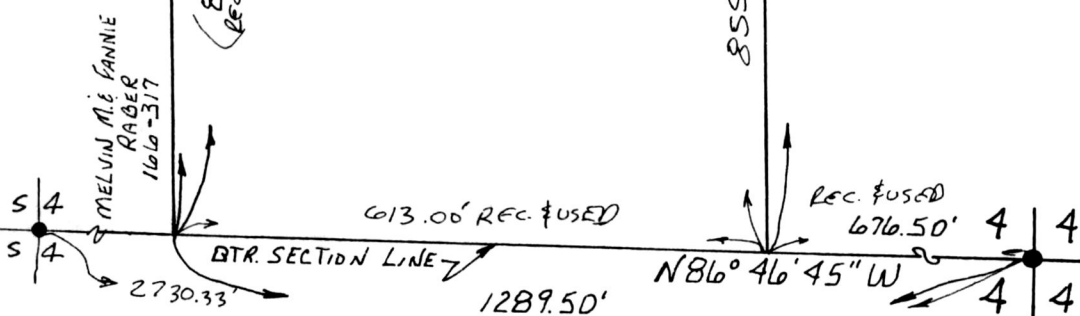

I CERTIFY THIS SURVEY TO BE CORRECT TO THE BEST OF MY KNOWLEDGE.

Donald C. Baker
 DONALD C. BAKER P.S. 6938
 5958 T.R. 322
 MILLERSBURG, OHIO 44654
 PH. (330) 674-4788
 DECEMBER 10, 1996
 71796-SRU
 FCC - J. D. DARR

PLAT APPROVED

4/22/97