

REFERENCES:

DEED VOL. 175 PAGE 501
" " 223 " 338
" " 192 " 62
" " 245 " 619

BEARINGS FROM PLAT VOL. 10 PAGE 448
SURVEYED FOR ROY YODER

SALT CREEK TOWNSHIP SOUTH PART OF FRACTIONAL SECTION II T-14N; R-12W HOLMES COUNTY, OHIO

0 50 100 200

SCALE: 1" = 100'

- STONE FOUND
- CROWS FOOT IN CONCRETE DRIVE
- △ R.R. SPIKE SET
- 5/8" REBAR WITH I.D. CAP SET
- I.D. CAP MARKED "BAKER 6938"
- ▲ R.R. SPIKE FOUND



9700007351
 Filed for Record in
 HOLMES COUNTY, OH
 SALLY MILLER
 On 06-05-1997 At 10:39 am.
 PLSM 20.00
 Vol. 16 Page 439
 DV 278 page 511

I CERTIFY THIS SURVEY TO BE
CORRECT TO THE BEST OF MY
KNOWLEDGE.

Donald C. Baker


DONALD C. BAKER P.S. 6938
 138 N. CLAY ST.
 MILLERSBURG, OHIO 44654
 PH: (330) 674-4788

APRIL 7, 1997

9700007351
 LAUREL HINES ATTORNEY
 MILLERSBURG, OH 44654
 19197 FJM
 F.C.C. - J.D. DARR

970104
 APPROVED FOR TRANSFER ONLY
 NO SUBDIVISION PLAT REQUIRED
 (O.R.C. 711.001 & 711.131)
 Lot(s) not for building unless
 approved by Board of Health.
 HOLMES CO. PLANNING COMM.

By *ADM* Date *6/3/97*

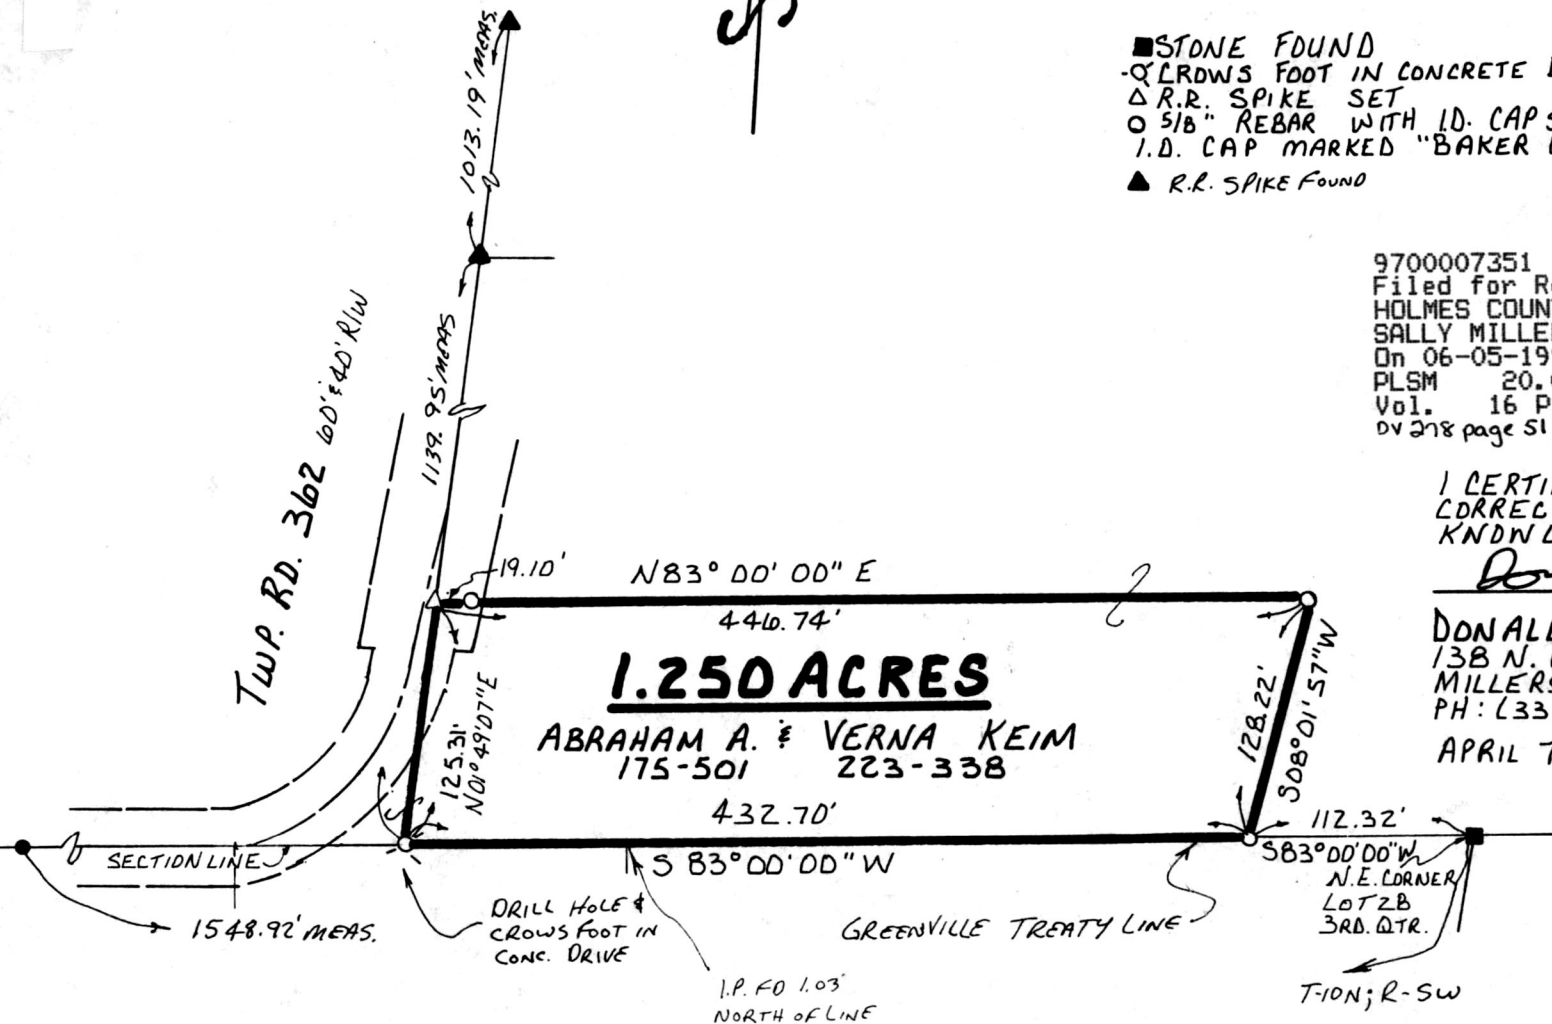

PLAT APPROVED

6/3/97