


SURVEYED FOR DEAN MILLER

9700007714
 Filed for Record in
 HOLMES COUNTY, OH
 SALLY MILLER
 On 06-26-1997 At 11:19 am.
 PLSM 20.00
 Vol. 16 Page 460
 of 278 page 767

INDEXED

WASHINGTON TOWNSHIP
 S.E. QTR. SECTION 26
 T-20N; R-15W
 HOLMES COUNTY, OHIO

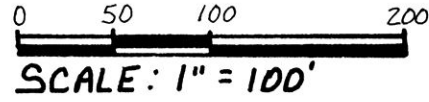


• IRON PIN FOUND
 0518" REBAR WITH I.D. CAP SET
 I.D. CAP MARKED "BAKER 6938"

REFERENCES:

DEED VOL. 220 PAGE 406
 " " 233 " 645
 " " 230 " 146
 " " 161 " 303
 PLAT VOL. 10 PAGE 522
 " " 10 " 135

BEARINGS FROM PLAT VOL. 10 PAGE 668

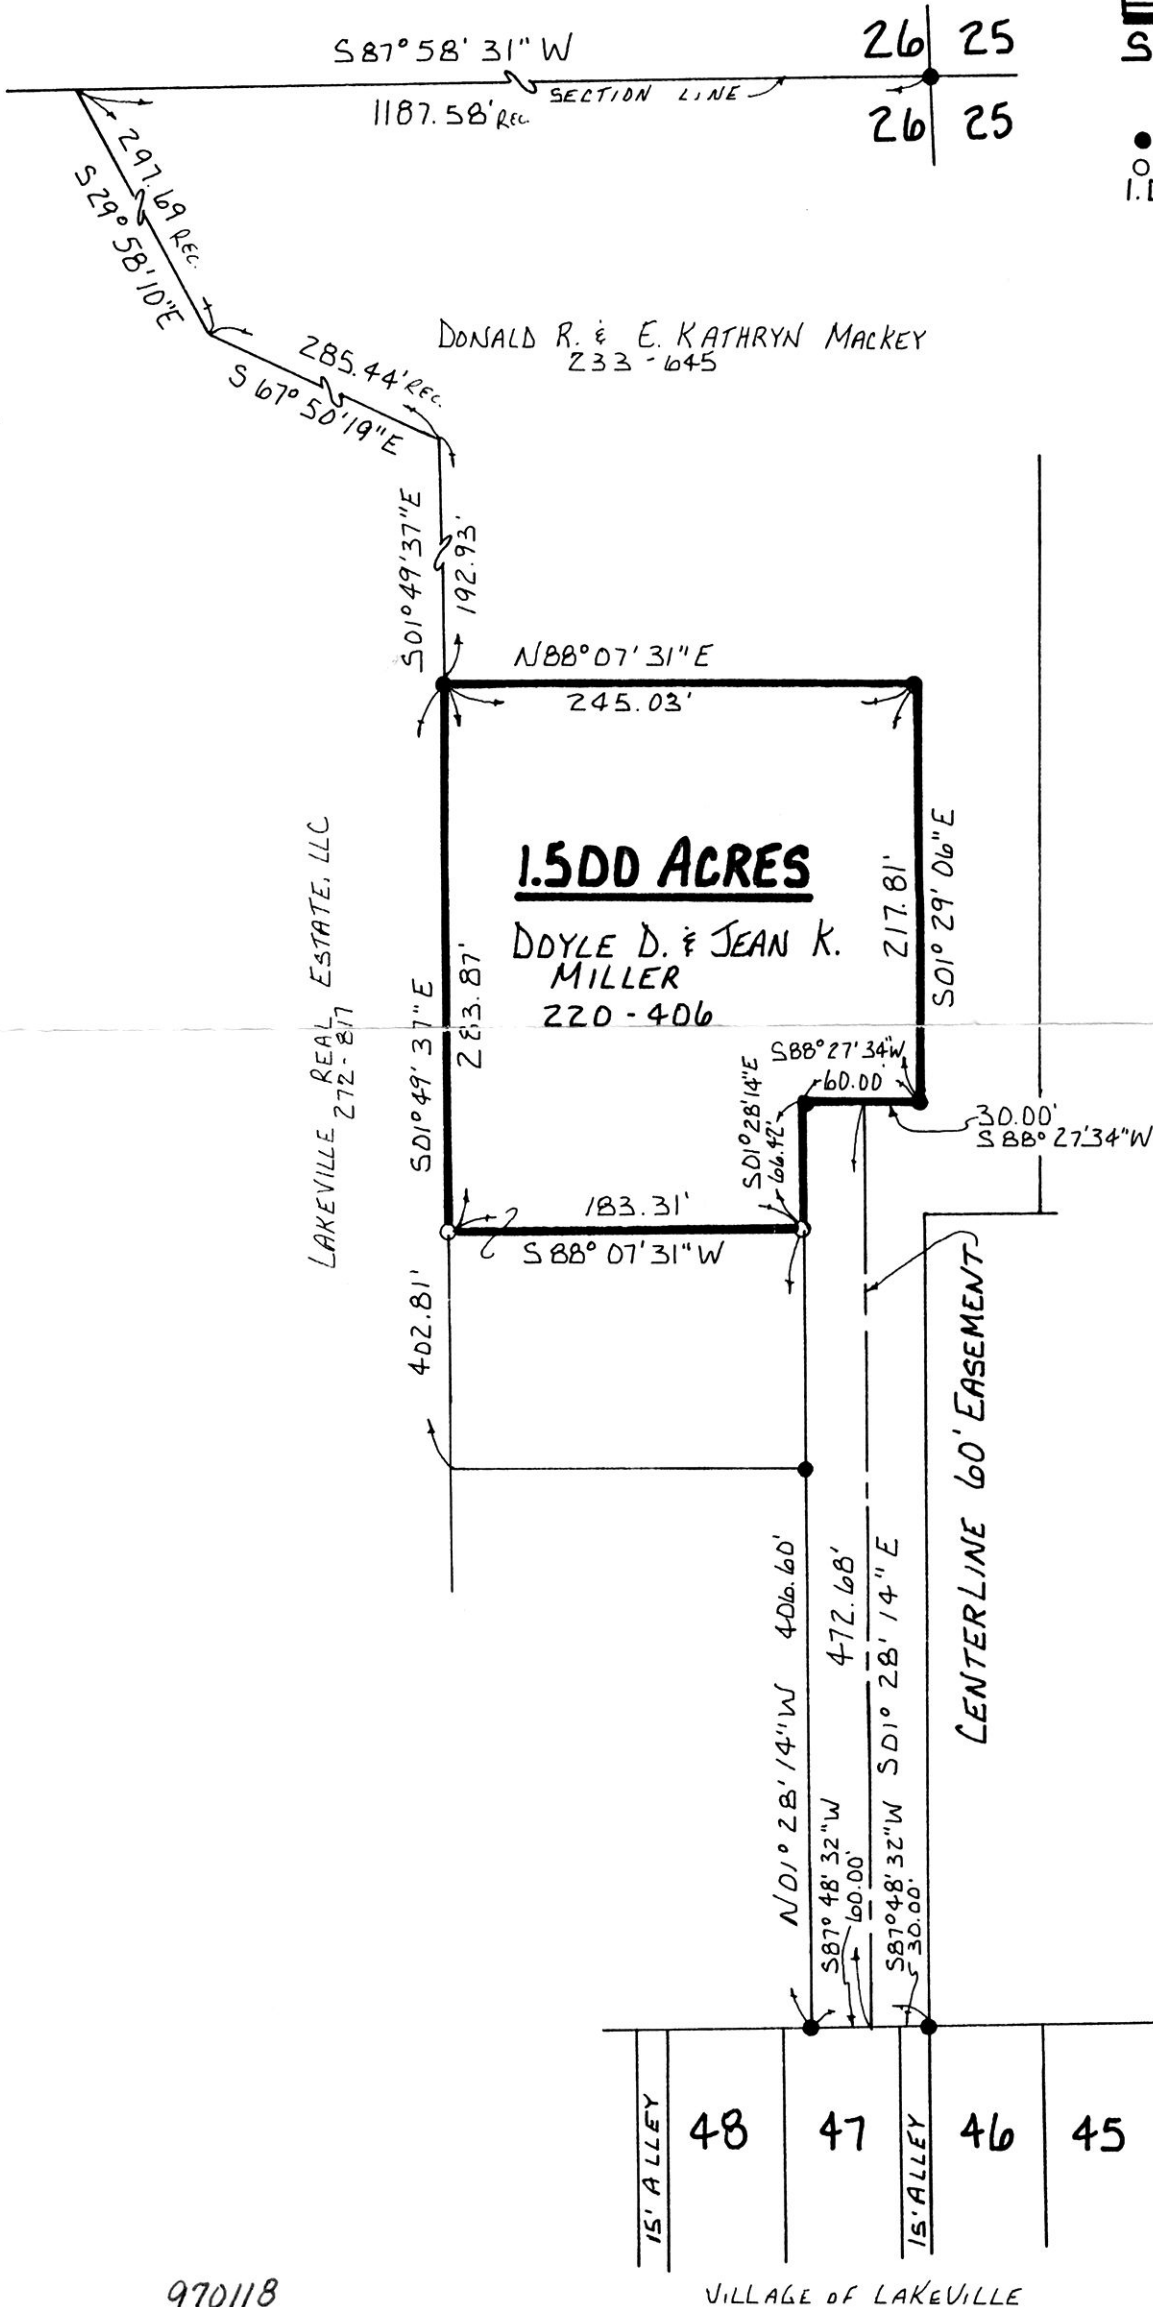

9700007714
 SAMUEL STEIMEL ATTY
 MILLERSBURG,



I CERTIFY THIS SURVEY TO BE CORRECT
 TO THE BEST OF MY KNOWLEDGE.

Donald C. Baker
 DONALD C. BAKER P.S. 6938
 138 N. CLAY ST.
 MILLERSBURG, OHIO 44654
 PH: (330) 674-4788

MAY 19, 1997

PLAT APPROVED

24897 FJM
 F.C.C. - F.D. BAKER

6/17/97

970118
 APPROVED FOR TRANSFER ONLY
 NO SUBDIVISION PLAT REQUIRED
 (O.R.C. 711.001 & 711.131)
 Lot(s) not for building unless
 approved by Board of Health.
 HOLMES CO. PLANNING COMM.
 By CDM Date 6/16/97

VILLAGE OF LAKEVILLE