

WASHINGTON TOWNSHIP
 HOLMES COUNTY, OHIO
 N.E. QTR. SEC. 9, N.W. QTR. SEC. 10
 T-19N R-15W

9700008959
 Filed for Record in
 HOLMES COUNTY, OH
 SALLY MILLER 12:53
 On 09-11-1997 At 12:57
 SMALL PLAT 20.00
 Vol. 16 Pg. 531 -
 DV 279 page 891

INDEXED

- ▲ RR Spike Found
 - △ RR Spike Set
 - Iron Pin Found
 - Iron Pin Set 5/8" Rebar With Yellow Cap Marked
- "LONG SURVEYING INC."

Bearings Relative To Plat Vol. 8, Pg. 483



References:
 Plat Vol. 8, Pg. 400
 Plat Vol. 8, Pg. 483
 Plat Vol. 10, Pg. 713
 Deeds Shown

Roger L. & Bonnie M. Alfred
 232 - 170

Karen L. Straw
 223 - 34

Patrick E. & Amanda J. Lipps
 234 - 581

G.H. & S.M. Haudenschild
 205 - 337

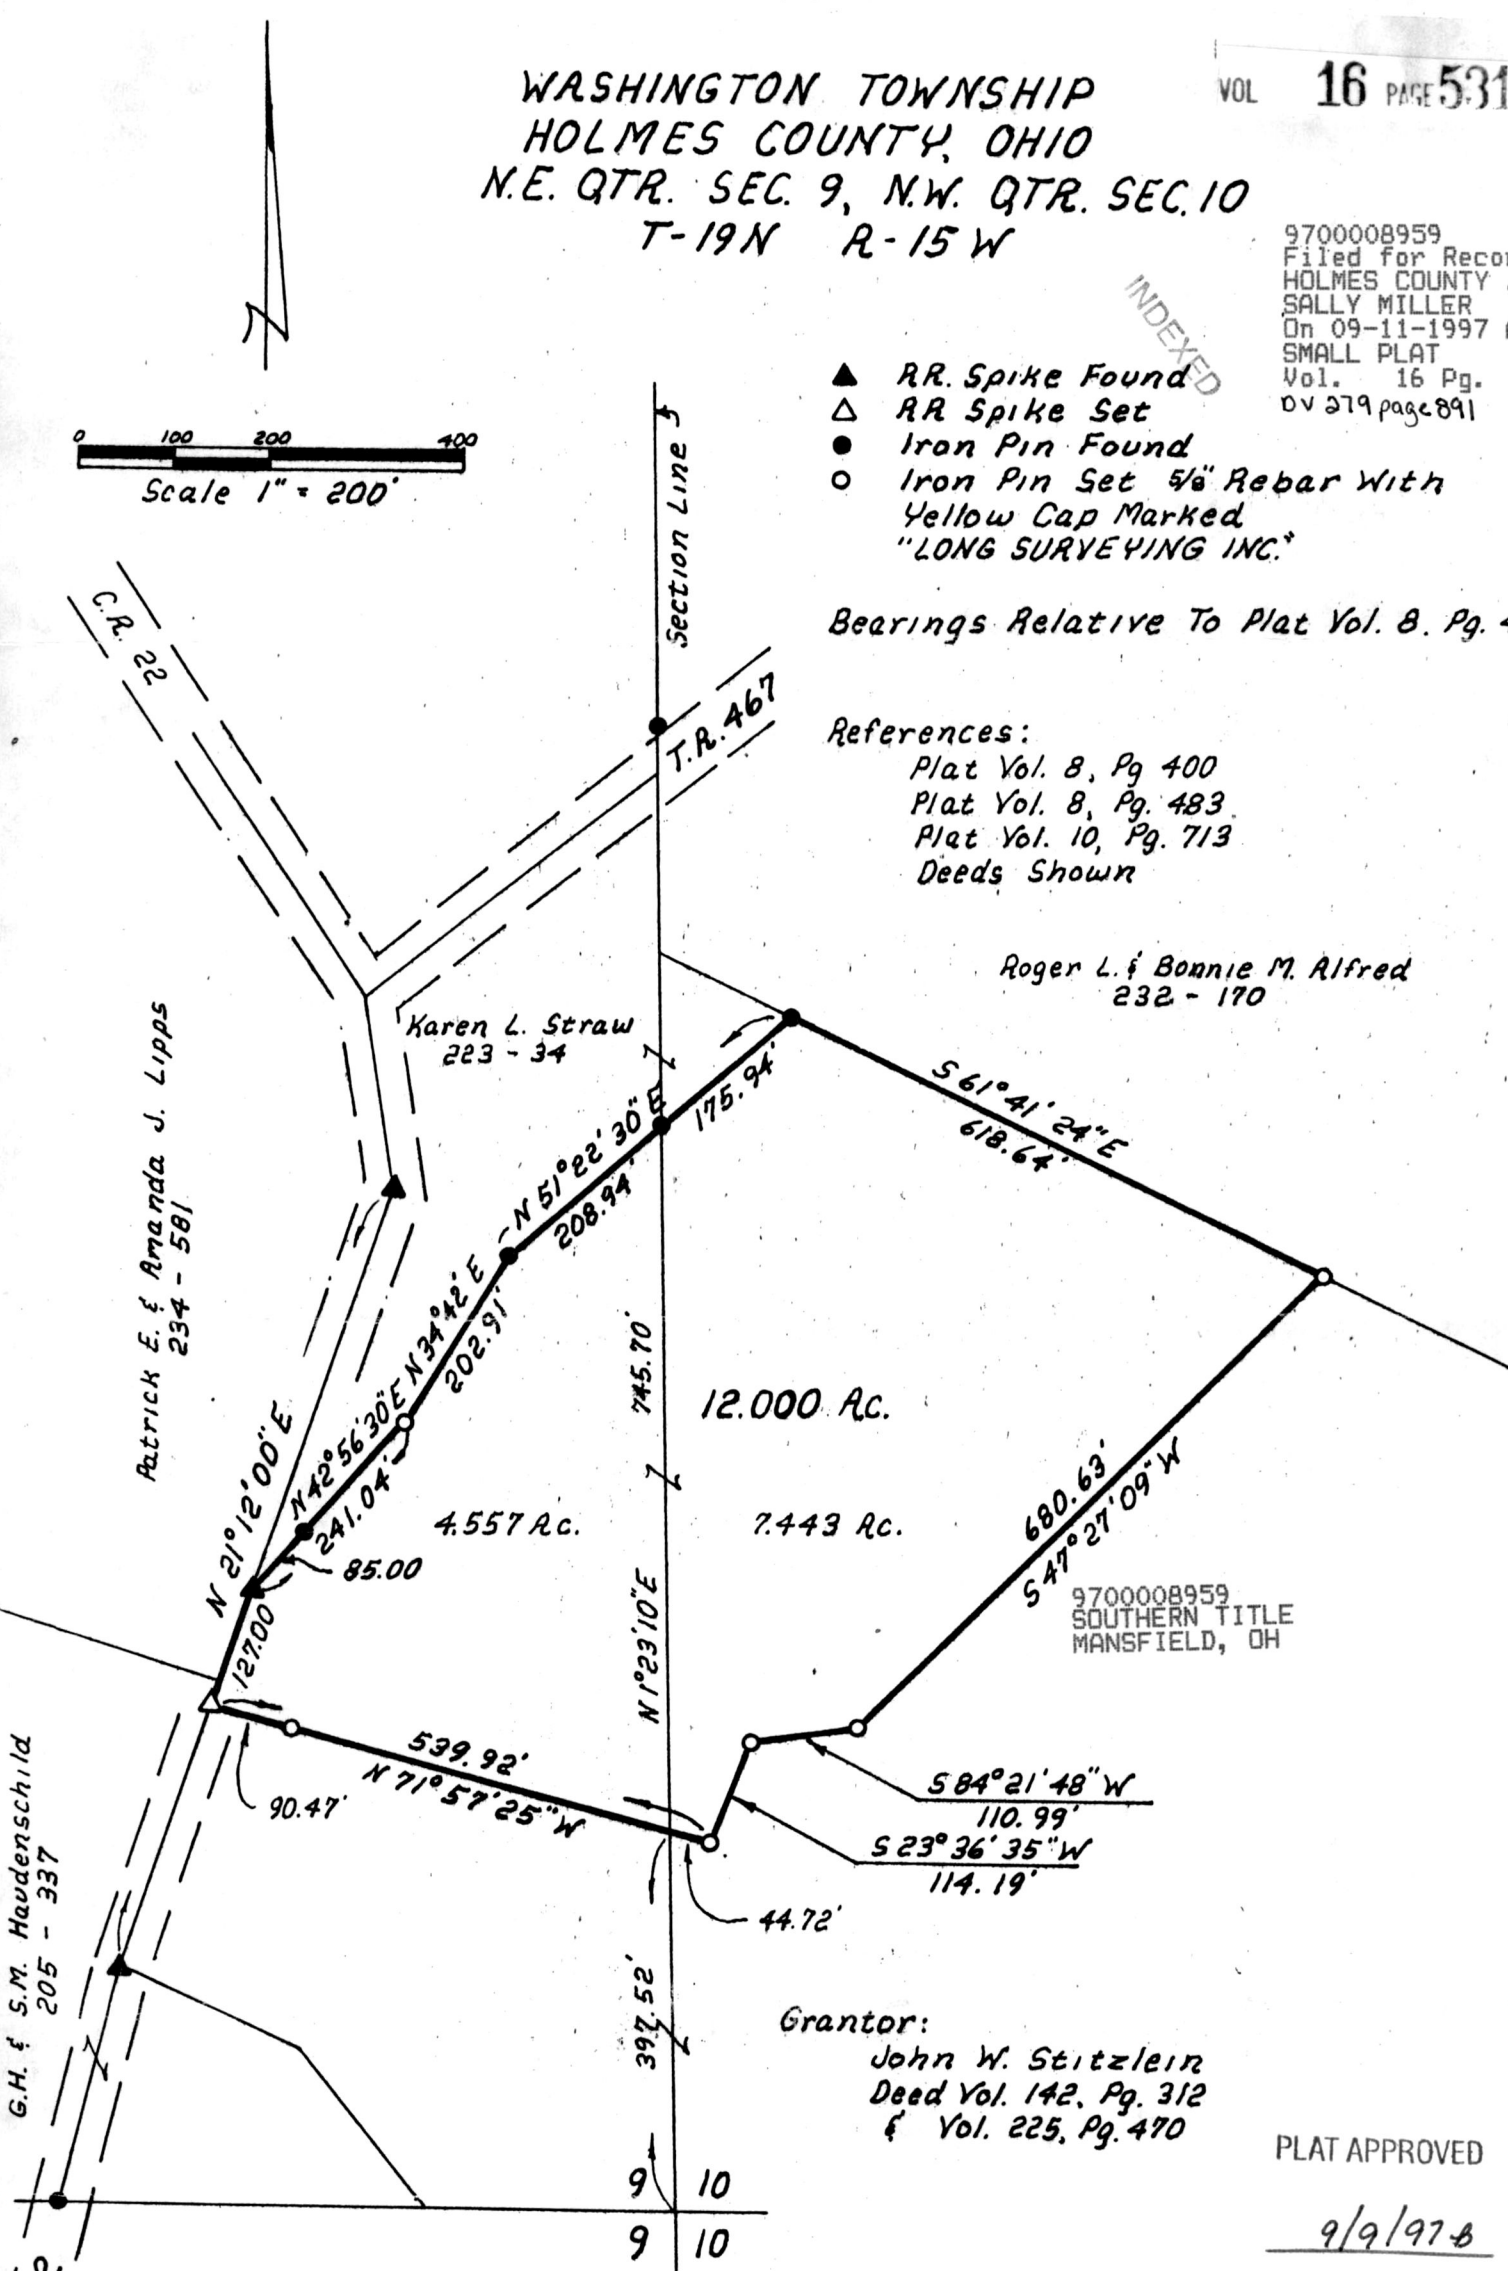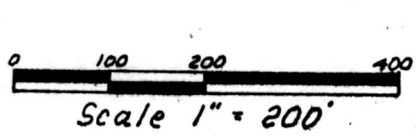

9700008959
 SOUTHERN TITLE
 MANSFIELD, OH

Grantor:
 John W. Stitzlein
 Deed Vol. 142, Pg. 312
 & Vol. 225, Pg. 470

PLAT APPROVED

9/9/97-B

I Certify This Survey To Be Correct
 To The Best Of My Knowledge.

Donald G. Long Feb. 6, 1989
 Donald G. Long P.S. 7115
 LONG SURVEYING INC.
 13301 T.R. 503
 Big Prairie, Ohio 44611

