

KILLBUCK TOWNSHIP
S.E. QTR. SECTION 18
T-8N; R-8W
HOLMES COUNTY, OHIO

- REFERENCES:
DEED VOL. 176 PAGE 87
" " 176 " 89
" " 251 " 744
" " 251 " 411
" " 243 " 34
PLAT VOL. 7 PAGE 382


- STONE FOUND
- IRON PIN FOUND
- 5/8" RE BAR WITH I.D. CAP SET
- I.D. CAP MARKED "BAKER6938" (SURVEYED FOR: HELEN SNOW)

9700009536
Filed for Record in
HOLMES COUNTY, OH
SALLY MILLER
On 10-14-1997 At 10:23 am.
SMALL PLAT 20.00
Vol. 16 Pg. 555 - 555
pv 280 pg 355

INDEXED

BEARINGS ON SECTION LINE
FROM PLAT VOL. 5 PAGE 69.

587°47'11"E 1310.42'

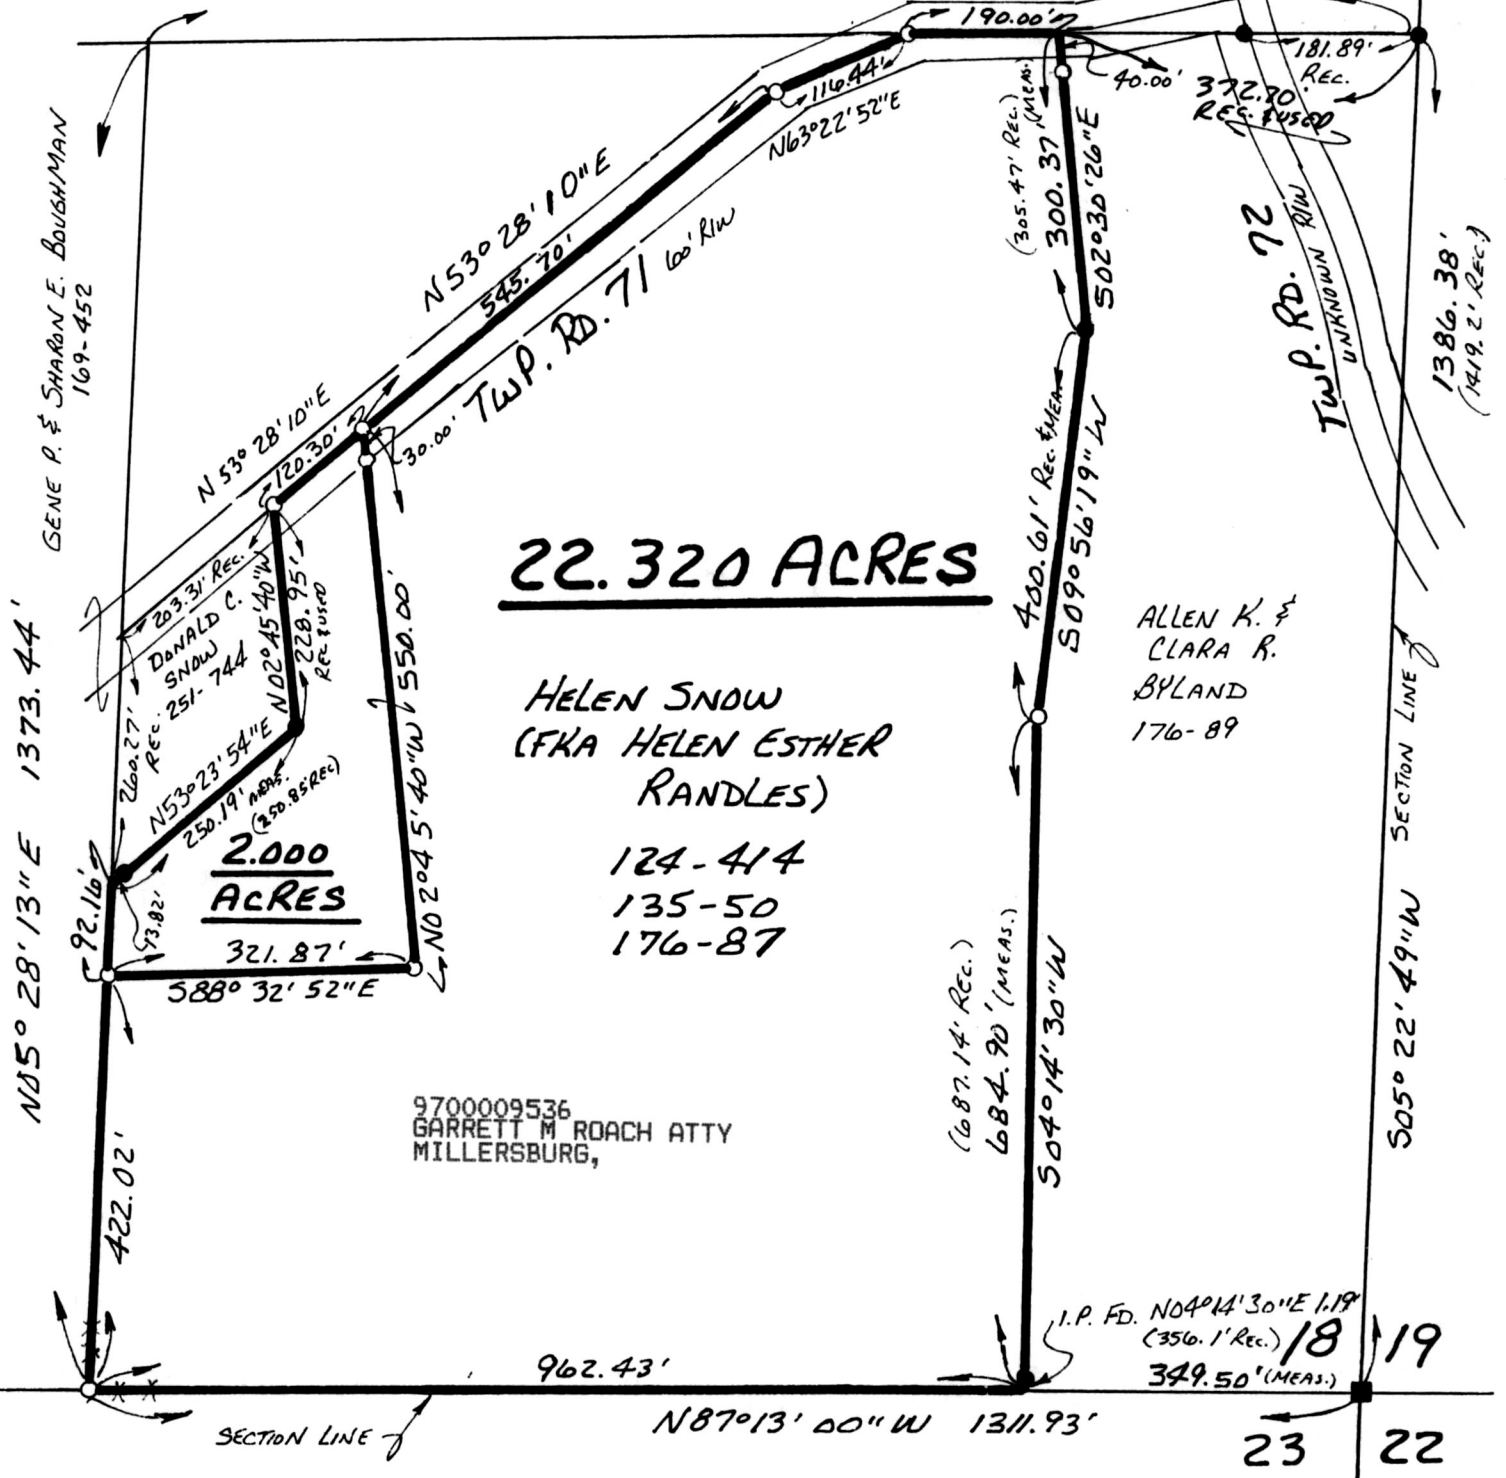

22.320 ACRES

HELEN SNOW
(FKA HELEN ESTHER
RANGLES)
124-414
135-50
176-87

ALLEN K. &
CLARA R.
BYLAND
176-89

9700009536
GARRETT M. ROACH ATTY
MILLERSBURG,

I CERTIFY THIS SURVEY TO BE CORRECT
TO THE BEST OF MY KNOWLEDGE.

Donald C. Baker
DONALD C. BAKER P.S. 6938
138 N. CLAY ST.
MILLERSBURG, OHIO 44654
PH. (330) 674-4788
OCTOBER 7, 1997
#59997-M.L. DAVIS
F.C.C. - F.D. BAKER



PLAT APPROVED

10/10/97 B

990205
APPROVED FOR TRANSFER ONLY
NO SUBDIVISION PLAT REQUIRED
(O.R.C. 711.001 & 711.131)
Lot(s) not for building unless
approved by Board of Health.
HOLMES CO. PLANNING COMM.
By CDM Date 10/10/97