

SCALE: 1" = 60'

- IRON PIN FOUND
- 5/8" REBAR WITH I.D. CAP SET
- I.D. CAP MARKED "BAKER 6938"




VILLAGE OF GLENMONT

RICHLAND TOWNSHIP
 S.W. QTR. SECTION 1
 T-8N; R-9W
 HOLMES COUNTY, OHIO

(SURVEYED FOR: JAMES & SANDRA ACKERT)

9700010795
 Filed for Record in
 HOLMES COUNTY, OH
 SALLY MILLER
 On 12-31-1997 At 11:02 am.
 PLAT MED 21.60
 Book OR Vol. 16 Pg. 622 - 622
 Official Record 1 Pg. 109-111

INDEXED

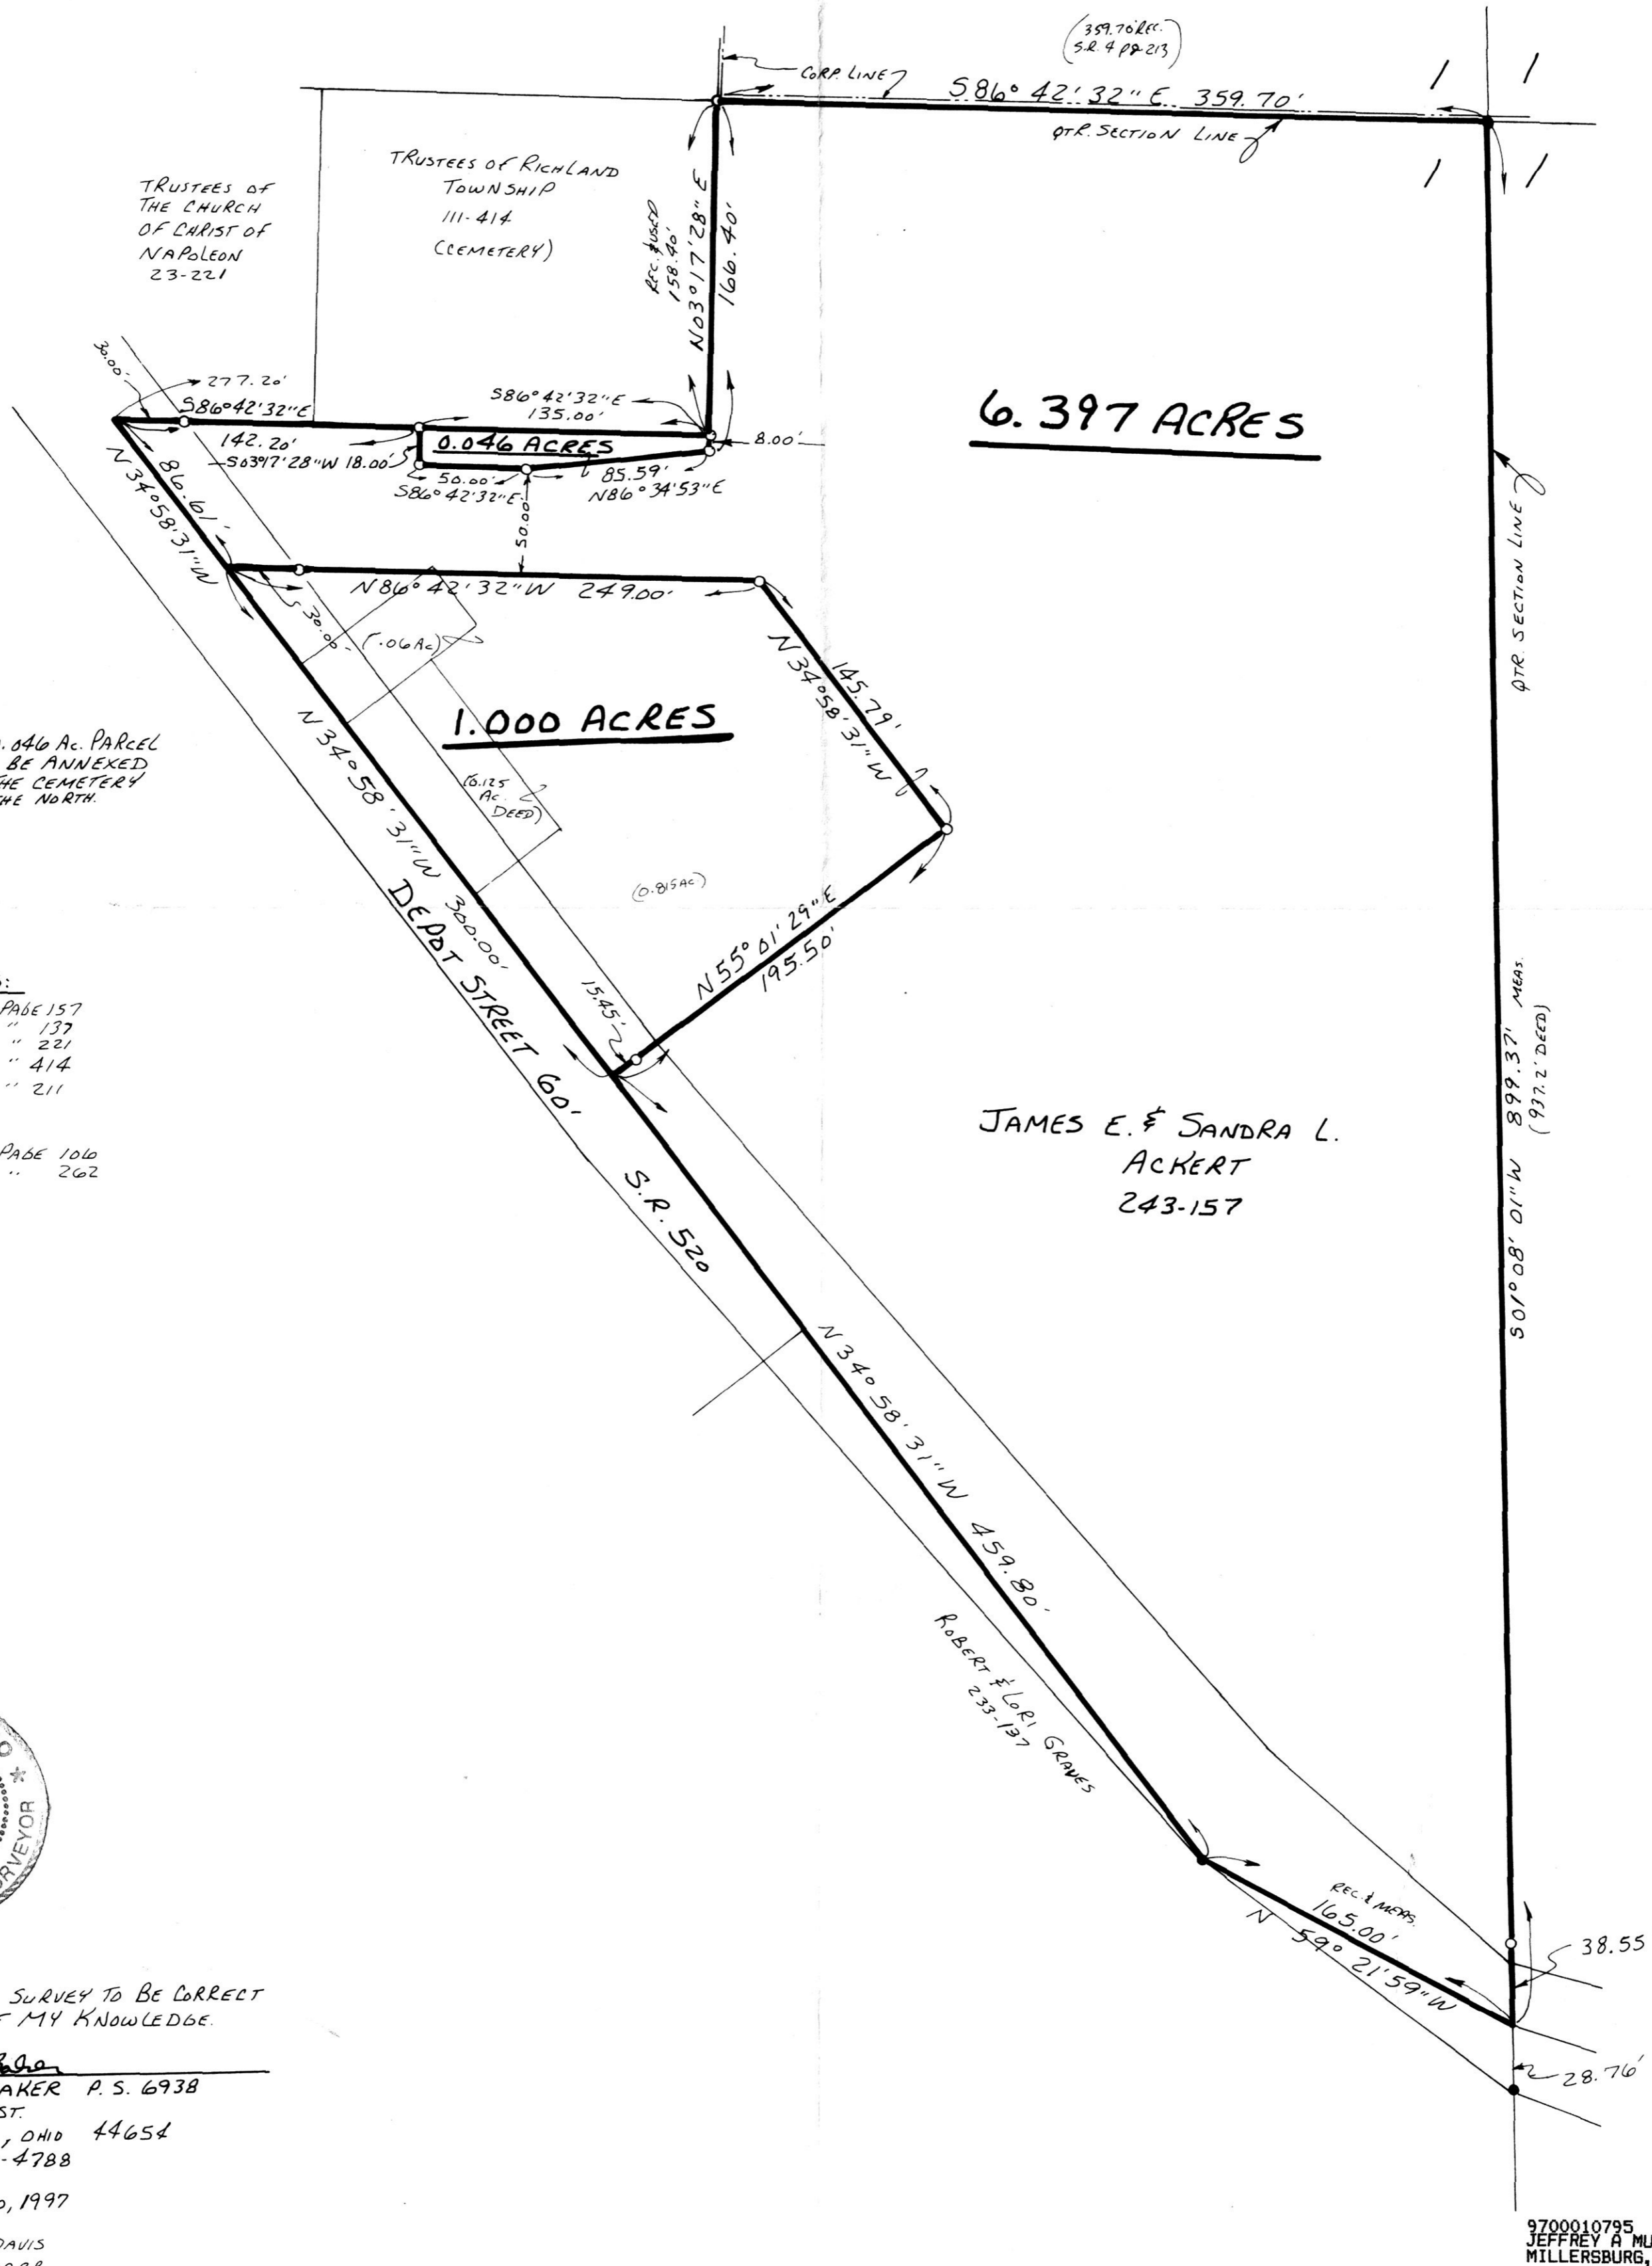

TRUSTEES OF
 THE CHURCH
 OF CHRIST OF
 NAPOLEON
 23-221

TRUSTEES OF RICHLAND
 TOWNSHIP
 111-414
 (CEMETERY)

6.397 ACRES

1.000 ACRES

0.046 ACRES

JAMES E. & SANDRA L.
 ACKERT
 243-157

NOTE: THE 0.046 AC. PARCEL
 IS TO BE ANNEXED
 TO THE CEMETERY
 TO THE NORTH.

REFERENCES:

- DEED VOL. 243 PAGE 157
- " " 233 " 137
- " " 23 " 221
- " " 111 " 414
- " " 270 " 211

PLAT VOL. 11 PAGE 106
 " " 2 " 262

S.R. 4-213



I CERTIFY THIS SURVEY TO BE CORRECT
 TO THE BEST OF MY KNOWLEDGE.

Donald C. Baker
 DONALD C. BAKER P.S. 6938
 138 N. CLAY ST.
 MILLERSBURG, OHIO 44654
 PH. (330) 674-4788

NOVEMBER 20, 1997

#61897-M.L. DAVIS
 F.C.C. - J.D. DARR

9700010795
 JEFFREY A. MULLEN ATY
 MILLERSBURG,

PLAT APPROVED

12/22/97