

WALNUT CREEK TOWNSHIP
3RD. QTR. LOT 3
T-9N; R-5W
HOLMES COUNTY, OHIO



- SCALE: 1" = 100'
- ▲ R.R. SPIKE FOUND
 - IRON PIN FOUND
 - 5/8" RE BAR WITH I.D. CAP SET
 - I.D. CAP MARKED "BAKER 6938"

INDEXED

REFERENCES:


 " " 270 " 38
 " " 269 " 795
 " " 244 " 859

980000028
 Filed for Record in
 HOLMES COUNTY, OH
 SALLY MILLER
 On 01-02-1998 At 03:51 PM
 PLAT MED 16 PG. 625 - 625
 Book OR Vol. 16 PG. 625 - 625
 off Rec vol 1 pg 190-192-196-198

PLAT VOL. 14 PAGE 107
 " " 12 " 305
 " " 8 " 787


BEARINGS FROM PLAT VOL. 7 PAGE 434

NOTE: THE 0.945 AC. PARCEL IS TO BE ANNEXED TO ATLEE KABER PROPERTY TO THE SOUTH.

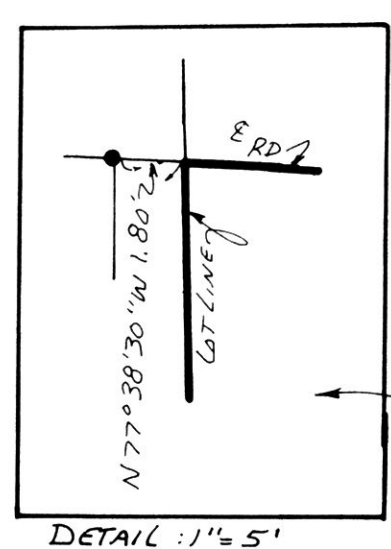

DETAIL: 1" = 5'

NOTE: THE 0.807 AC. PARCEL IS TO BE ANNEXED TO THE 6.178 AC. PARCEL.

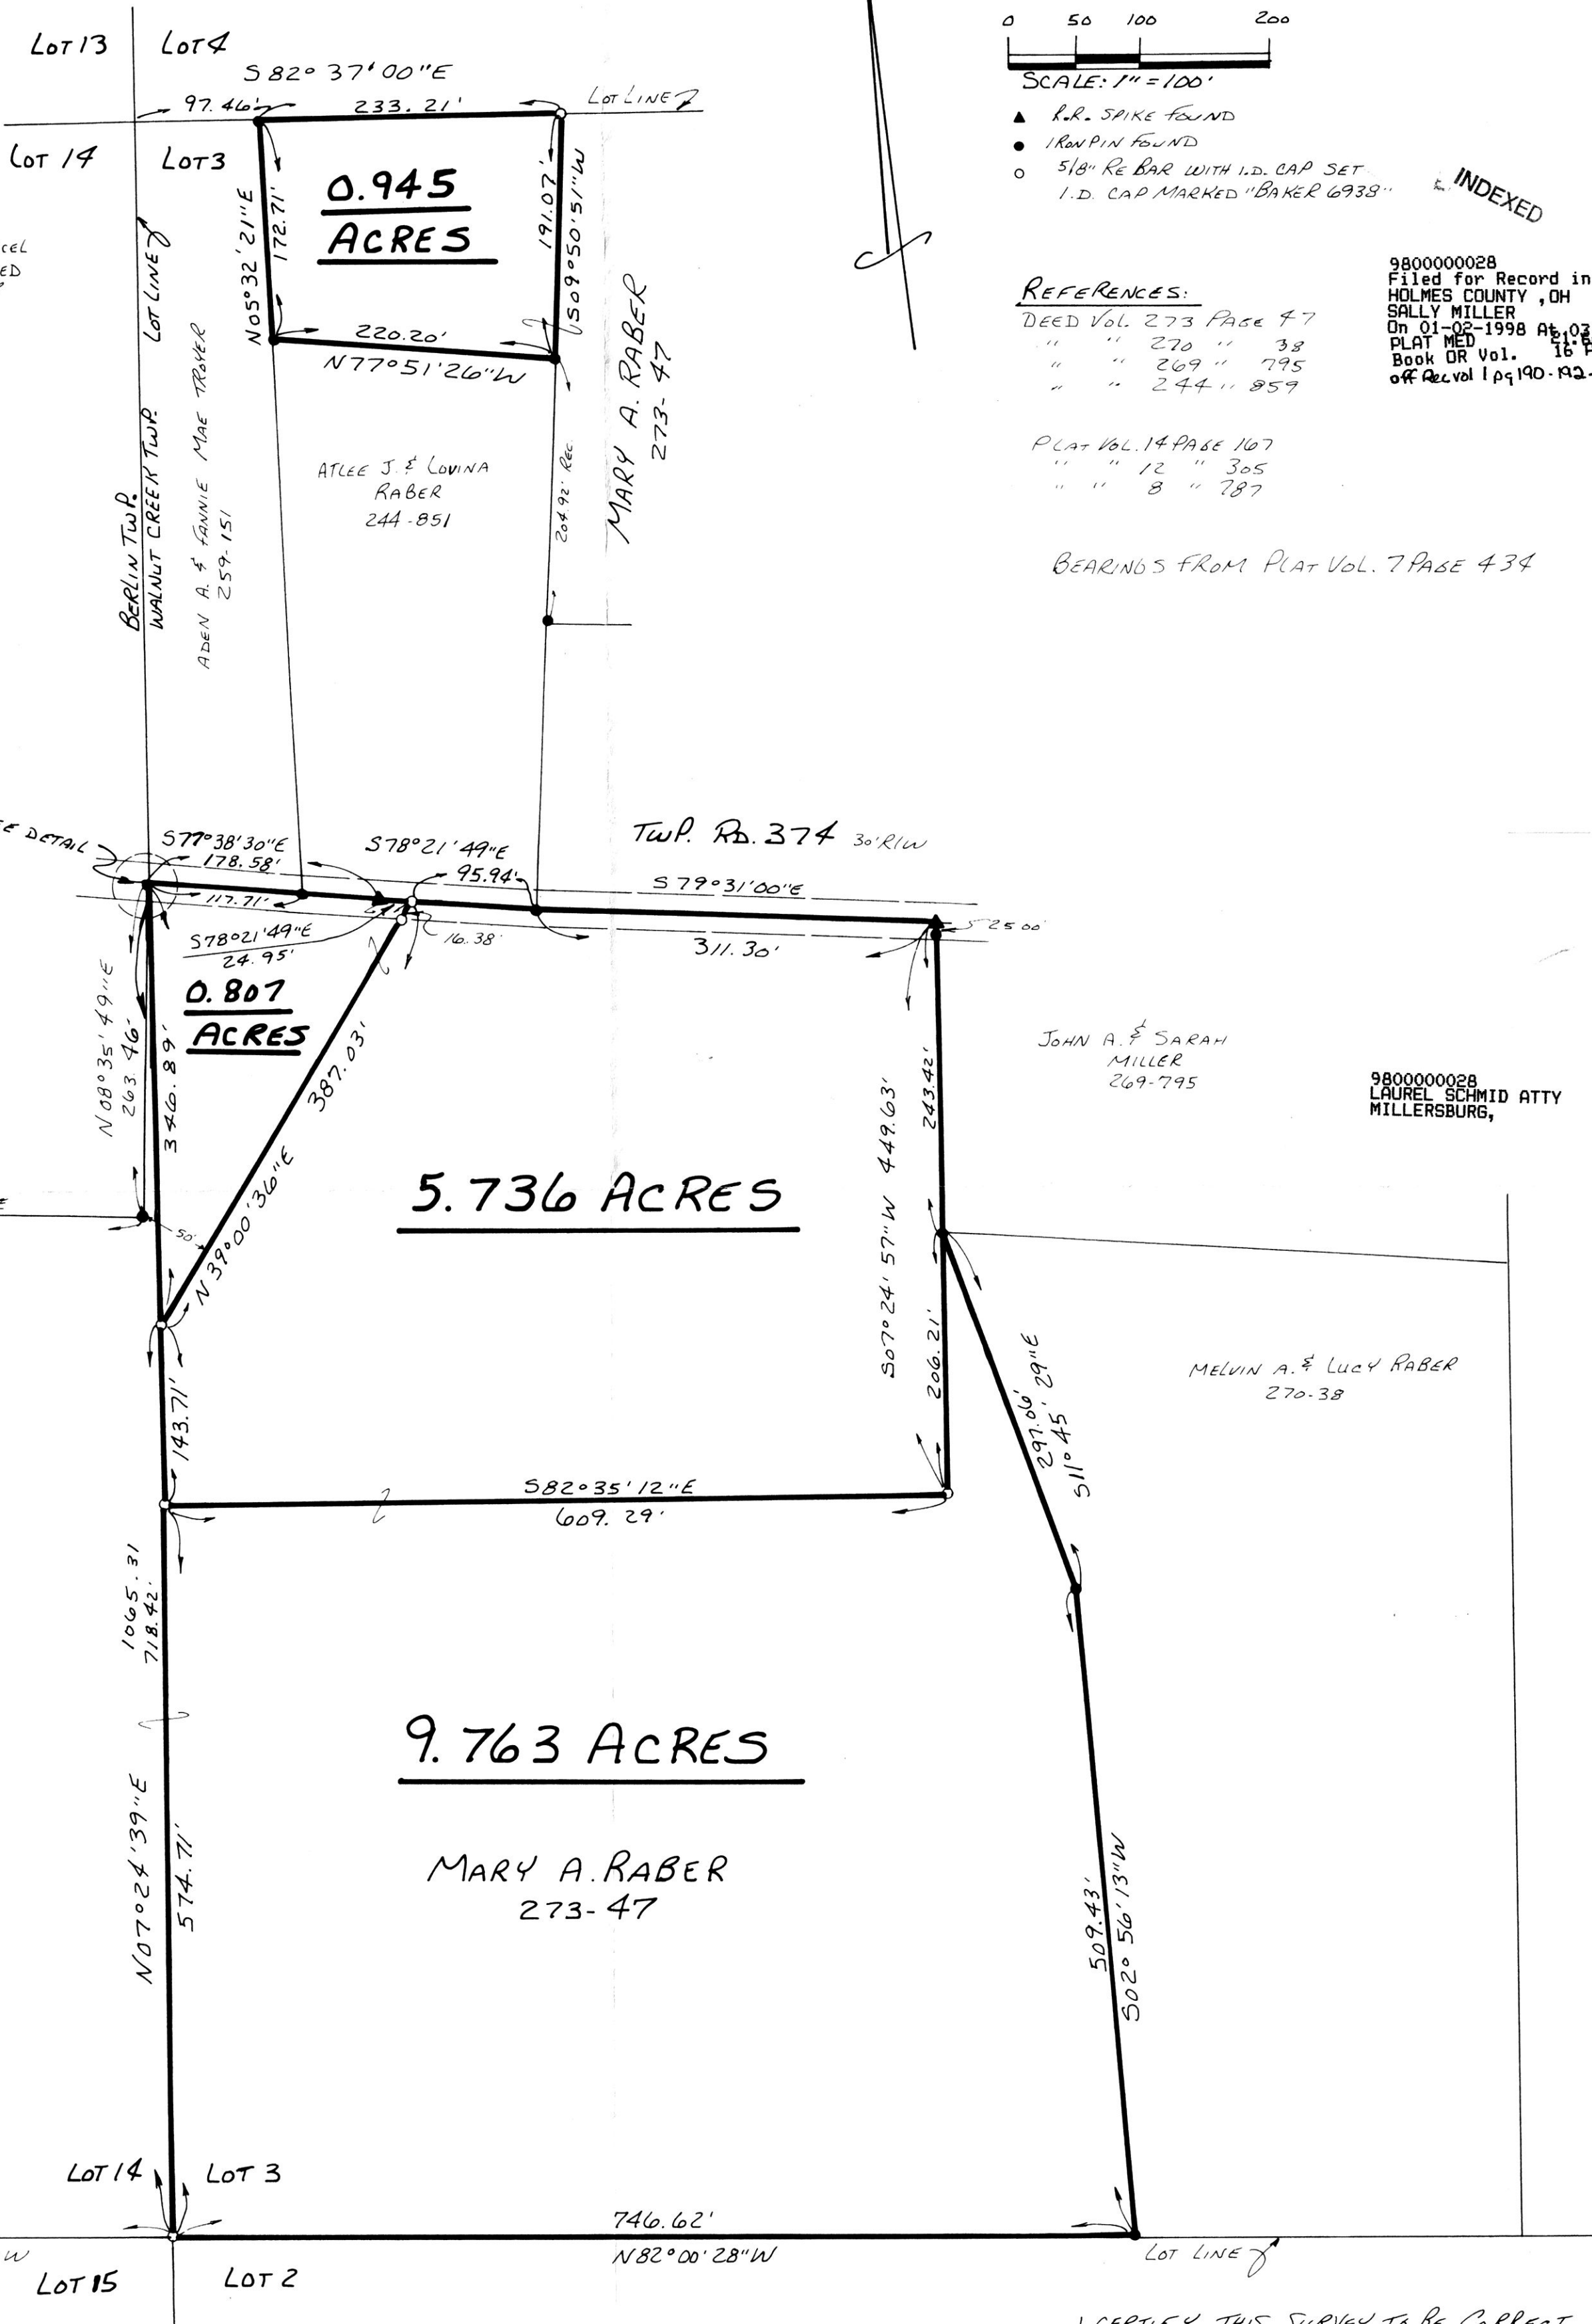

JOHN A. & SARAH MILLER
 269-795

980000028
 LAUREL SCHMID ATTY
 MILLERSBURG,

MELVIN A. & LUCY KABER
 270-38

970262 970263
 APPROVED FOR TRANSFER ONLY
 NO SUBDIVISION PLAT REQUIRED
 (O.R.C. 711.001 & 711.131)
 Lot(s) not for building unless
 approved by Board of Health.
 HOLMES CO. PLANNING COMM.
 By *[Signature]* Date 12-30-97



I CERTIFY THIS SURVEY TO BE CORRECT TO THE BEST OF MY KNOWLEDGE.

Donald C. Baker
 DONALD C. BAKER P.S. 6938
 138 N. CLAY ST.
 MILLERSBURG, OHIO 44054
 PH. (330) 674-4788
 OCTOBER 22, 1997

#58497 - M.L. DAVIS
 F.C.C. - F.D. BAKER

PLAT APPROVED
 12/31/97