


VOL 16 PAGE 649  
 2  
 S.R. 241

SALT CREEK TOWNSHIP  
 S.W. QTR. SECTION 1  
 T-14N; R-12W  
 HOLMES COUNTY, OHIO

INDEXED

9800000567  
 Filed for Record in  
 HOLMES COUNTY, OH  
 SALLY MILLER  
 On 02-09-1998 At 11:43 am.  
 SMALL PLAT 20.00  
 Book OR Vol. 16 Pg. 649 - 649  
 OR Vol 2 pg 980

980020  
 APPROVED FOR TRANSFER ONLY  
 NO SUBDIVISION PLAT REQUIRED  
 (O.R.C. 711.001 & 711.131)  
 Lot(s) not for building unless  
 approved by Board of Health.  
 HOLMES CO. PLANNING COMM.  
 By [Signature] Date 2/6/98

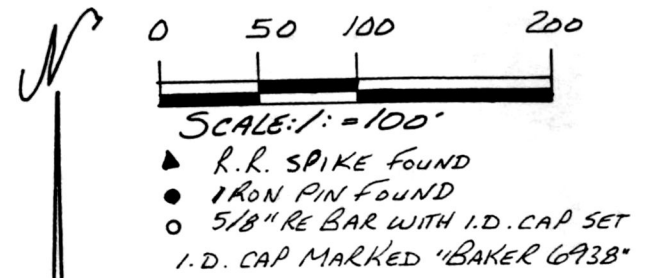

- REFERENCES:
- DEED Vol. 183 PAGE 178
  - " " 150 " 141
  - " " 186 " 6065
  - " " 228 " 449
- 
- PLAT Vol. 5 PAGE 133
  - " " 5 " 30
  - " " 8 " 578

BEARINGS FROM DEED Vol.  
 158 PAGE 423.



I CERTIFY THIS SURVEY TO BE  
 CORRECT TO THE BEST OF MY  
 KNOWLEDGE.

Donald C. Baker  
 DONALD C. BAKER P.S. 6938  
 5958 T.R. 322  
 MILLERSBURG OHIO 44654  
 PH. (330) 674-4788  
 AUGUST 28, 1996

51096-MLD

TWP. RD. 617

ABE L. & BARBARA YODER  
 186-665

CALVIN R. & BETTY MILLER  
 228-449

N84°26'44"E  
 373.49'

S70°44'27"E  
 377.241

**1.561 ACRES**

ALBERT A. & LINDA J. SUMMERS 183-178  
 729.89'

196.47'  
 185.06 REC. MEAS.  
 ALBERT A.  
 SUMMERS  
 150-141

N88°04'14"W

S01°40'14"W

ANDY C. & LINDA  
 MAZ  
 208-832

9800000567  
 LAUREL SCHMID ATTY  
 MILLERSBURG,

PLAT APPROVED

2/6/98-B

