


KNOX TOWNSHIP
 2ND. QTR. LOTS 4, 7 & 8
 T-9N; R-9W
 HOLMES COUNTY, OHIO
 (SURVEYED FOR: ROBERT & JANET FASIB)

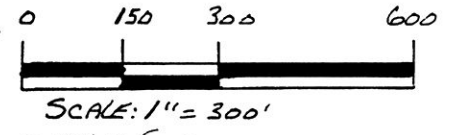

- STONE FOUND
- IRON PIN FOUND
- △ R.R SPIKE SET
- 5/8" RE BAR WITH I.D. CAP SET
I.D. CAP MARKED "BAKER 6938"

REFERENCES:
 DEED VOL. 197 PAGE 95
 " " 200 " 331
 " " 277 " 931

 PLAT VOL. 4 PAGE 81
 " " 11 " 82

 SURVEY RECORD 3 PAGE 209

9800001633
 Filed for Record in
 HOLMES COUNTY, OH
 SALLY MILLER
 On 04-13-1998 At 02:39 PM.
 SMALL PLAT 20.00
 Book OR Vol. 16 Pg. 695 - 695
 OR VOL 69987

INDEXED




I CERTIFY THIS SURVEY TO BE CORRECT
 TO THE BEST OF MY KNOWLEDGE.

Donald C. Baker
 DONALD C. BAKER P.S. 6938
 138 N. CLAY ST.
 MILLERSBURG, OHIO 44654
 PH. (330) 674-4788
 MARCH 18, 1998
 #13398-M.L. DAVIS
 F.C.C. - J.D. DARR

PLAT APPROVED
 4/10/98 B.

9800001633
 SAM STEIMEL ATTY
 MILLERSBURG, OH 44654

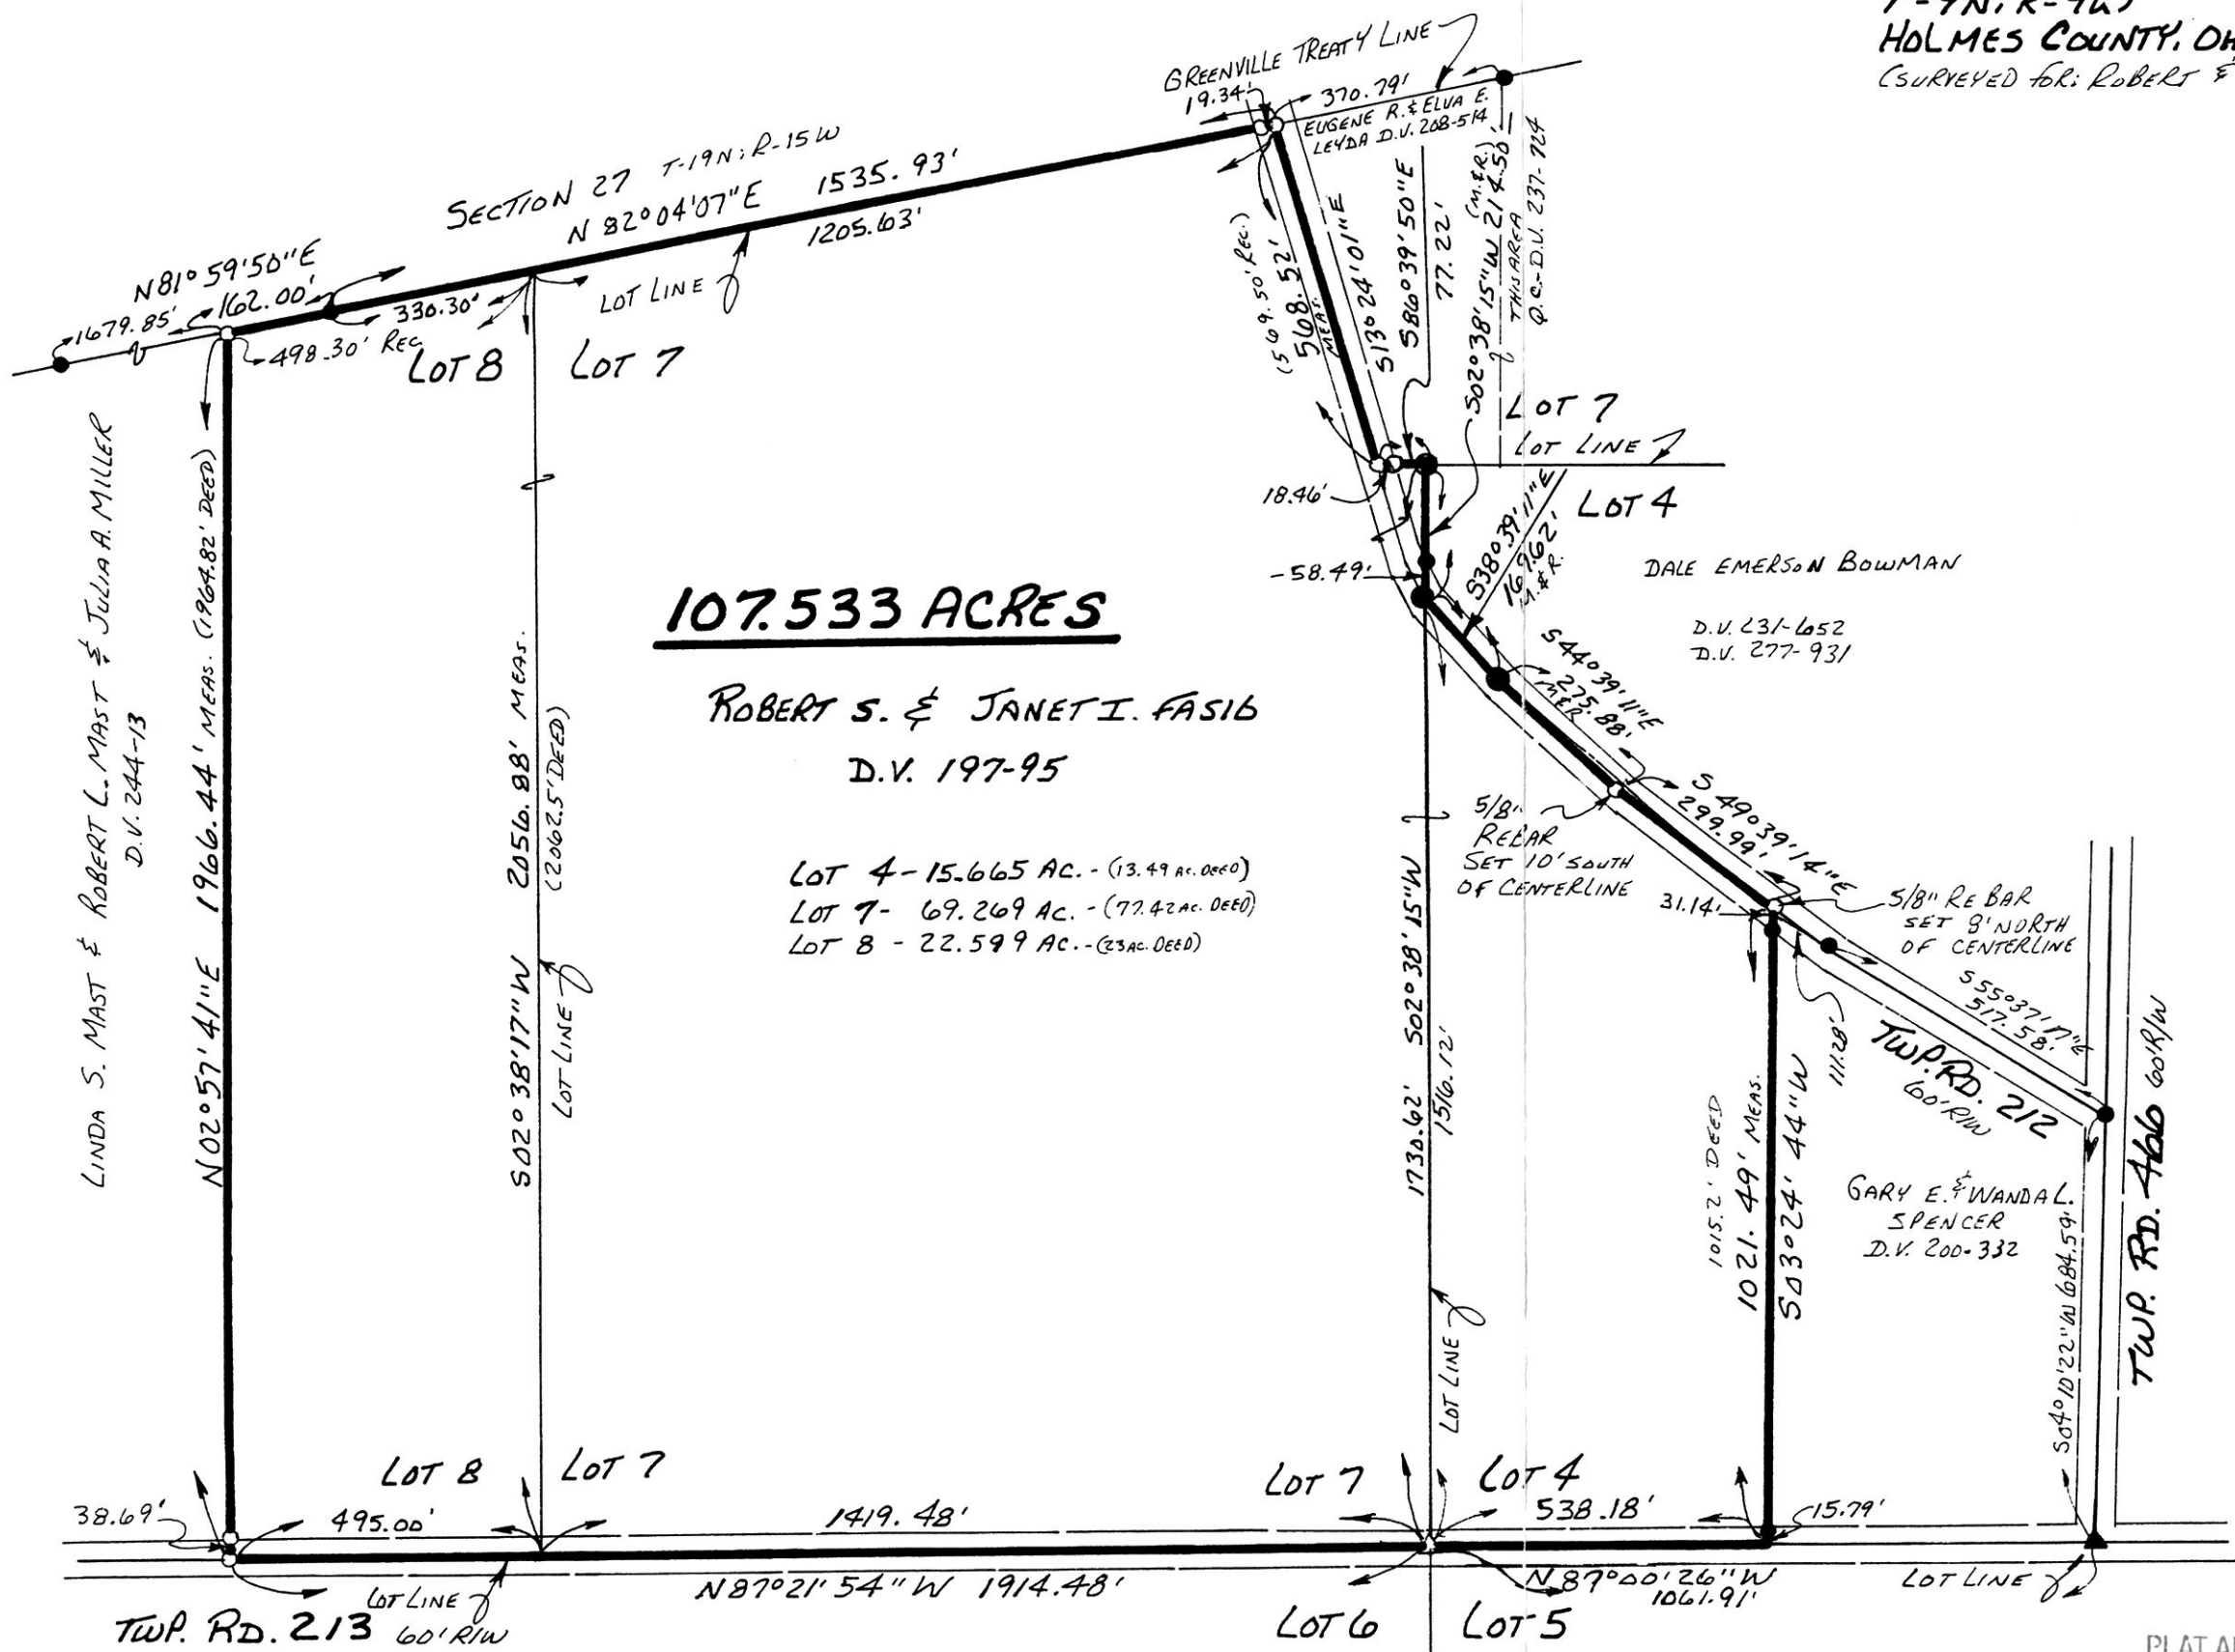

VOL 16 PAGE 695