


PLAT VOL. 5 PAGE 169

BEARINGS FROM  
 PLAT VOL. 15 PAGE 121


WASHINGTON TOWNSHIP  
 S.W. QTR. SECTION 2  
 T-19N; R-15W  
 HOLMES COUNTY, OHIO  
 (SURVEYED FOR: WILLARD & JEFFREY HOPKINS)

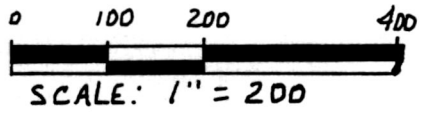

- 1 ROD PIN FOUND
- 5/8" REBAR WITH I.D. CAP SET  
 I.D. CAP MARKED "BAKER 6938"

9800002100  
 Filed for Record in  
 HOLMES COUNTY, OH  
 SALLY MILLER  
 On 05-08-1998 At 03:01 PM.  
 SMALL PLAT 20.00  
 Book OR Vol. 16 Pg. 717 - 717  
 OR Vol. 8 pg 607

INDEXED

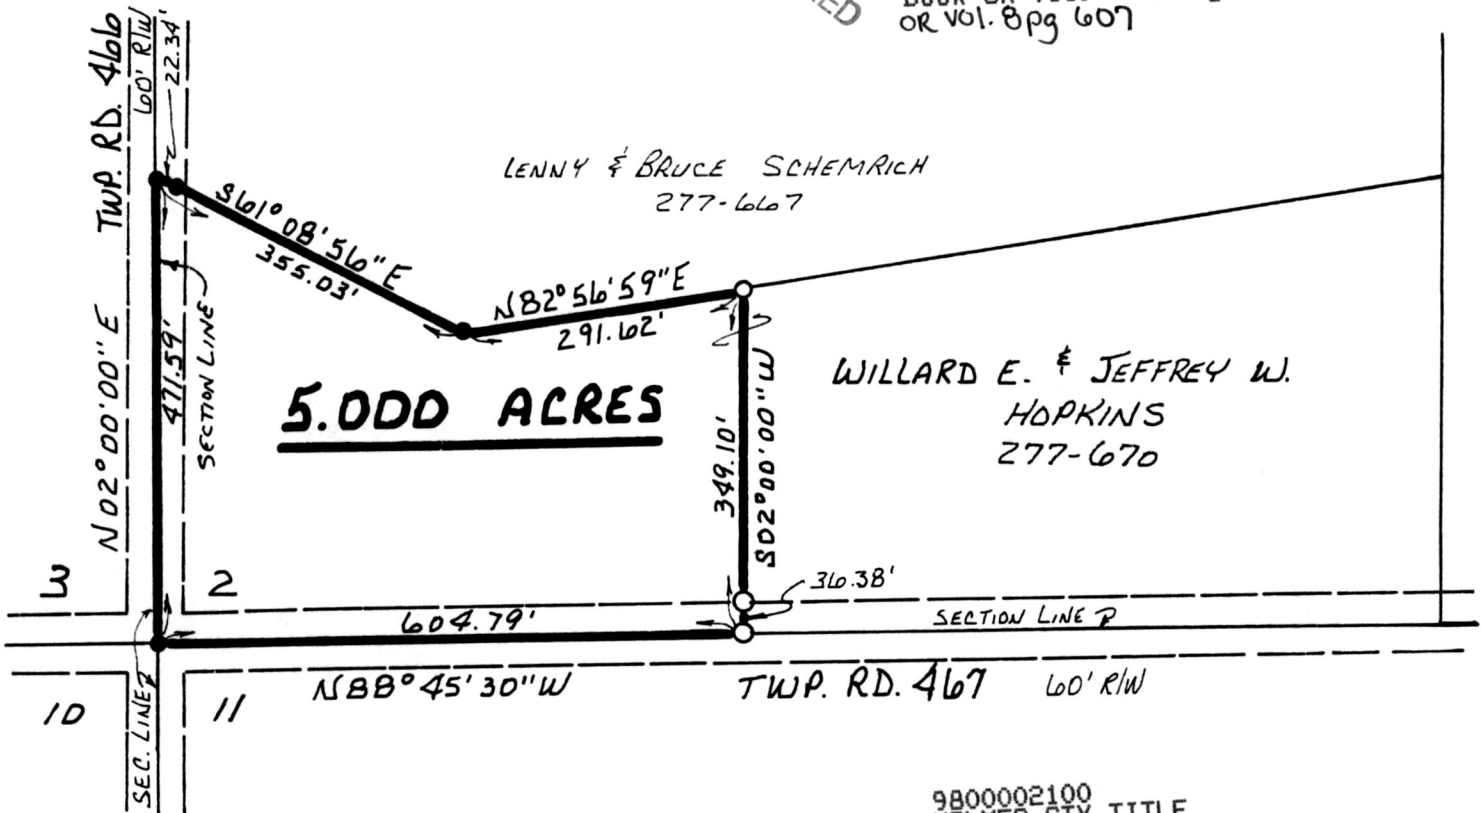

9800002100  
 HOLMES CTY TITLE  
 MILLERSBURG,

I CERTIFY THIS SURVEY TO BE CORRECT  
 TO THE BEST OF MY KNOWLEDGE.

Donald C. Baker  
 DONALD C. BAKER P.S. 6938  
 138 N. CLAY ST.  
 MILLERSBURG, OHIO 44654  
 PH. (330) 674-4788  
 AUGUST 29, 1997  
 47797-SRU F.C.C.-J.D. DARR



PLAT APPROVED

4/14/98-B