


**KNOX TOWNSHIP
N.E. QTR. SECTION 19
T-17N; R-14W
HOLMES COUNTY, OHIO**

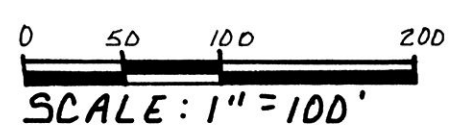


● IRON PIN FOUND
○ 5/8" REBAR WITH I.D. CAP SET
I.D. CAP MARKED "BAKER 6938"

SURVEYED FOR WAYNE LEININGER

9800002960
Filed for Record in
HOLMES COUNTY, OH
SALLY MILLER
On 06-29-1998 At 11:15 am.
SMALL PLAT 20.00
Book OR Vol. 16 Pg. 761 - 761
OR Vol. 11 pg 511

INDEXED

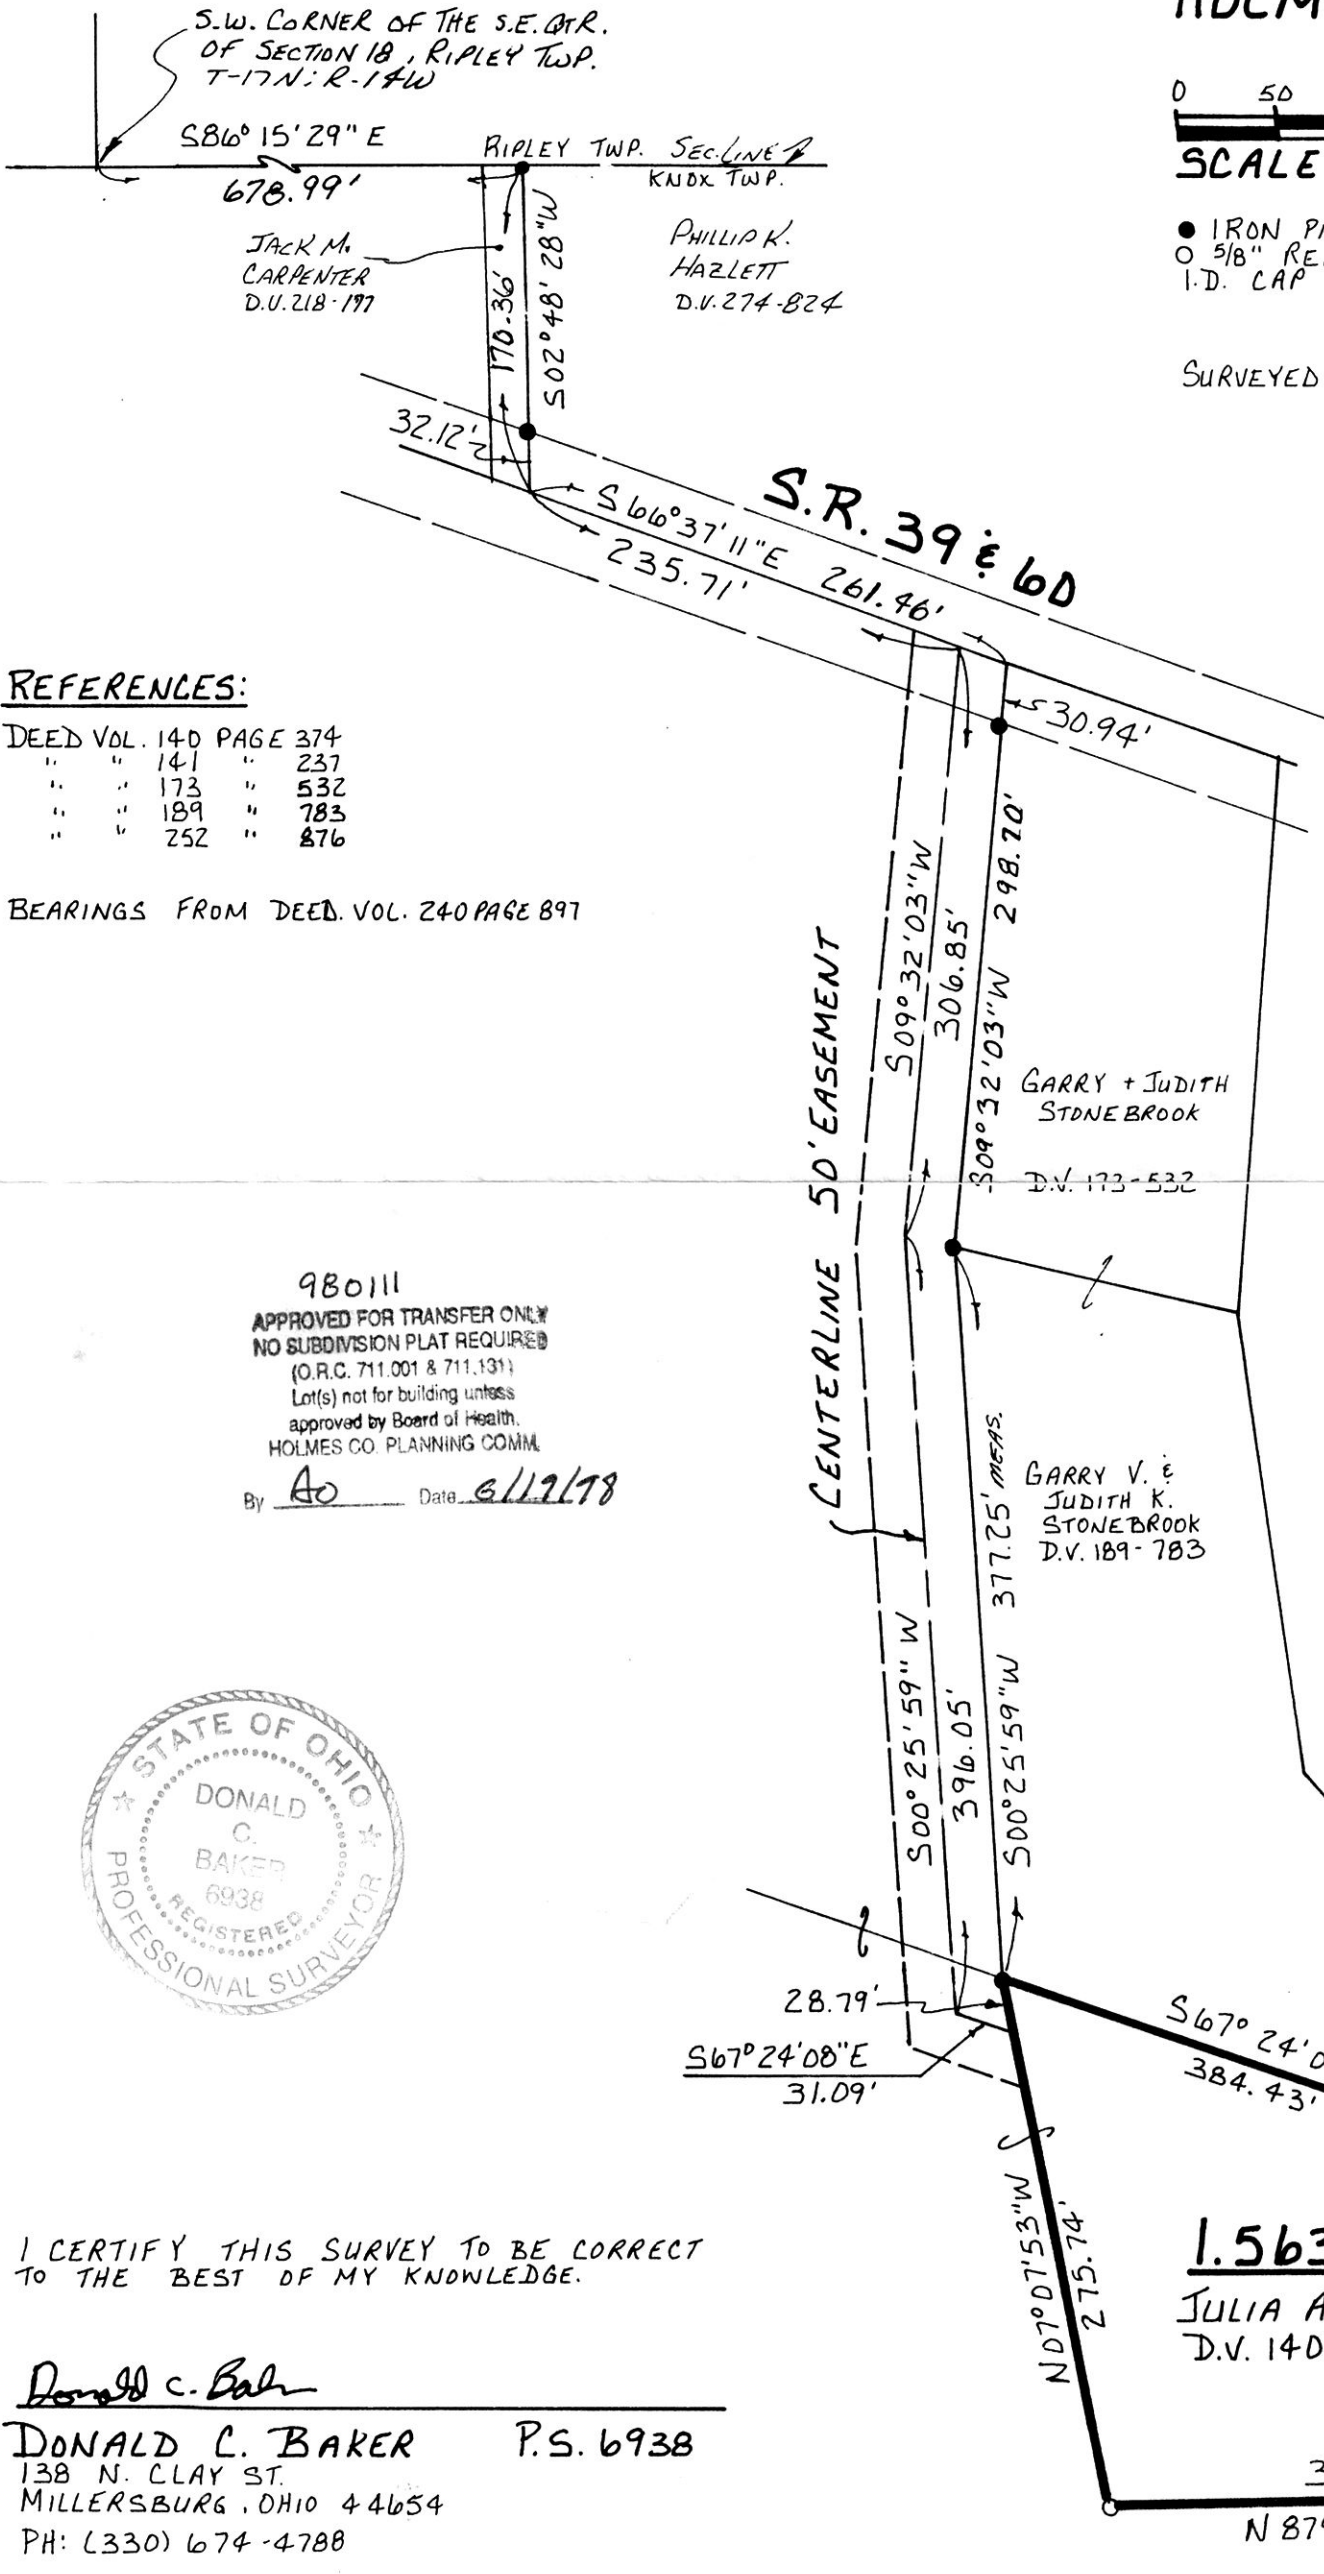

REFERENCES:

DEED VOL. 140	PAGE 374
" "	141 " 237
" "	173 " 532
" "	189 " 783
" "	252 " 876

BEARINGS FROM DEED, VOL. 240 PAGE 897

980111
APPROVED FOR TRANSFER ONLY
NO SUBDIVISION PLAT REQUIRED
(O.R.C. 711.001 & 711.131)
Lot(s) not for building unless
approved by Board of Health.
HOLMES CO. PLANNING COMM.
By AO Date 6/12/98



9800002960
MARK LEININGER ATTY
MILLERSBURG,

I CERTIFY THIS SURVEY TO BE CORRECT
TO THE BEST OF MY KNOWLEDGE.

Donald C. Baker
DONALD C. BAKER P.S. 6938
138 N. CLAY ST.
MILLERSBURG, OHIO 44654
PH: (330) 674-4788

JUNE 2, 1998
39398 - FJM
F.C.C. - J.D. DARR

1.563 ACRES
JULIA ANN SHANK
D.V. 140-374 D.V. 141-237
140.69'
S03°01'40"W
JAMES A. & AMY E. MARTIN
D.V. 252-876

PLAT APPROVED
6/22/98