


KILLBUCK TOWNSHIP  
 N.W. QTR. SECTION 19  
 T-8N; R-8W  
 HOLMES COUNTY, OHIO

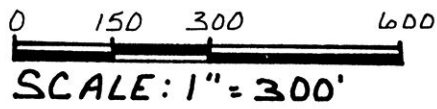

- ▲ RR. SPIKE FOUND
- IRON PIN FOUND
- 5/8" REBAR WITH I.D. CAPSET  
I.D. CAP MARKED "BAKER 6938"

REFERENCES:


DEED VOL. 169 PAGE 520  
 " " 214 " 427  
 " " 231 " 747

BEARINGS FROM PLAT VOL. 14 PAGE 37

SURVEYED FOR GARY MASTERS

9800003362  
 Filed for Record in  
 HOLMES COUNTY, OH  
 SALLY MILLER  
 On 07-17-1998 At 03:46 PM.  
 SMALL PLAT 20.00  
 Book OR Vol. 16 Pg. 798 - 798  
 OR VOL. 12 pg 899

INDEXED

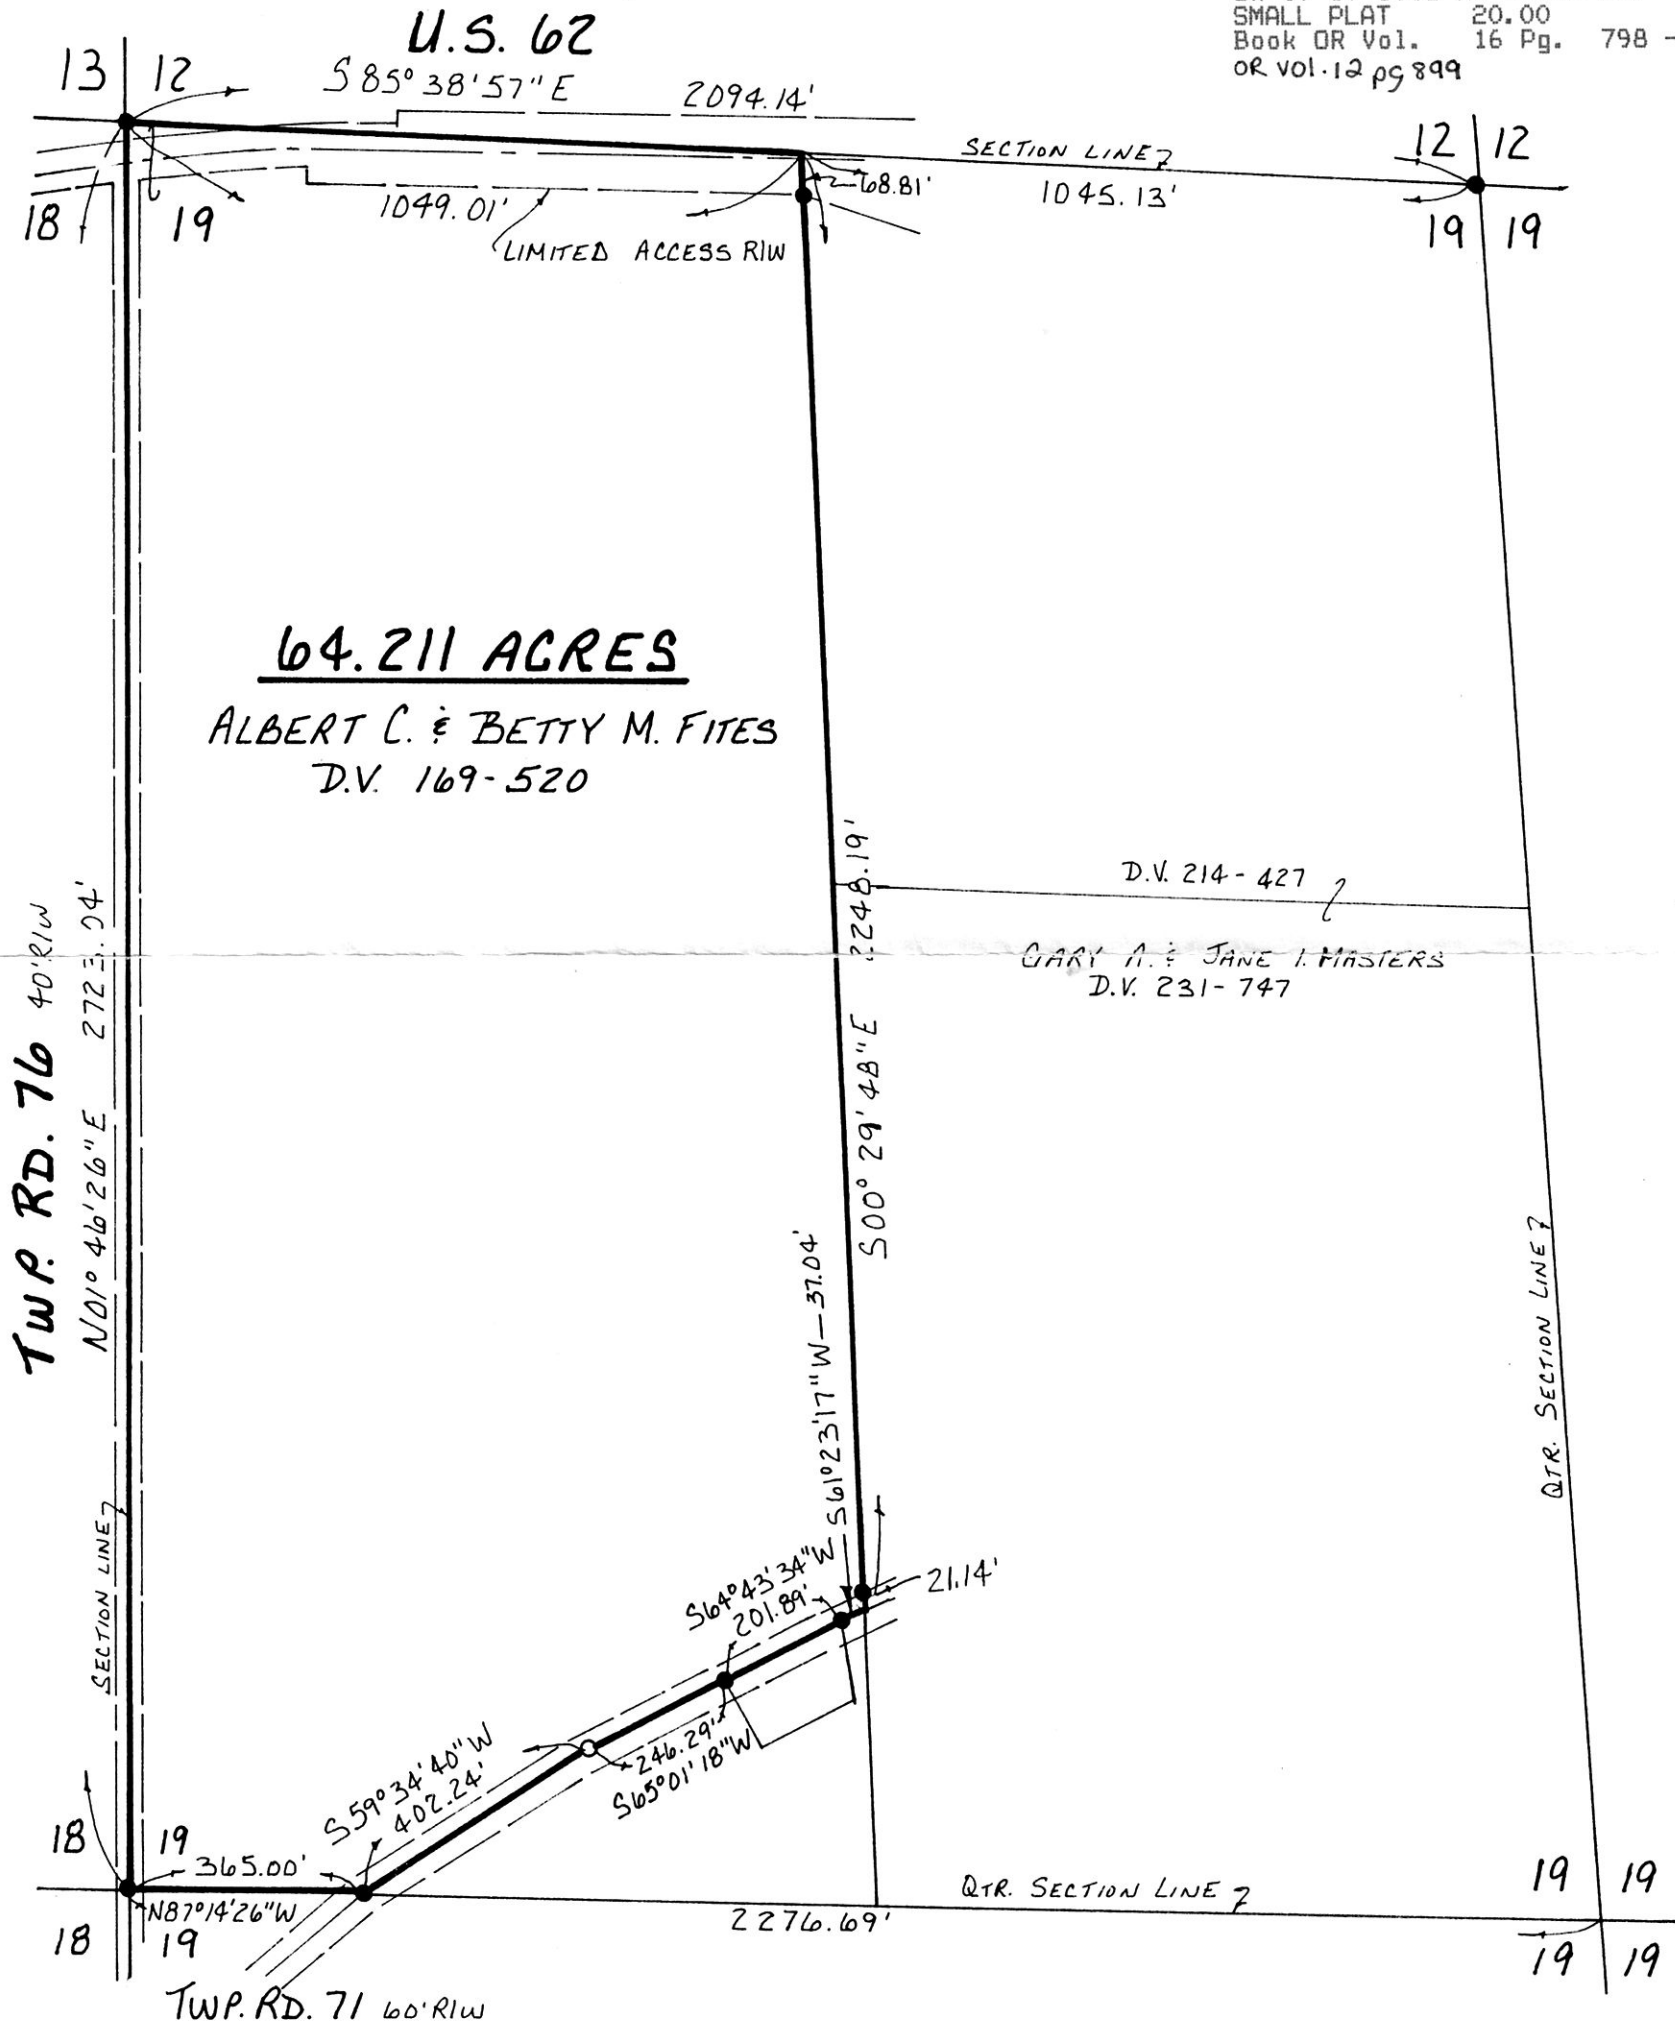

64.211 ACRES  
 ALBERT C. & BETTY M. FITES  
 D.V. 169-520

D.V. 214-427  
 GARY A. & JANE I. MASTERS  
 D.V. 231-747

9800003362  
 MILLER & MAST ATTYS  
 MILLERSBURG,



I CERTIFY THIS SURVEY TO BE CORRECT TO THE BEST OF MY KNOWLEDGE.

*Donald C. Baker*

**DONALD C. BAKER P.S. 6938**  
 138 N. CLAY ST.  
 MILLERSBURG, OHIO 44654  
 PH: (330) 674-4788

PLAT APPROVED

7/17/98 b

JULY 1, 1998

#48398-FJM  
 F.C.C.-F.D. BAKER