


WALNUT CREEK TOWNSHIP
S.W. QTR. SECTION 11
T-9N; R-5W
HOLMES COUNTY, OHIO

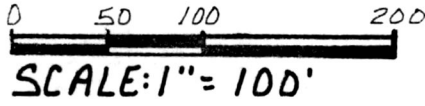

- ▲ R.R. SPIKE FOUND
- IRON PIN FOUND
- 5/8" REBAR WITH I.D. CAP SET
I.D. CAP MARKED "BAKER 6938"

REFERENCES:

DEED VOL. 273 PAGE 996
 " " 271 " 231
 " " 243 " 541


SURVEYED FOR ATLEE MILLER

RESURVEY OF DEED VOL. 273 PAGE 996

JONAS U. &
 EFFIE
 BURKHOLDER
 D.V. 271-231

1.000
ACRES

ATLEE J. &
 MIRIAM
 MILLER
 D.V. 273-996

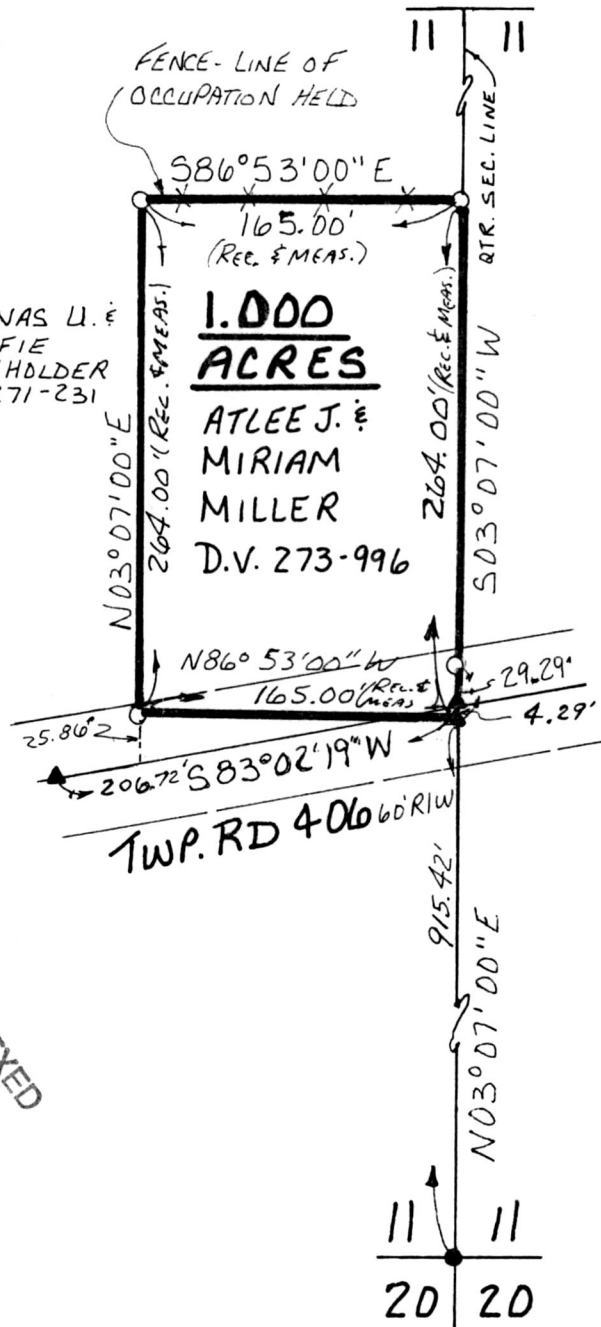

9800003915
 Filed for Record in
 HOLMES COUNTY, OH
 SALLY MILLER
 On 08-18-1998 At 03:24 PM.
 SMALL PLAT 20.00
 Book OR Vol. 16 Pg. 829 - 829
 OR vol. 14 pg 916

INDEXED



PLAT APPROVED

8/17/98.B

9800003915
 LAUREL SCHMID ATTY
 MILLERSBURG,

I CERTIFY THIS SURVEY TO BE CORRECT TO THE BEST OF MY KNOWLEDGE.

Donald C. Baker

DONALD C. BAKER P.S. 6938
 138 N. CLAY ST.
 MILLERSBURG, OHIO 44654
 PH: (330) 674-4788

AUGUST 5, 1998

56398-FJM
 F.C.C. - F.D. BAKER