HARDY TOWNSHIP
S.E. QTR. SECTION 21
T-9N ; R-7W
HOLMES COUNTY. OHIO

REFERENCES:

DEED VOL. 117 PAGE 208
" " 196 " 507
" " 190 " 139

PLAT VOL. 6 PAGE 122

N

0 50 100 200
SCALE: 1" = 100'

● IRON PIN FOUND
▲ R.R. SPIKE FOUND
○ 5/8" REBAR WITH I.D. CAP SET
I.D. CAP MARKED "BAKER 6938"

SURVEYED FOR JIM MILLER

980201
APPROVED FOR TRANSFER ONLY
NO SUBDIVISION PLAT REQUIRED
(O.R.C. 711.001 & 711.131)
Lot(s) not for building unless
approved by Board of Health.
HOLMES CO. PLANNING COMM.
By AO Date 8/31/98

INDEXED

9800004170
Filed for Record in
HOLMES COUNTY , OH
SALLY MILLER
On 09-01-1998 At 02:36 PM.
SMALL PLAT 20.00
Book OR Vol. 16 Pg. 849 - 849
or vol 15 pg 792

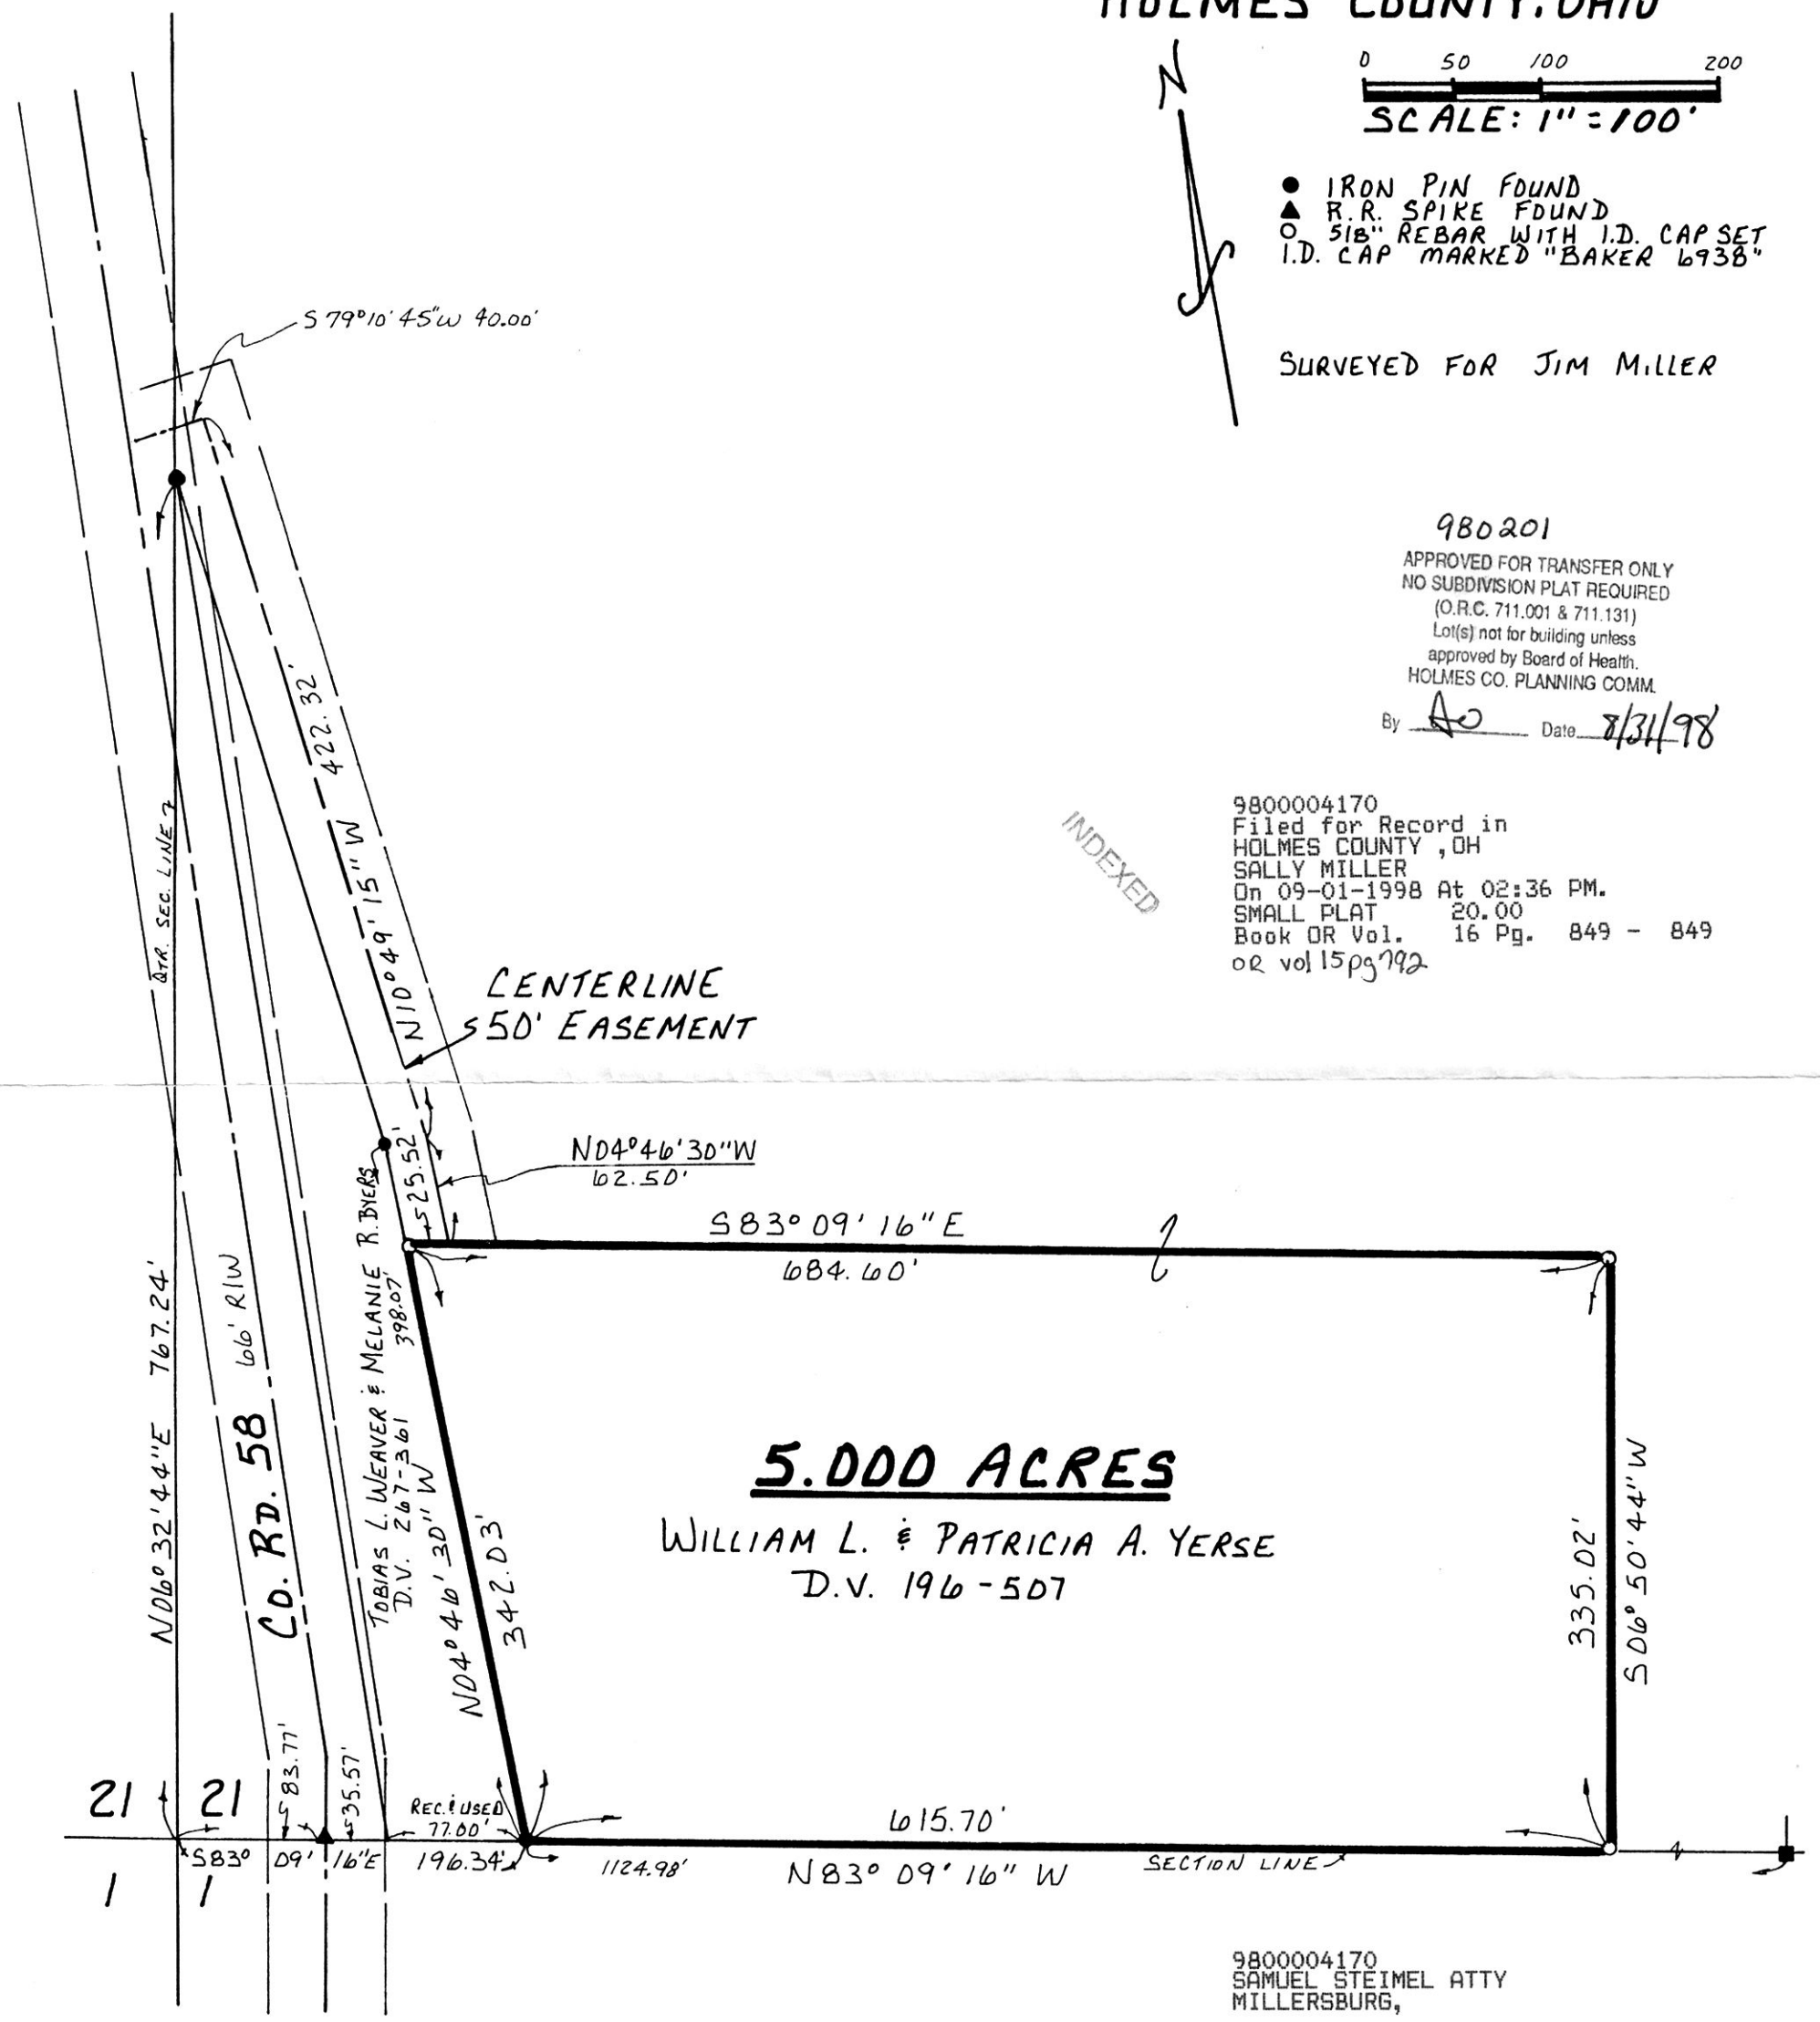

9800004170
SAMUEL STEIMEL ATTY
MILLERSBURG,

STATE OF OHIO
DONALD C. BAKER
6938
REGISTERED
PROFESSIONAL SURVEYOR

I CERTIFY THIS SURVEY TO BE CORRECT TO THE BEST OF MY KNOWLEDGE.

Donald C. Baker

DONALD C. BAKER P.S. 6938
138 N. CLAY ST.
MILLERSBURG , OHIO 44654
PH: (330) 674-4788
MARCH 19 , 1998

PLAT APPROVED
9/1/98

13998 - FJM
F.C.C. - F.D. BAKER