


HARDY TOWNSHIP
N.E. QTR. SEC. 6
T-9N R-6W
HOLMES COUNTY, OHIO


INDEXED

9800004304
Filed for Record in
HOLMES COUNTY, OH
SALLY MILLER
On 09-09-1998 At 02:32 pm.
SMALL PLAT 20.00
Book OR Vol. 16 Pg. 855 - 855
OR vol. 16 pg 237

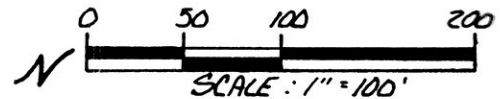

- STONE FOUND
- △ R.R. SPIKE SET
- 5/8" REBAR WITH I.D. CAP SET
I.D. CAP MARKED "BAKER 6938"


BEARINGS FROM PLAT Vol. 8
PAGE 878

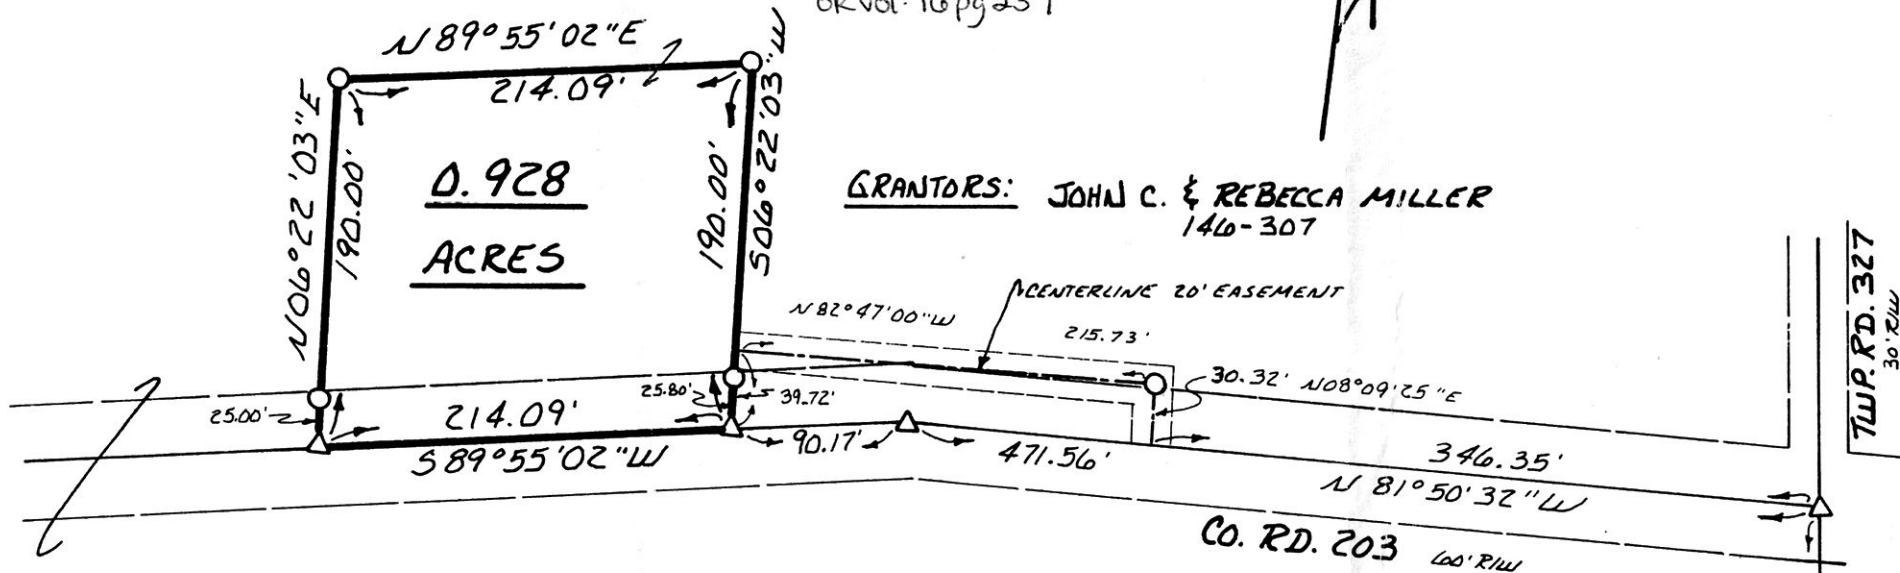

GRANTORS: JOHN C. & REBECCA MILLER
146-307

I CERTIFY THIS SURVEY TO BE CORRECT
TO THE BEST OF MY KNOWLEDGE.

Donald C. Baker
DONALD C. BAKER P.S. 6938
4321 T.R. 252
GLENMONT, OHIO 44628

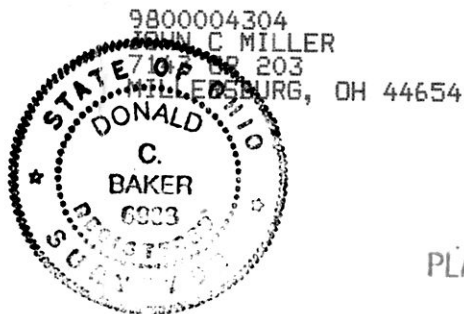

980206
APPROVED FOR TRANSFER ONLY
NO SUBDIVISION PLAT REQUIRED
(O.R.C. 711.001 & 711.131)
Lot(s) not for building unless
approved by Board of Health.
HOLMES CO. PLANNING COMM.

By Do Date 9/9/98

PLAT APPROVED
9/9/98

OCT. 3, 1990
1338-MS

6 7
6 7