


PRAIRIE TOWNSHIP  
 N.W. QTR. SECTION 3  
 T-13 R-13W  
 HOLMES COUNTY, OHIO  
 (SURVEYED FOR: BANDS Co.)

INDEXED



9800004660  
 Filed for Record in  
 HOLMES COUNTY, OH  
 SALLY MILLER  
 On 09-30-1998 At 02:23 pm.  
 SMALL PLAT 20.00  
 Book OR Vol. 16 Pg. 872 - 872  
 or vol. 17 page 454

0 50 100 200

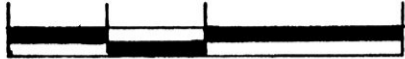

SCALE: 1" = 100'


- IRON PIN FOUND
- 5/8" RE BAR WITH I.D. CAP SET  
 I.D. CAP MARKED "BAKER 6938"

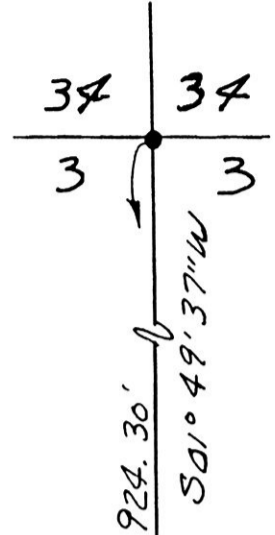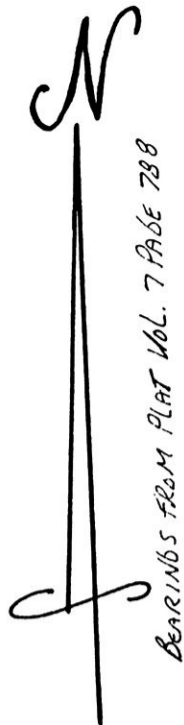

REFERENCES:

DEED VOL. 266 PAGE 711  
 " " 267 " 772

PLAT VOL. 7 PAGE 788  
 " " 14 " 752  
 " " 6 " 113

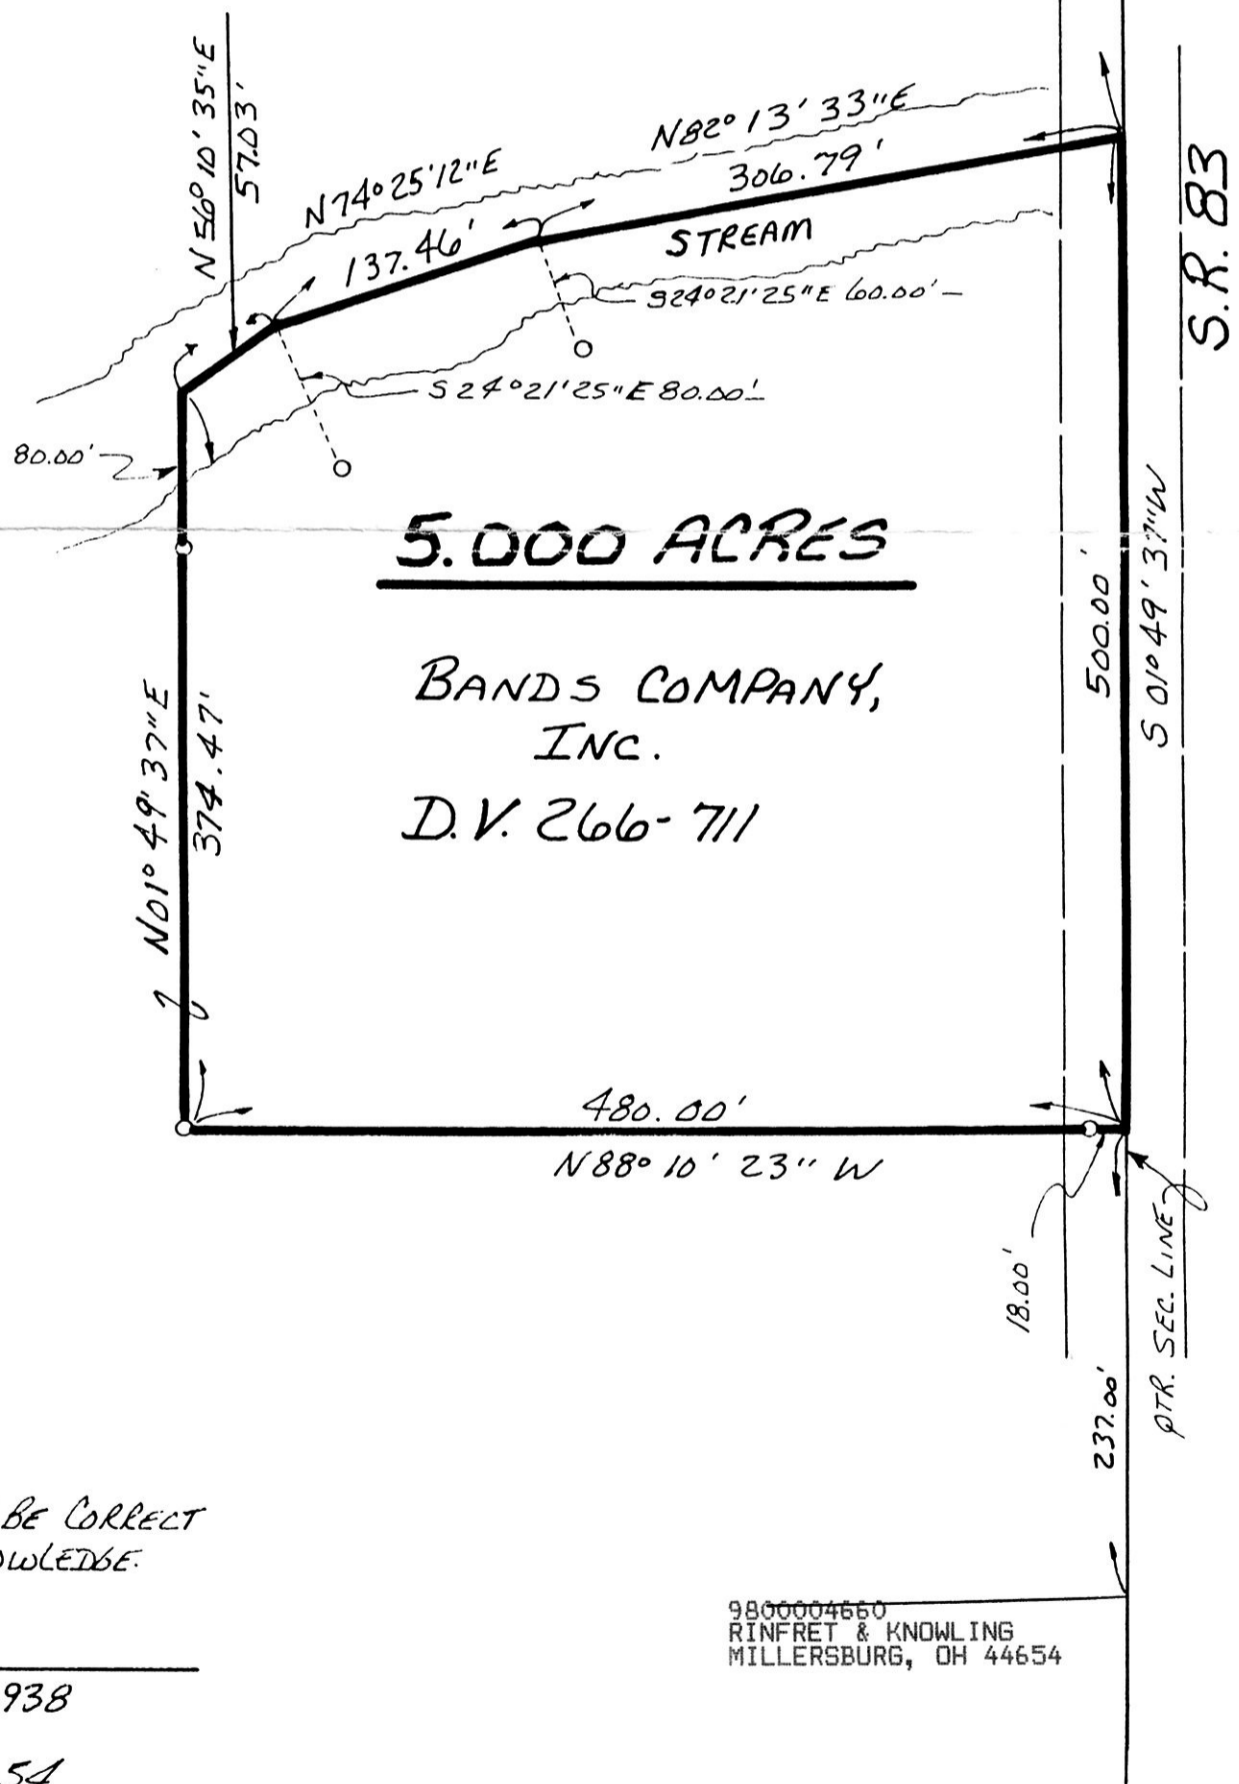

I CERTIFY THIS SURVEY TO BE CORRECT  
 TO THE BEST OF MY KNOWLEDGE.

Donald C. Baker  
 DONALD C. BAKER P.S. 6938  
 138 N. CLAY ST.  
 MILLERSBURG, OHIO 44654  
 PH. (330) 674-4788

SEPTEMBER 2, 1998

# 61998 - M.L. DAVIS  
 F.C.C. - D.C. BAKER

9800004660  
 RINFRET & KNOWLING  
 MILLERSBURG, OH 44654

PLAT APPROVED

9/18/98-b